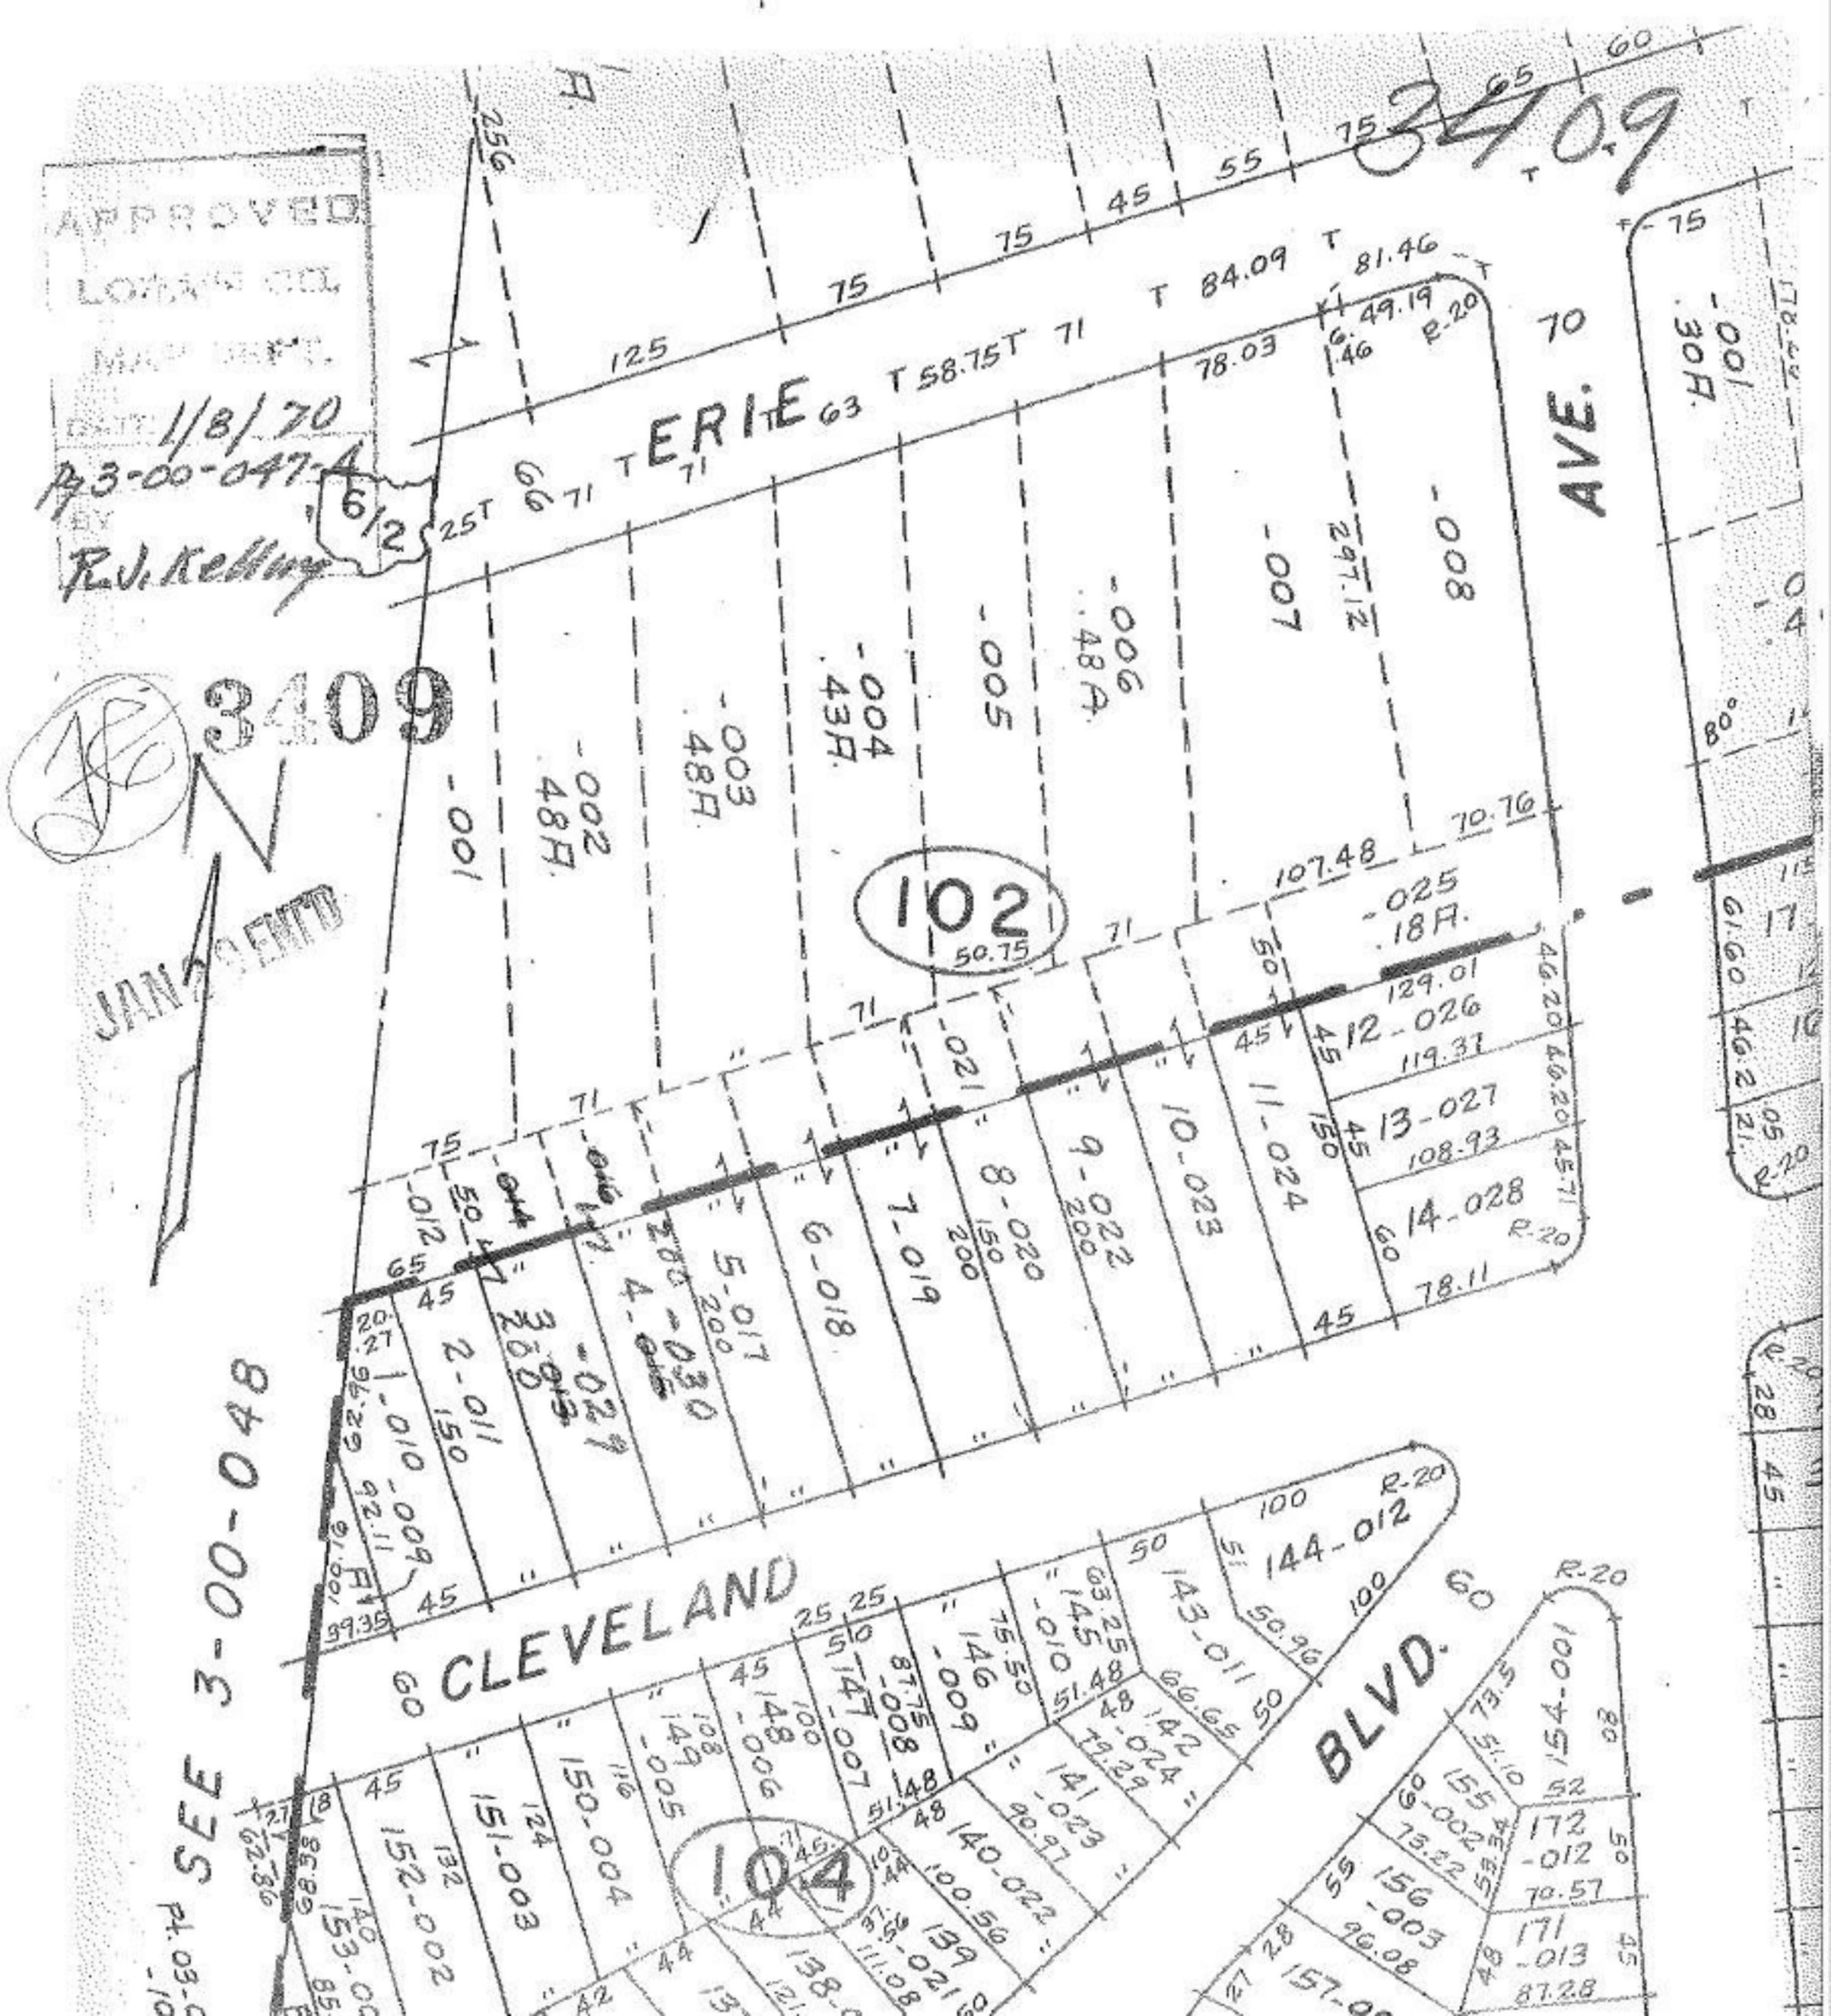

APPROVED
LOWER COL.
MAP DEPT.
DATE 1/8/70
Pg 3-00-047-A
BY
R.J. Kelling
3409
N
JAN 29 ENTD
ERIE
AVE.
CLEVELAND
BLVD.
SEE 3-00-048
102
104