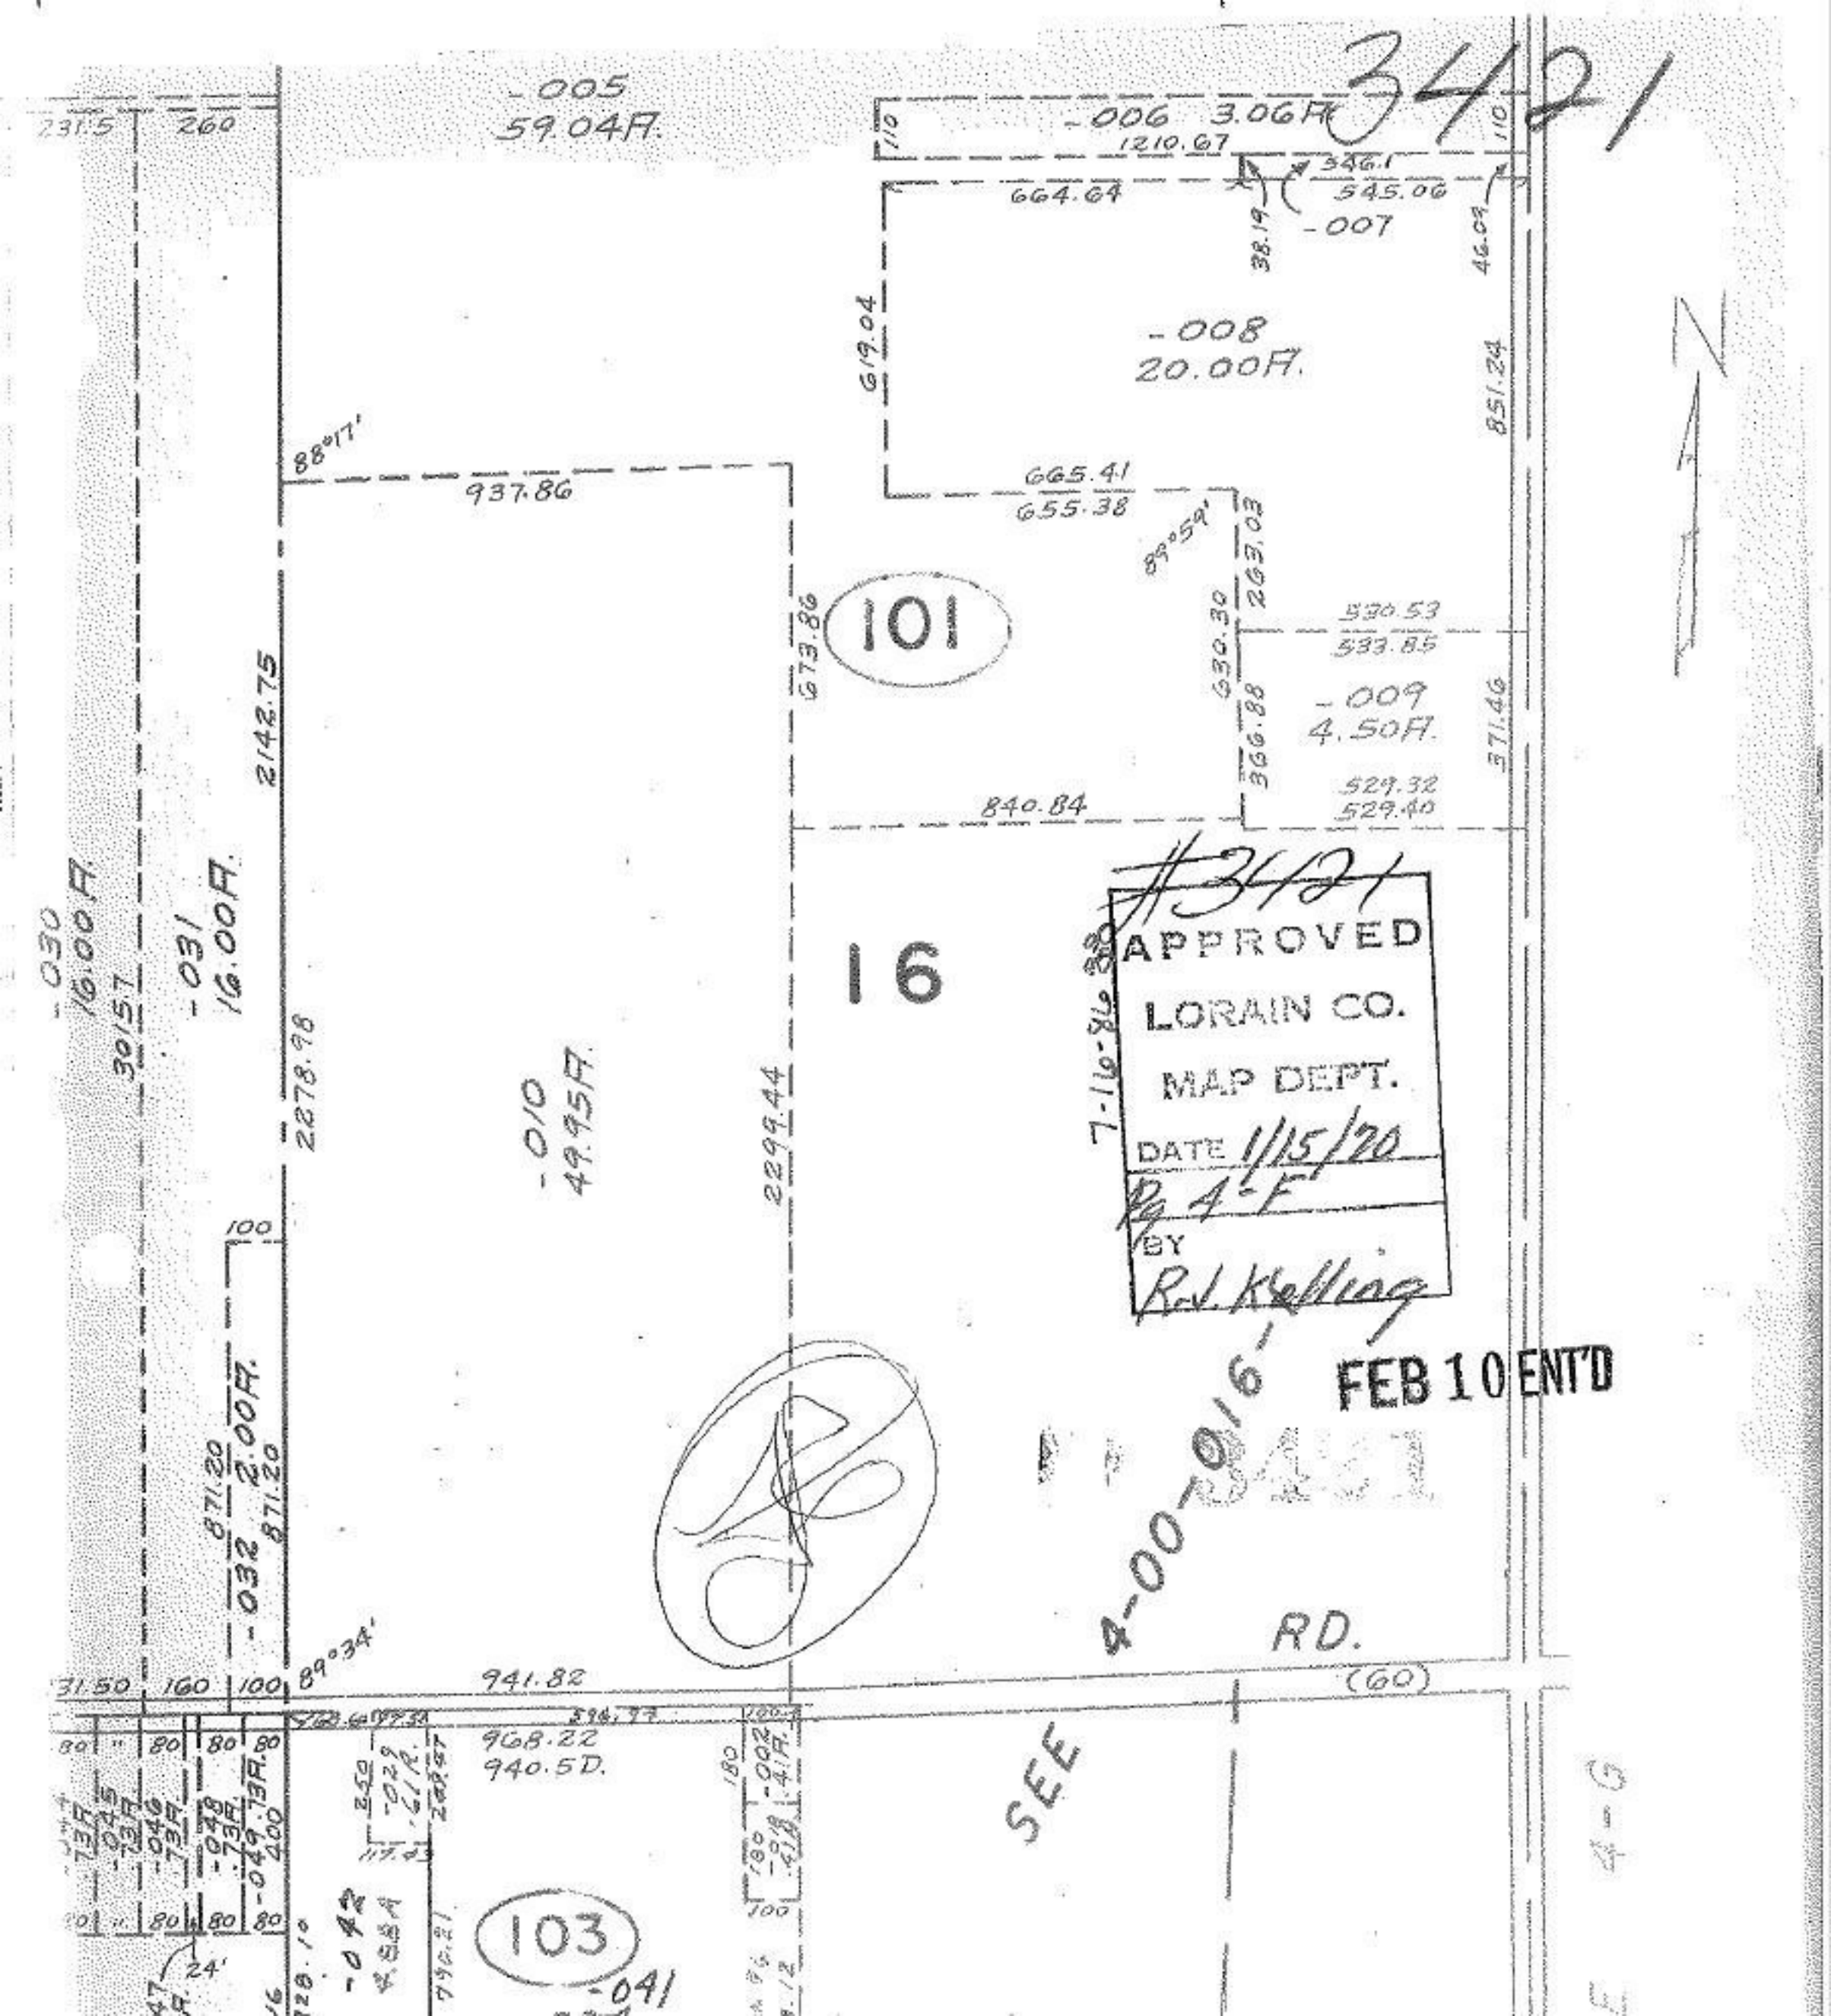
3421
-005
59.04A.
-006 3.06A
1210.67
664.64
546.1
545.06
-007
38.19
46.09
-008
20.00A.
619.04
851.24
88°17'
937.86
665.41
655.38
89°59'
263.03
101
673.86
630.30
530.53
533.85
-009
4.50A.
366.88
371.46
529.32
529.40
840.84
2142.75
16
-030
16.00A.
-031
16.00A.
2278.98
-010
49.95A.
2299.44
7-16-86
#3421
APPROVED
LORAIN CO.
MAP DEPT.
DATE 1/15/70
Pg 4-F
BY
R.J. Kelling
FEB 10 ENT'D
4-00-016
-032 2.00A.
871.20
89°34'
941.82
RD.
(60)
968.22
940.5D.
SEE
103
-041
24'
4-G