

8490

FEB 10 1970


APPROVED  
 LORAIN CO.  
 MAP DEPT.  
 DATE 1/22/70  
 7-00-005-B4D  
 BY R. Kelling



Copyright  
 7-00-005

3490

CUYAHOGA COUNTY

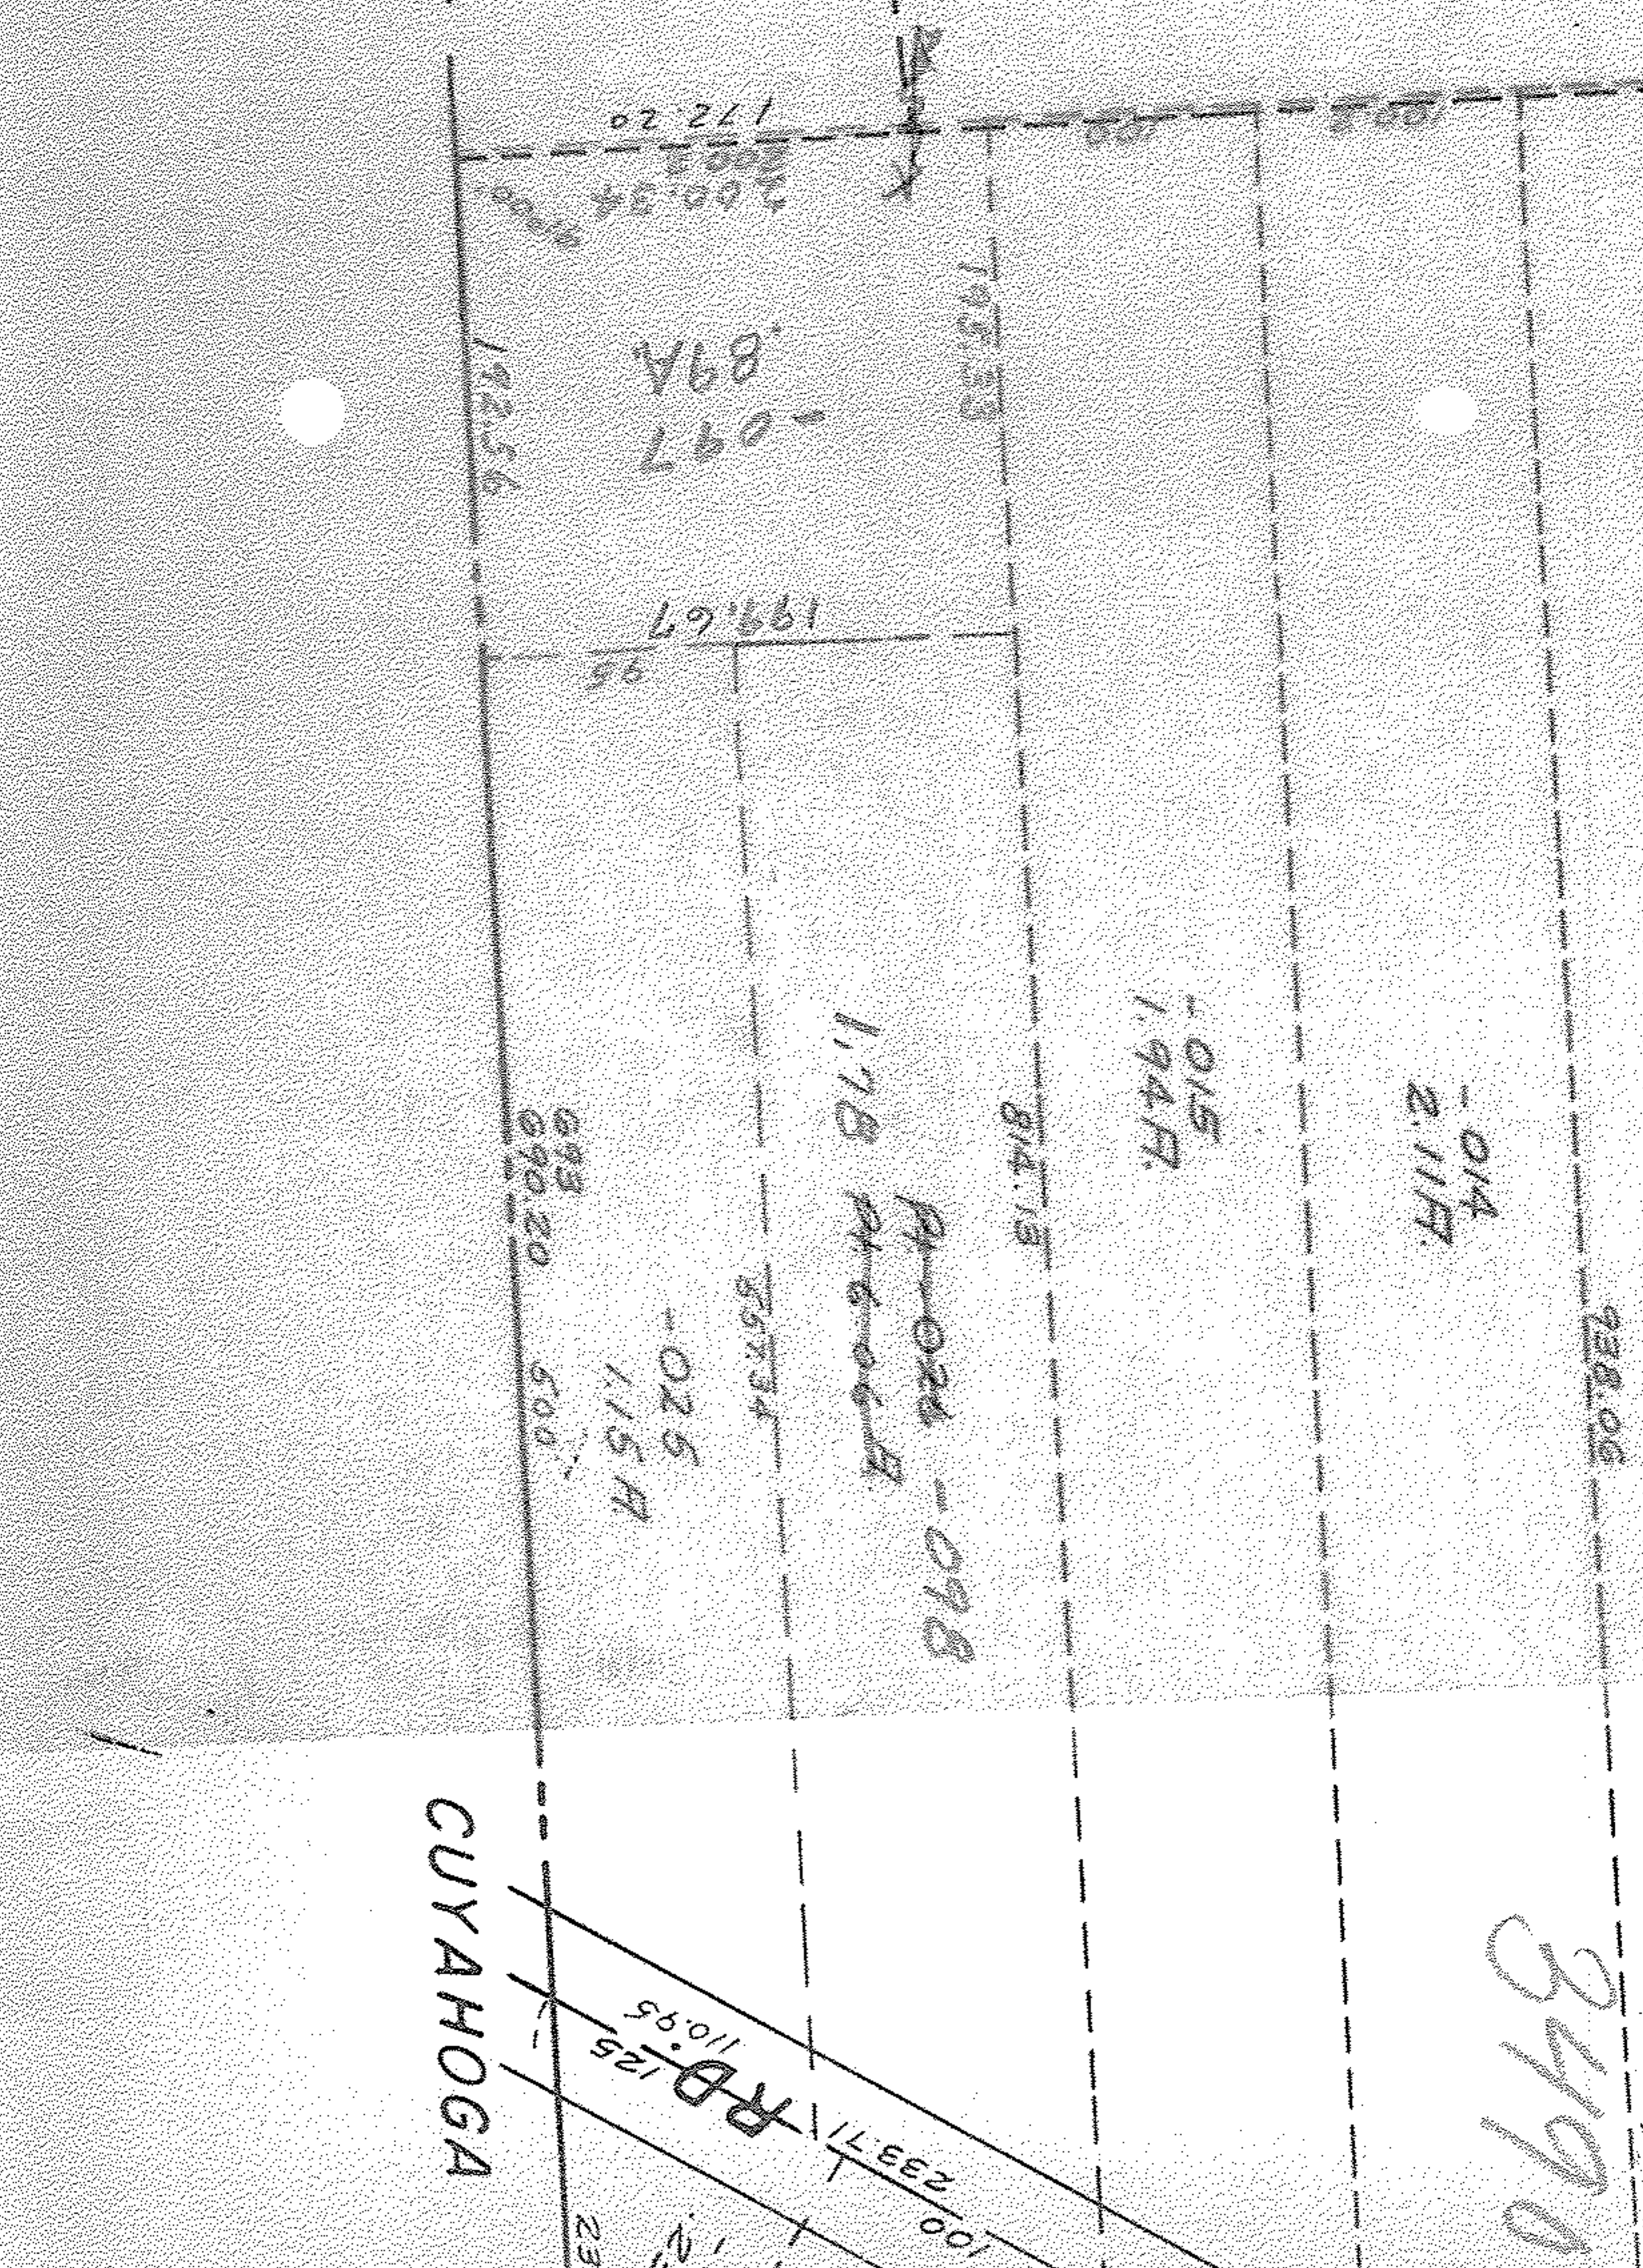

1721.94  
 1725.92  
 Pt 6-06A  
 3.39A  
 17.534  
 Pt 026 - 096

