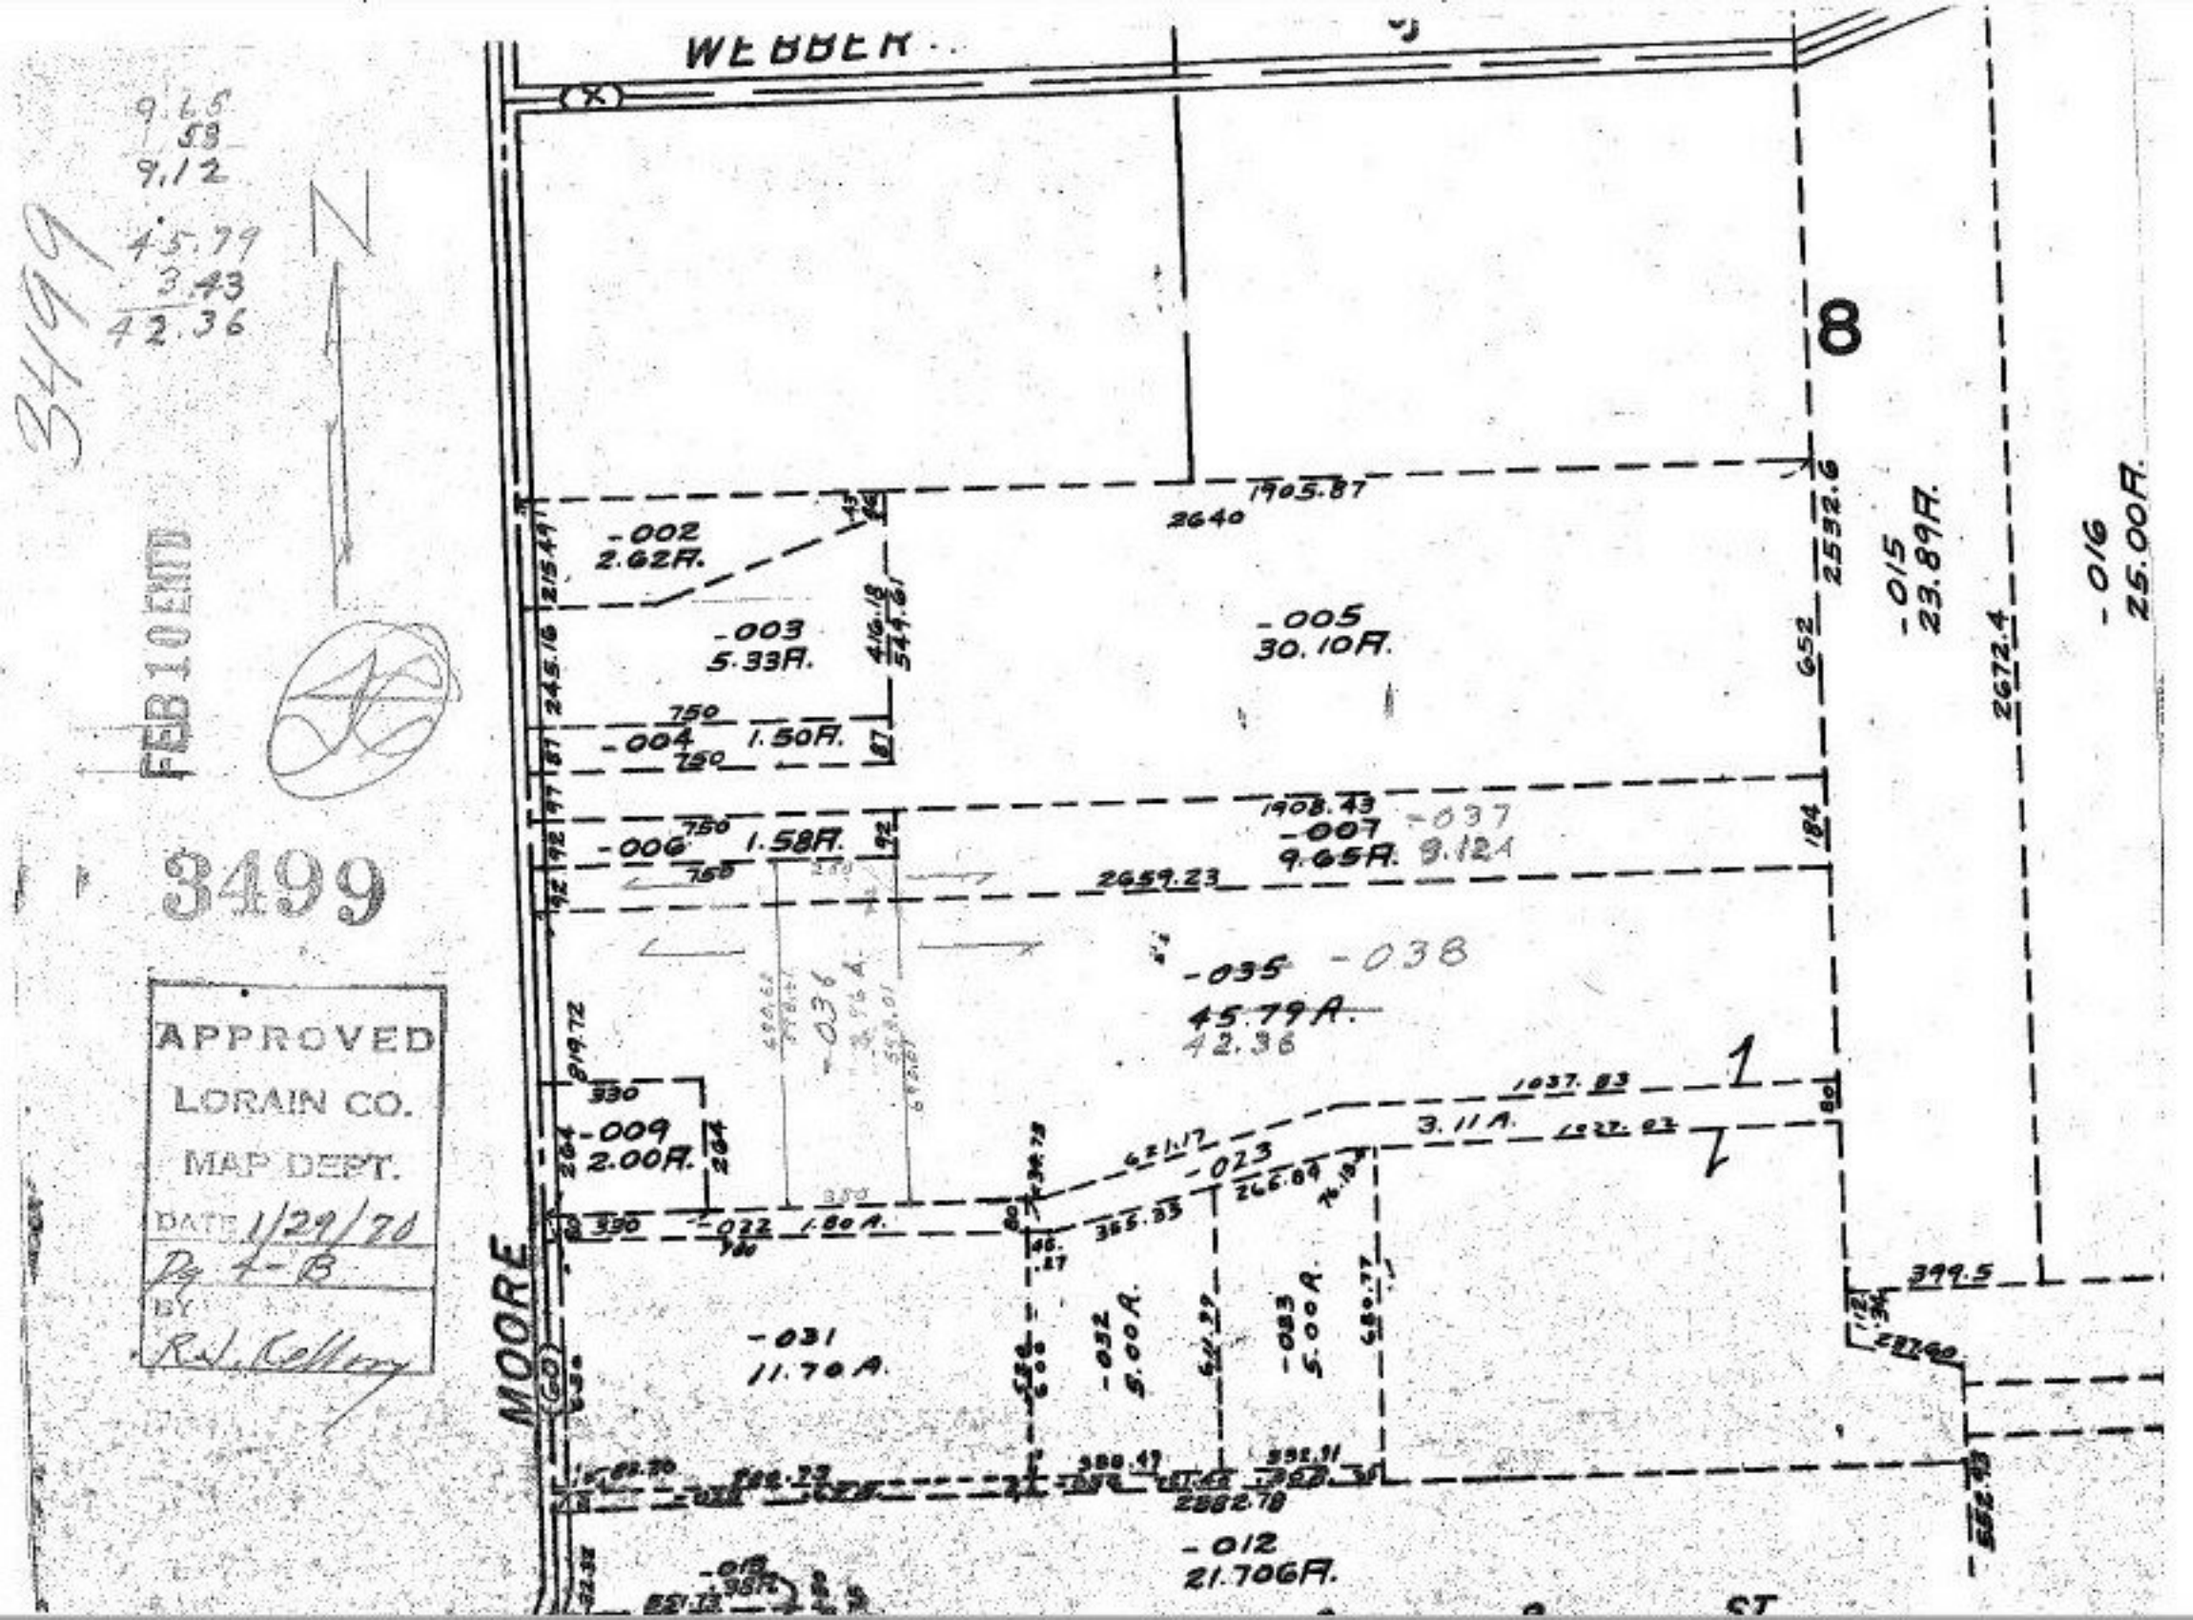
9.65
.58
9.12
45.79
3.43
42.36
3499
N
FEB 10 END
3499
APPROVED
LORAIN CO.
MAP DEPT.
DATE 1/29/70
By T-B
BY
R.L. Collins
WEBER
MOORE
(60)
8
1
-002
2.62A.
-003
5.33A.
-004
1.50A.
-005
30.10A.
-006
1.58A.
-007
9.65A.
9.12A
-009
2.00A.
-022
1.00A.
-023
3.11A.
-031
11.70A.
-032
5.00A.
-033
5.00A.
-035
45.79A.
42.36
-036
-037
-038
-012
21.70GA.
-015
23.89A.
-016
25.00A.
1905.87
2640
2532.6
2672.4
2659.23
1908.43
1037.83
399.5
2662.78