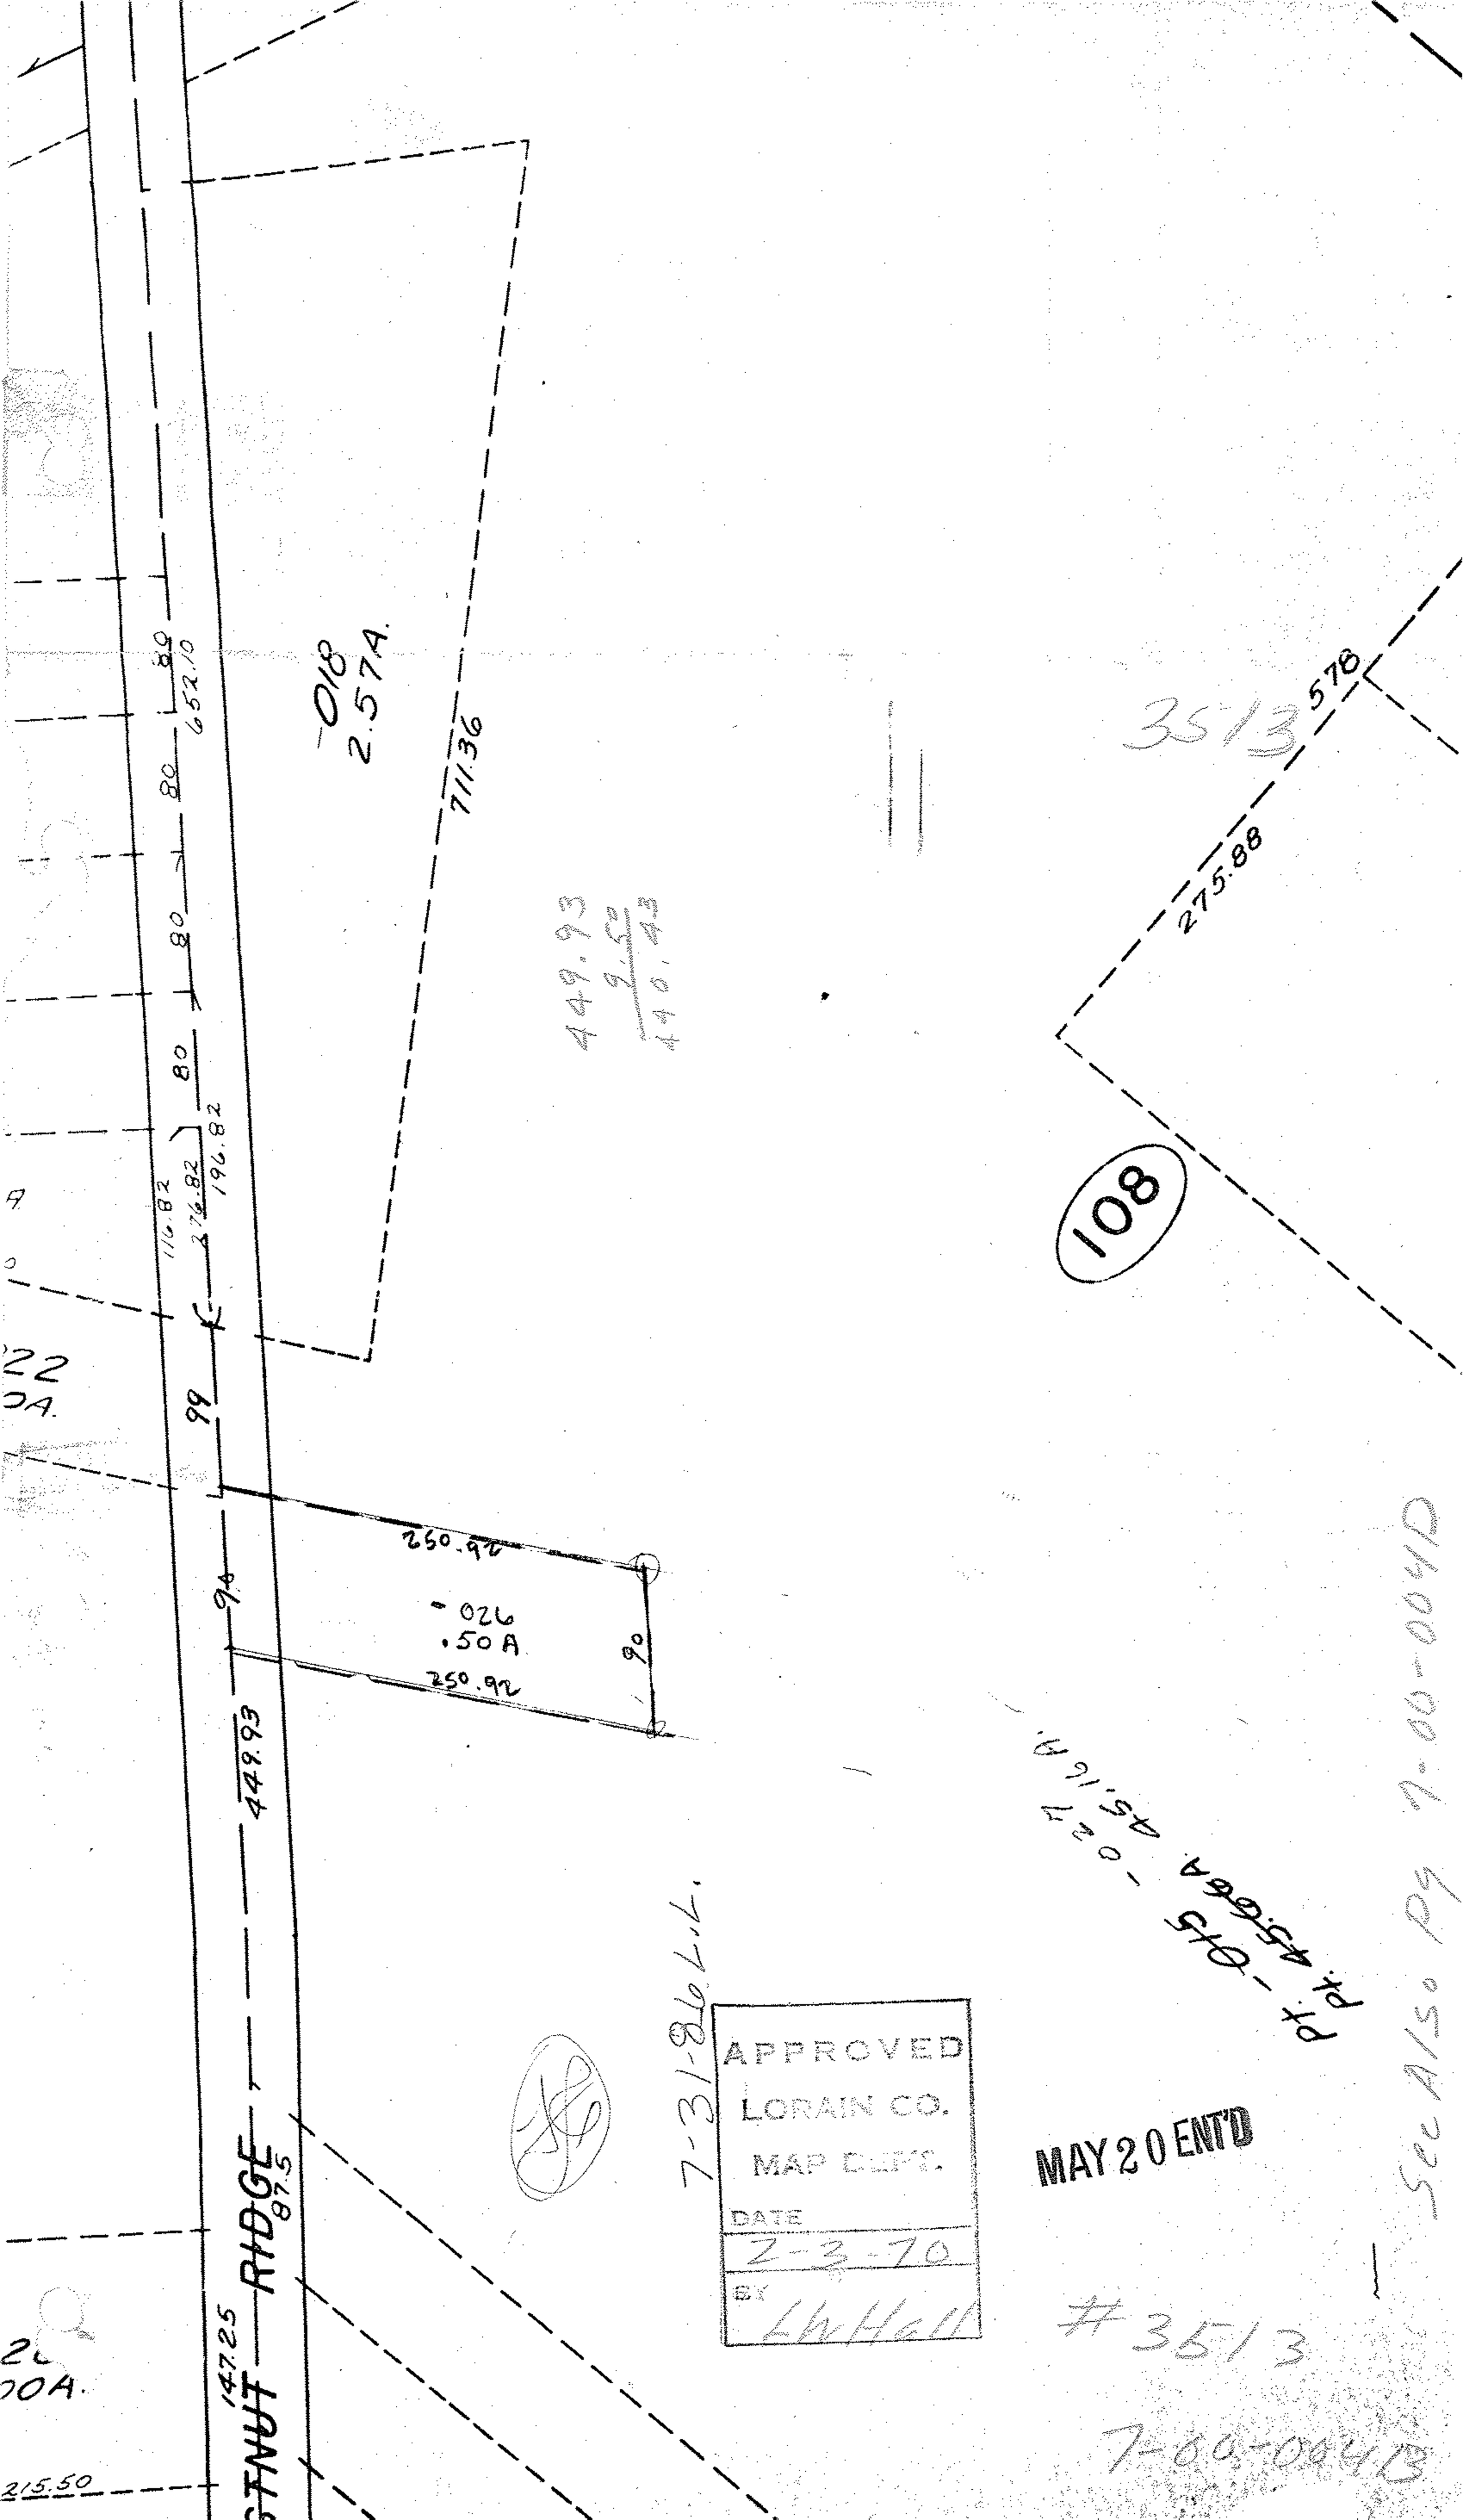

-018
2.57A.
711.36
3513
578
275.88
108
449.93
9.50
440.43
652.10
80
80
80
80
80
116.82
276.82
196.82
99
250.92
-026
.50A
250.92
90
90
449.93
147.25
87.5
RIDGE
215.50
7-31-86 L.L.
APPROVED
LORAIN CO.
MAP DEPT.
DATE
2-3-70
BY
LWHall
MAY 20 ENT'D
#3513
7-00-004B
See Also Pg 7-00-004D