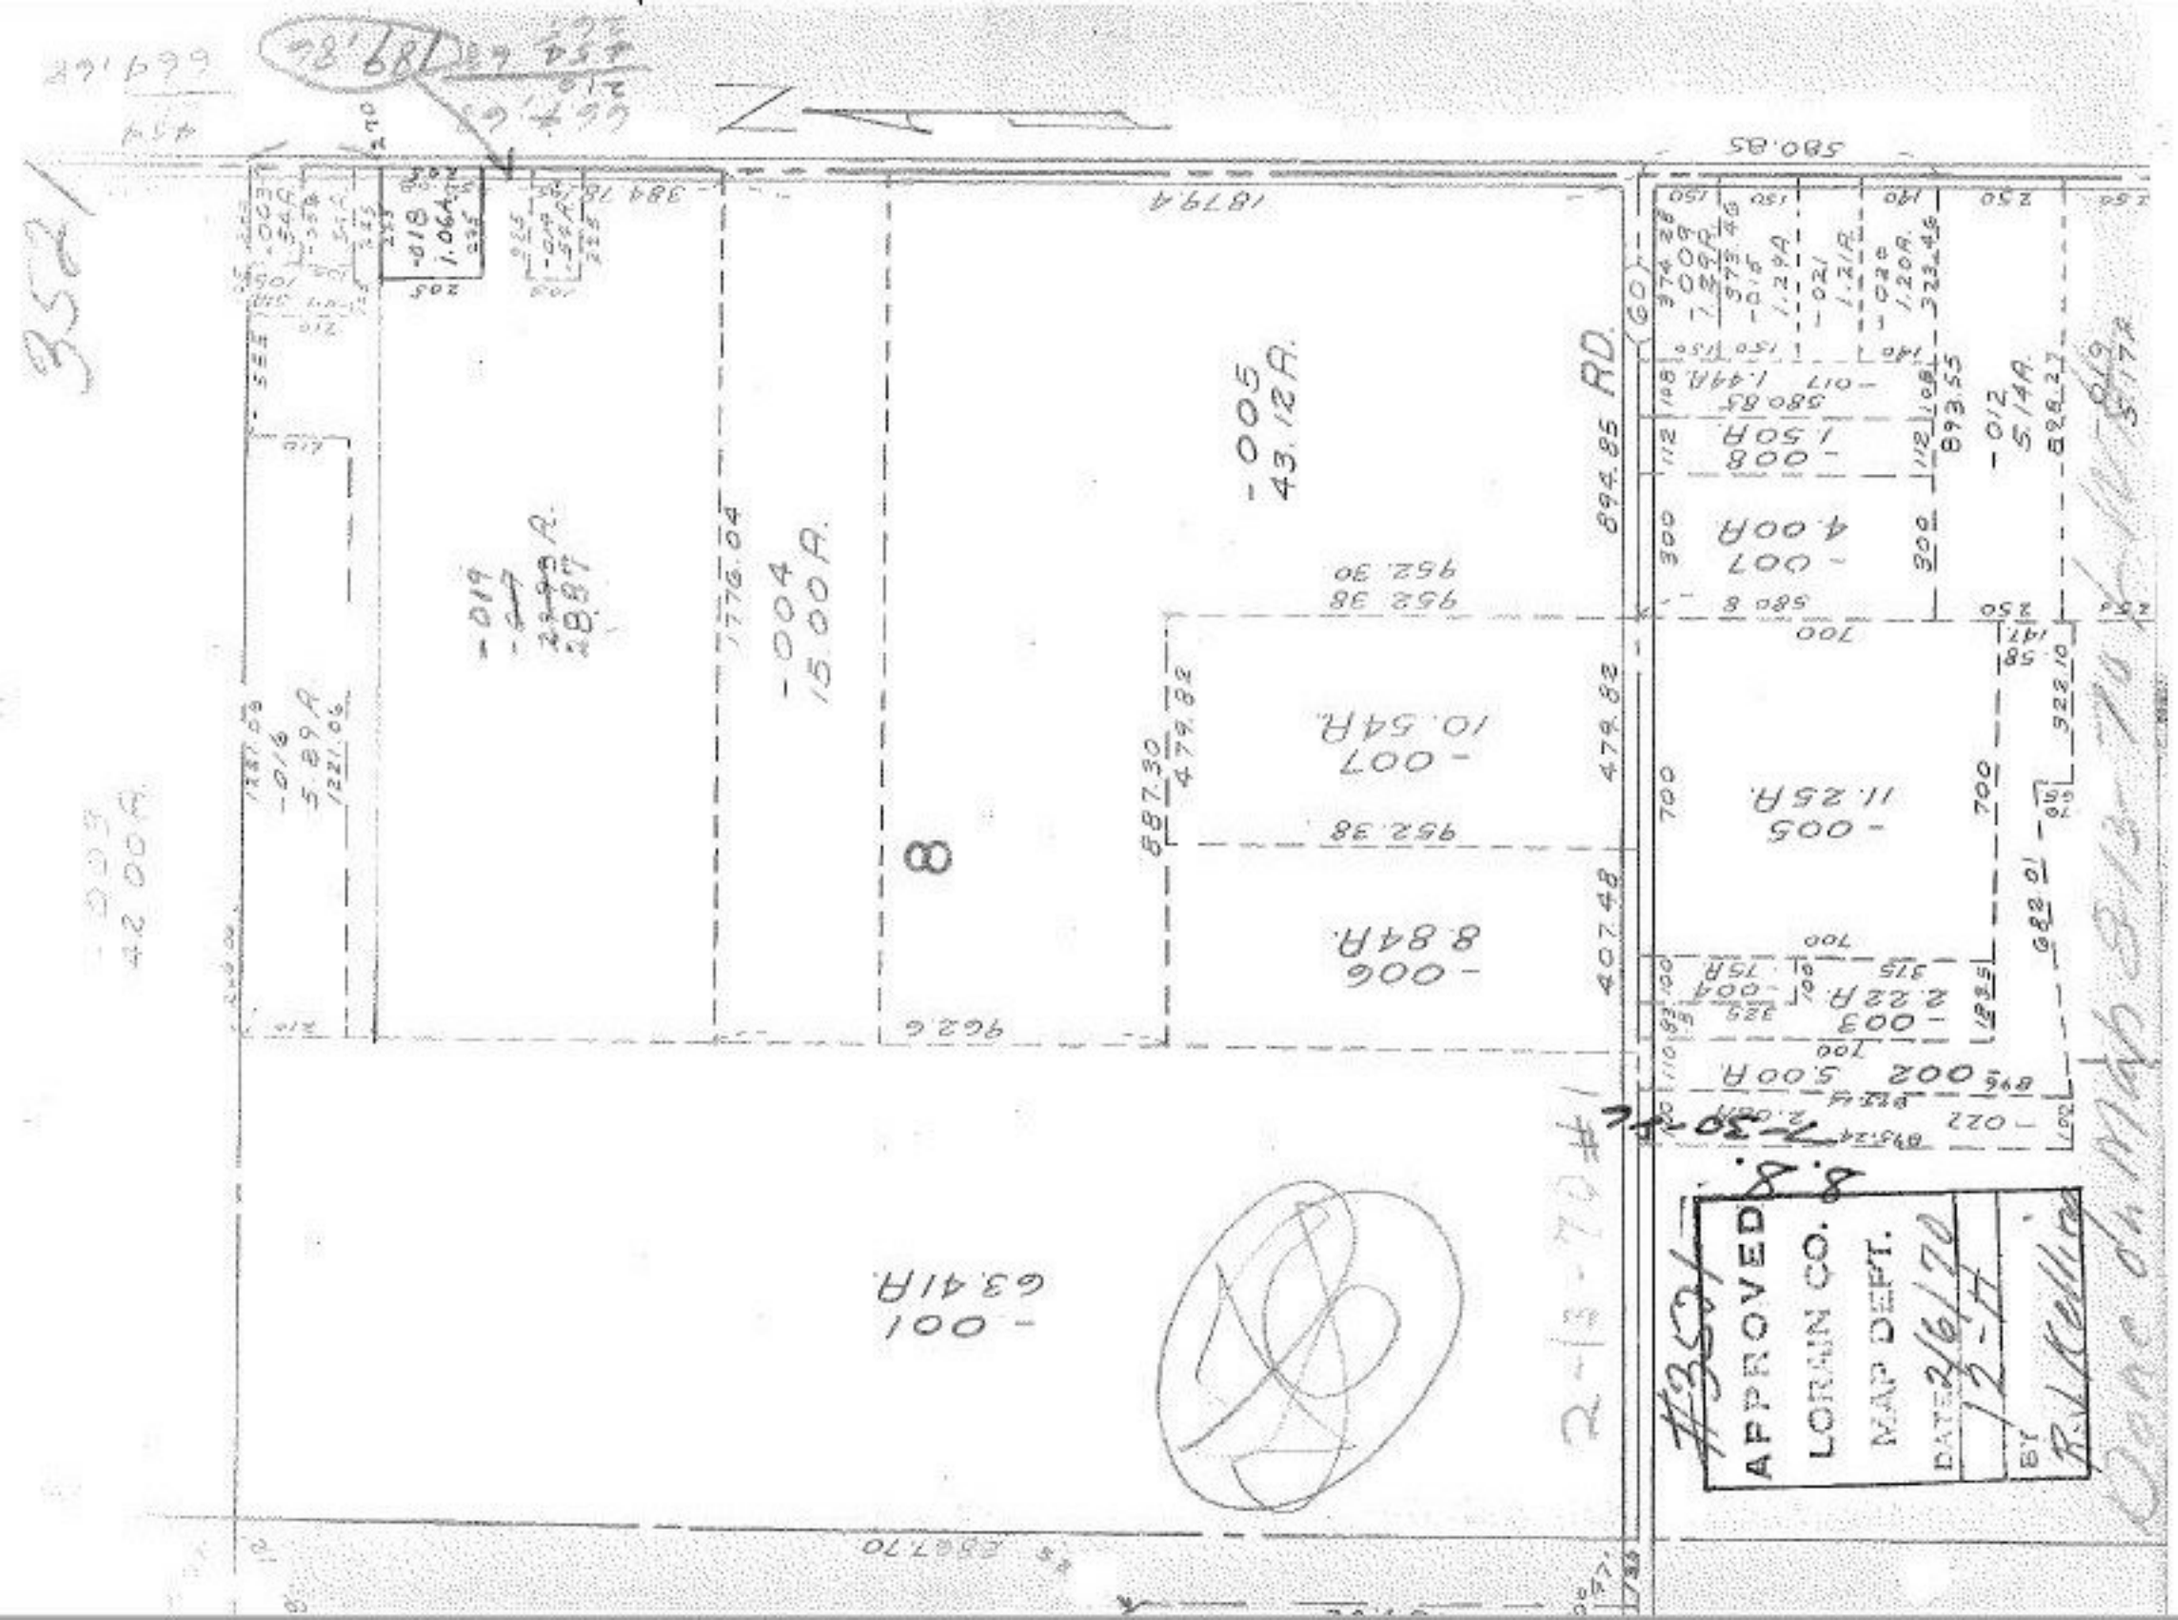

APPROVED
LORAIN CO.
MAP DEPT.
DATE 2/6/70
BY R.J. Kelling
#3521
-001
63.41A
-006
8.84A
-007
10.54A
-005
43.12A
-004
15.00A
-007
4.00A
-008
1.50A
-005
11.25A
-003
2.22A
-002
5.00A
-012
5.14A
-019
5.89A
-018
1.06A
-009
42.00A
RD.
894.85
1879.4
580.85
1776.04
952.38
952.30
479.82
407.48
962.6
2-13-70 #1