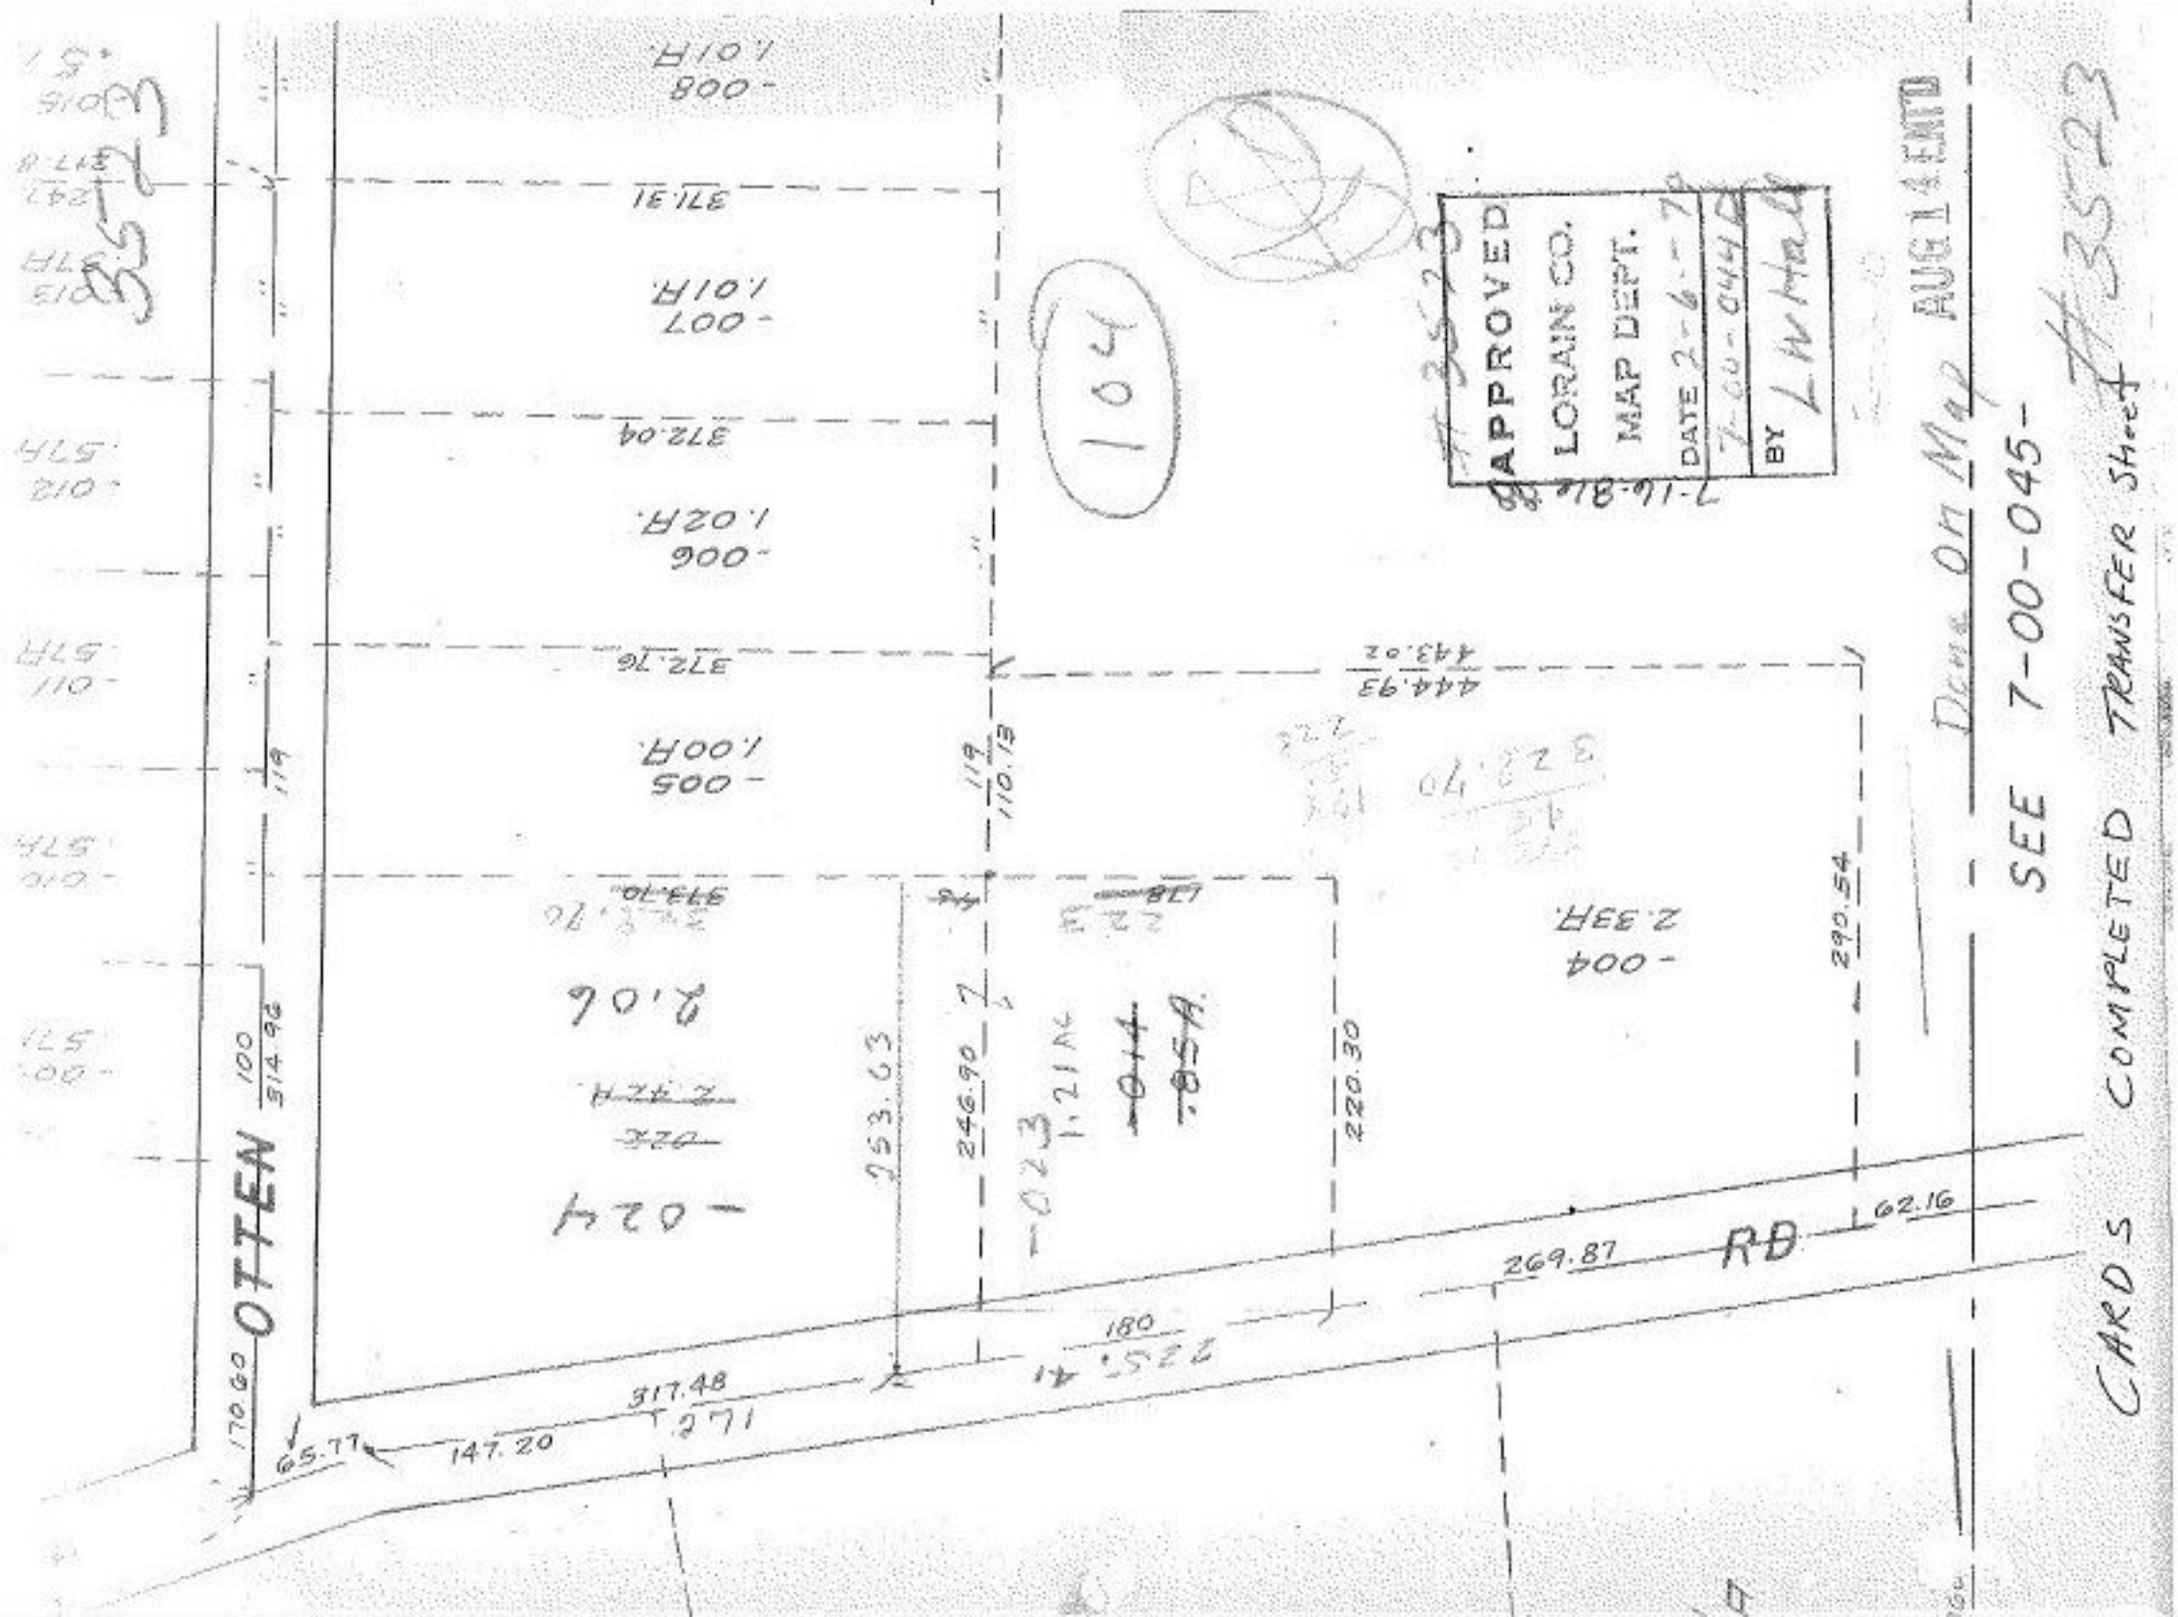

APPROVED
LORAIN CO.
MAP DEPT.
DATE 2-6-79
7-00-044D
BY LWHall
7-16-81
AUG 14 ENTD
Done On Map
SEE 7-00-045-
CARDS COMPLETED TRANSFER Sheet
#3523
104
OTTEN
RD
-008 1.01A
371.31
-007 1.01A
372.04
-006 1.02A
372.76
-005 1.00A
-004 2.33A
443.02
444.93
290.54
220.30
246.90
253.63
-024
-023
1.21 AC
2.06
314.96
170.60
65.77
147.20
317.48
180
269.87
62.16