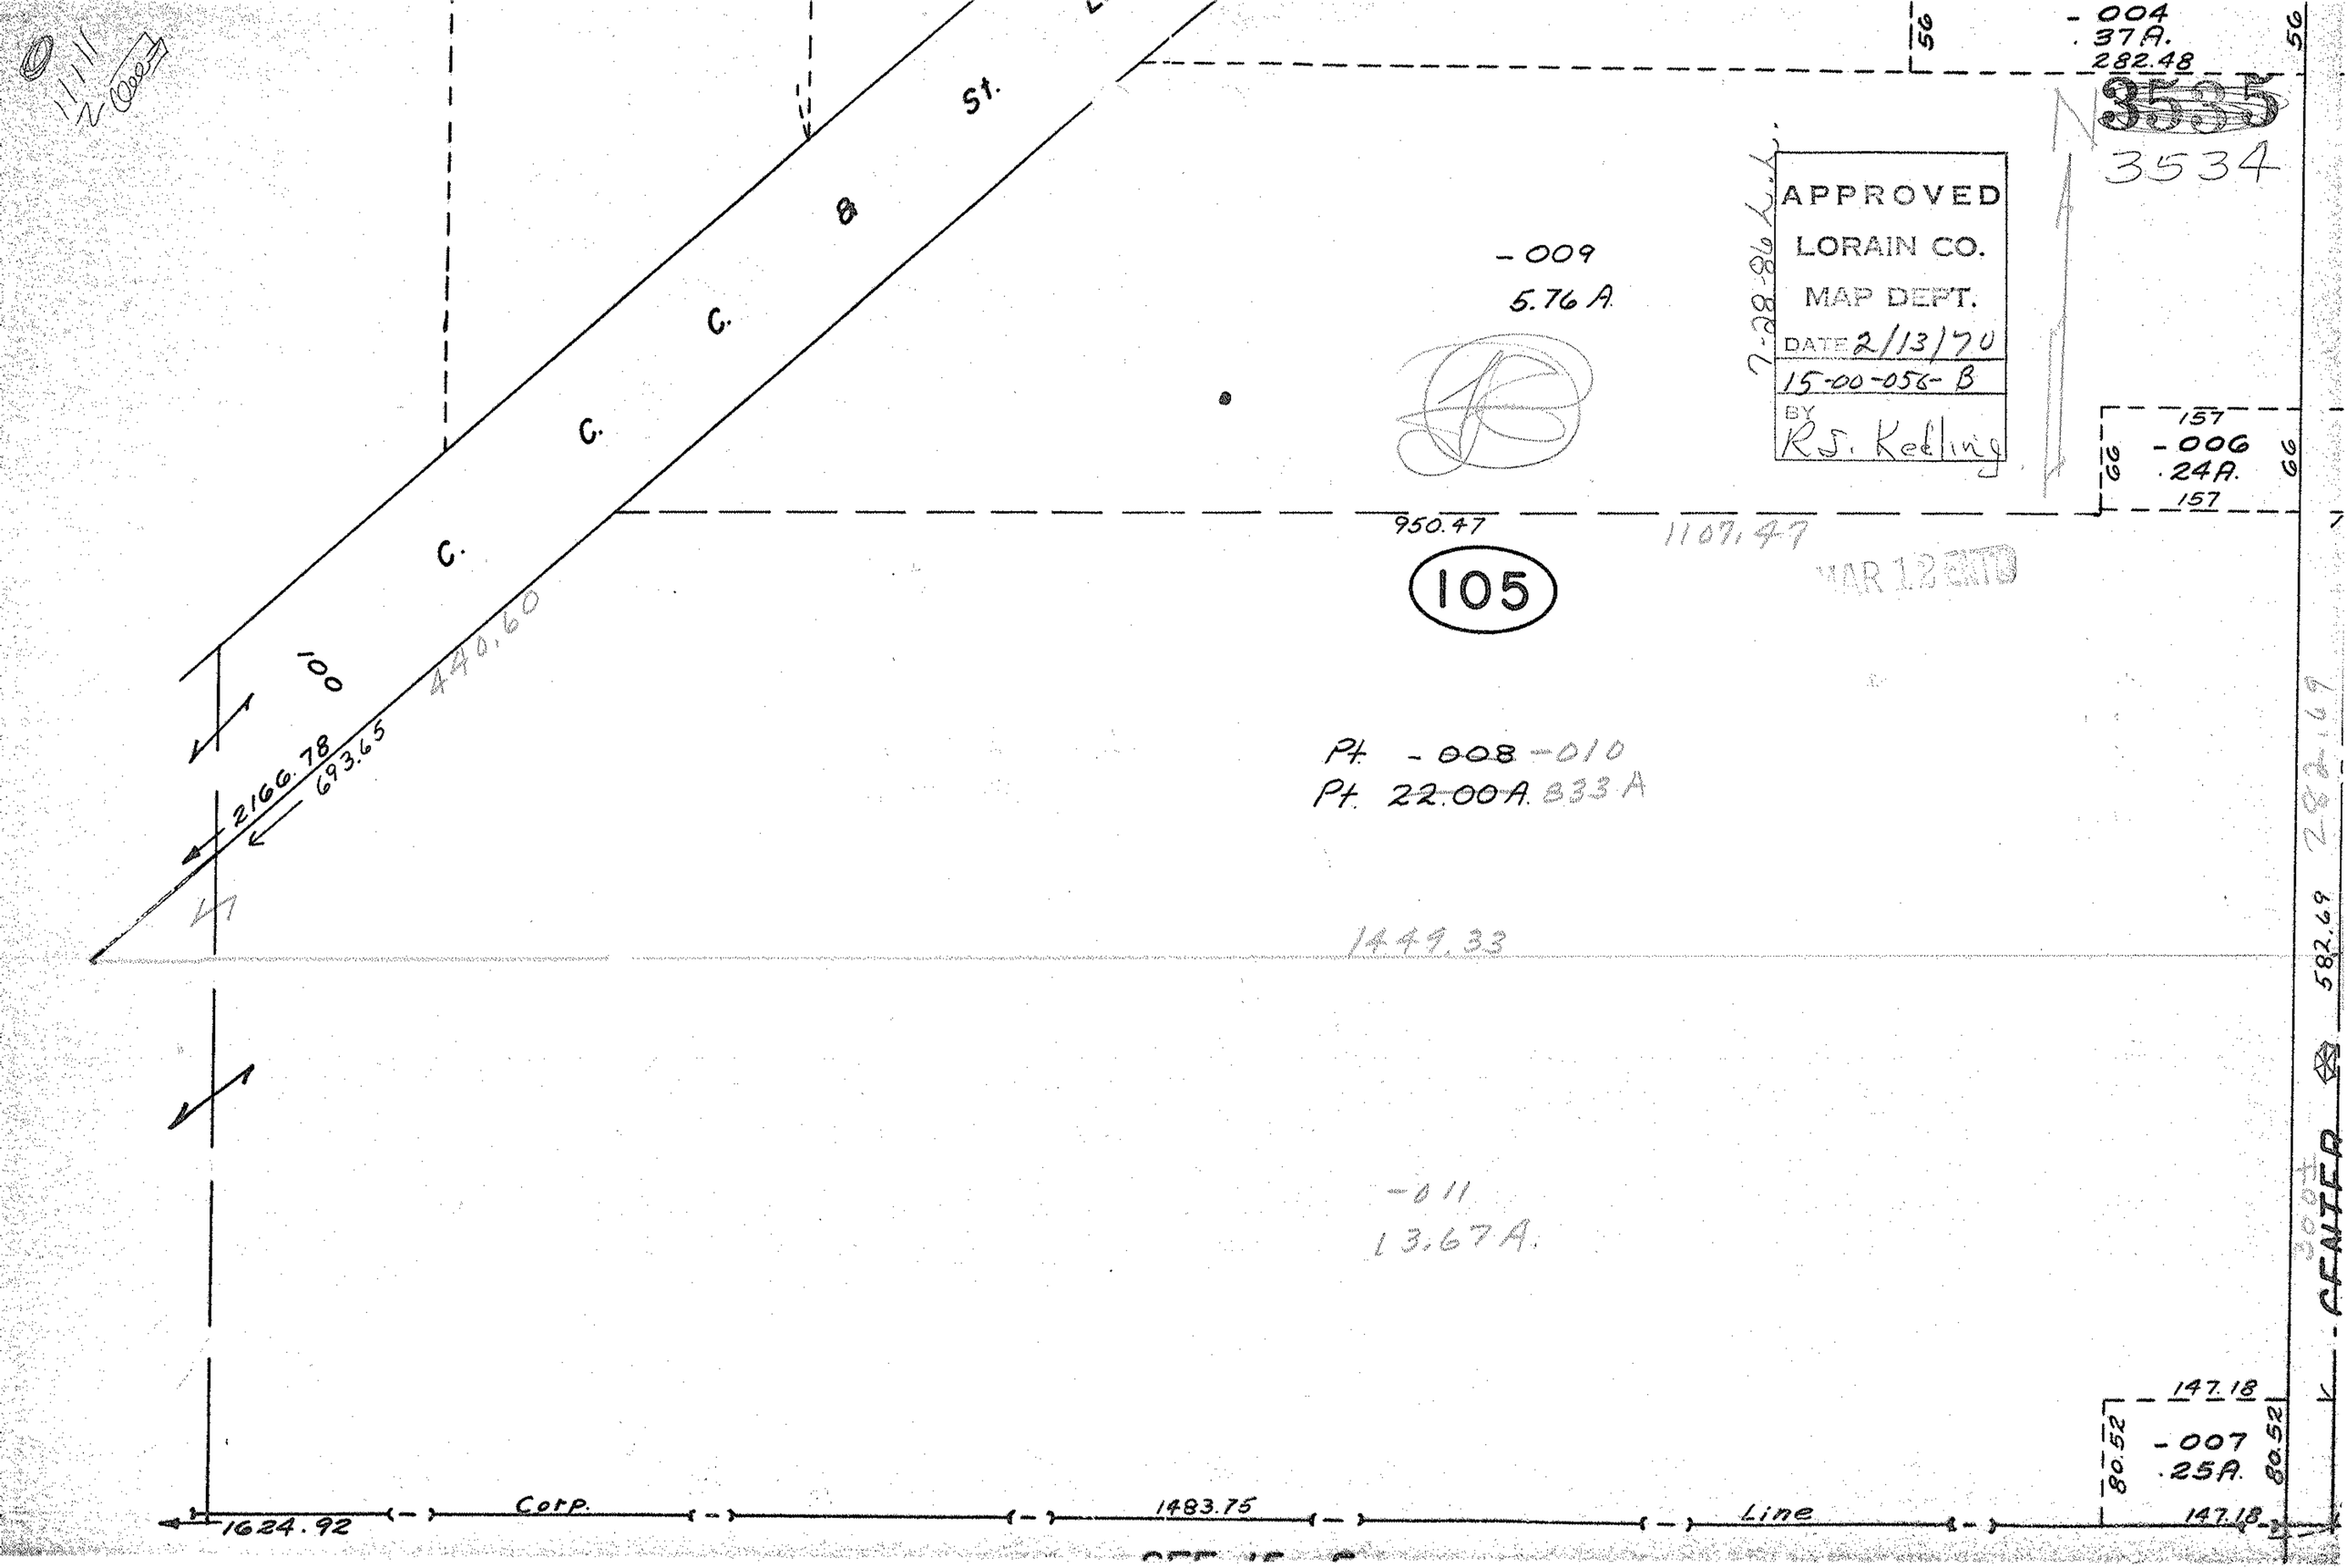

C. C. C. & St.
100
440.60
2166.78
693.65
-004
.37A.
282.48
56
3535
3534
APPROVED
LORAIN CO.
MAP DEPT.
DATE 2/13/70
15-00-056-B
BY R.S. Kedling
7-28-86 L.L.
-009
5.76 A.
157
-006
.24A.
157
66
950.47
1107.47
105
MAR 12 ENTD
Pt. -008 -010
Pt. 22.00A. 833 A
1449.33
-011
13.67A.
147.18
-007
.25A.
80.52
80.52
147.18
1624.92
Corp.
1483.75
Line
582.69
282.69
300±
CENTER