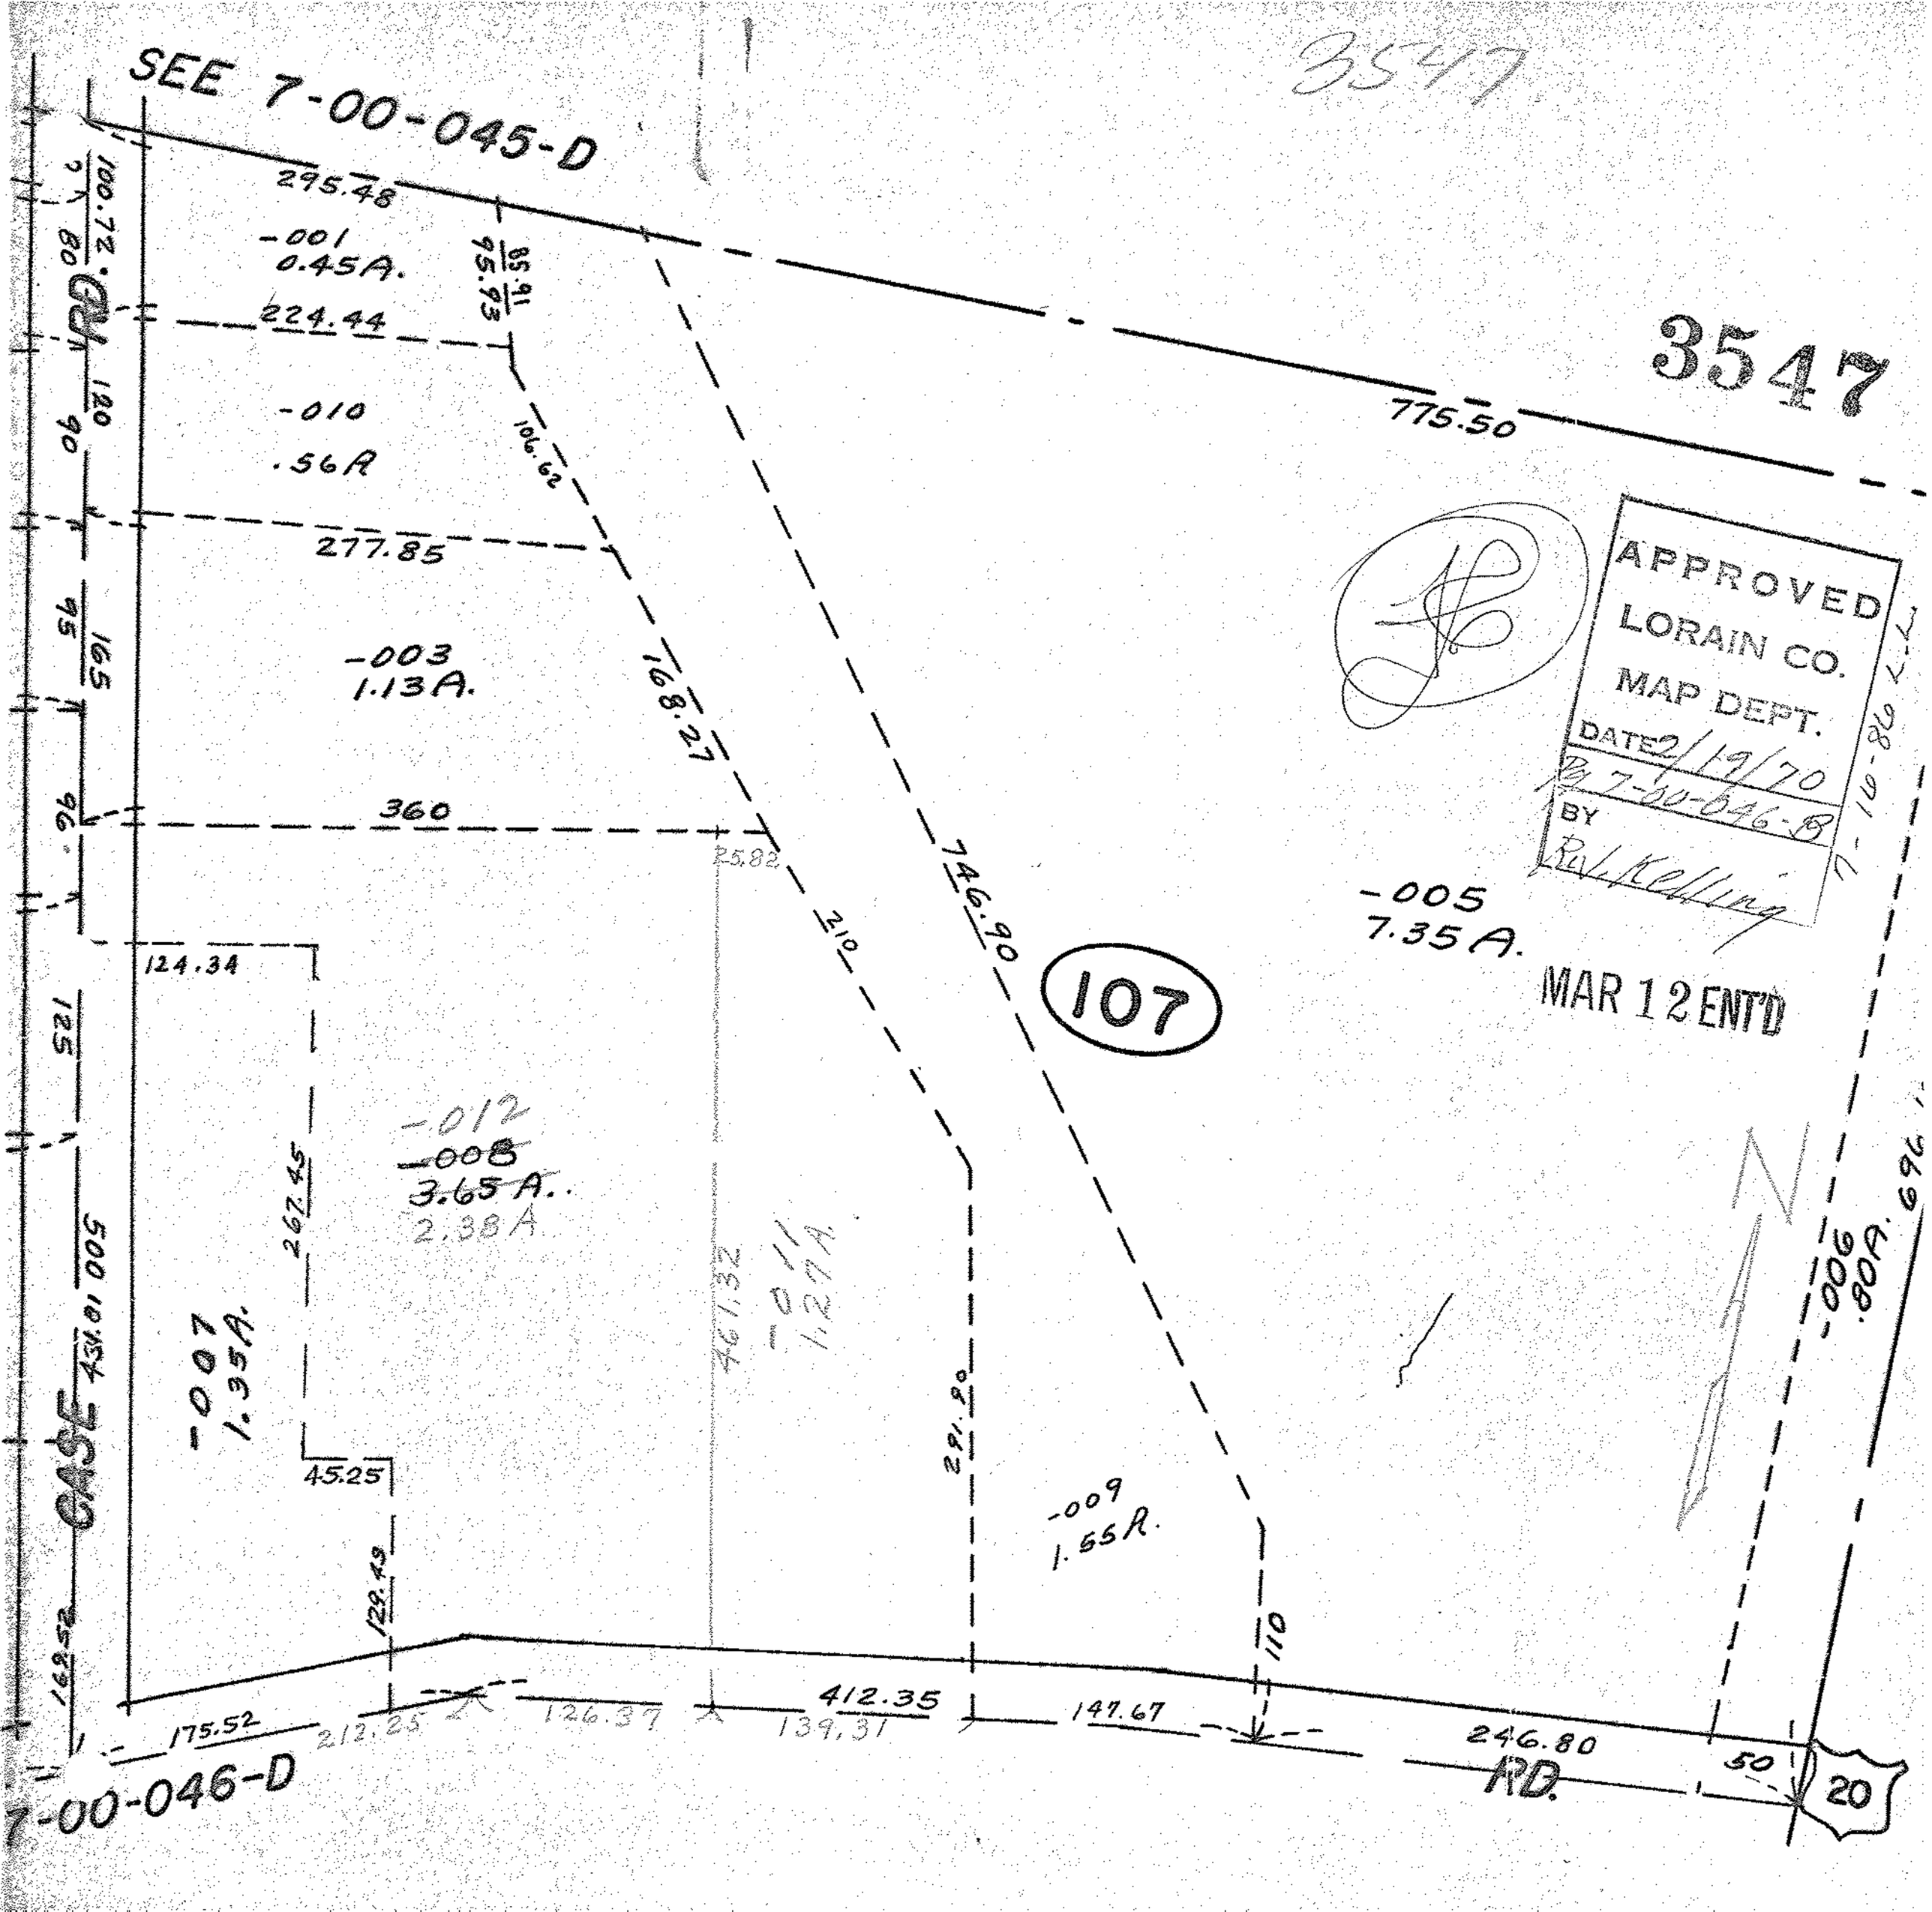
3547
SEE 7-00-045-D
295.48
-001
0.45A.
224.44
-010
.56A
277.85
-003
1.13A.
360
124.34
-012
-008
3.65 A.
2.38 A
267.45
-007
1.35A.
45.25
129.43
-011
1.27A
461.32
291.90
-009
1.55A.
110
-005
7.35 A.
775.50
106.62
168.27
746.90
210
25.82
412.35
147.67
246.80
175.52
212.25
126.37
139.31
50
RD.
20
CASE
7-00-046-D
-006
.80A.
APPROVED
LORAIN CO.
MAP DEPT.
DATE 2/19/70
BY
MAR 12 ENT'D
107