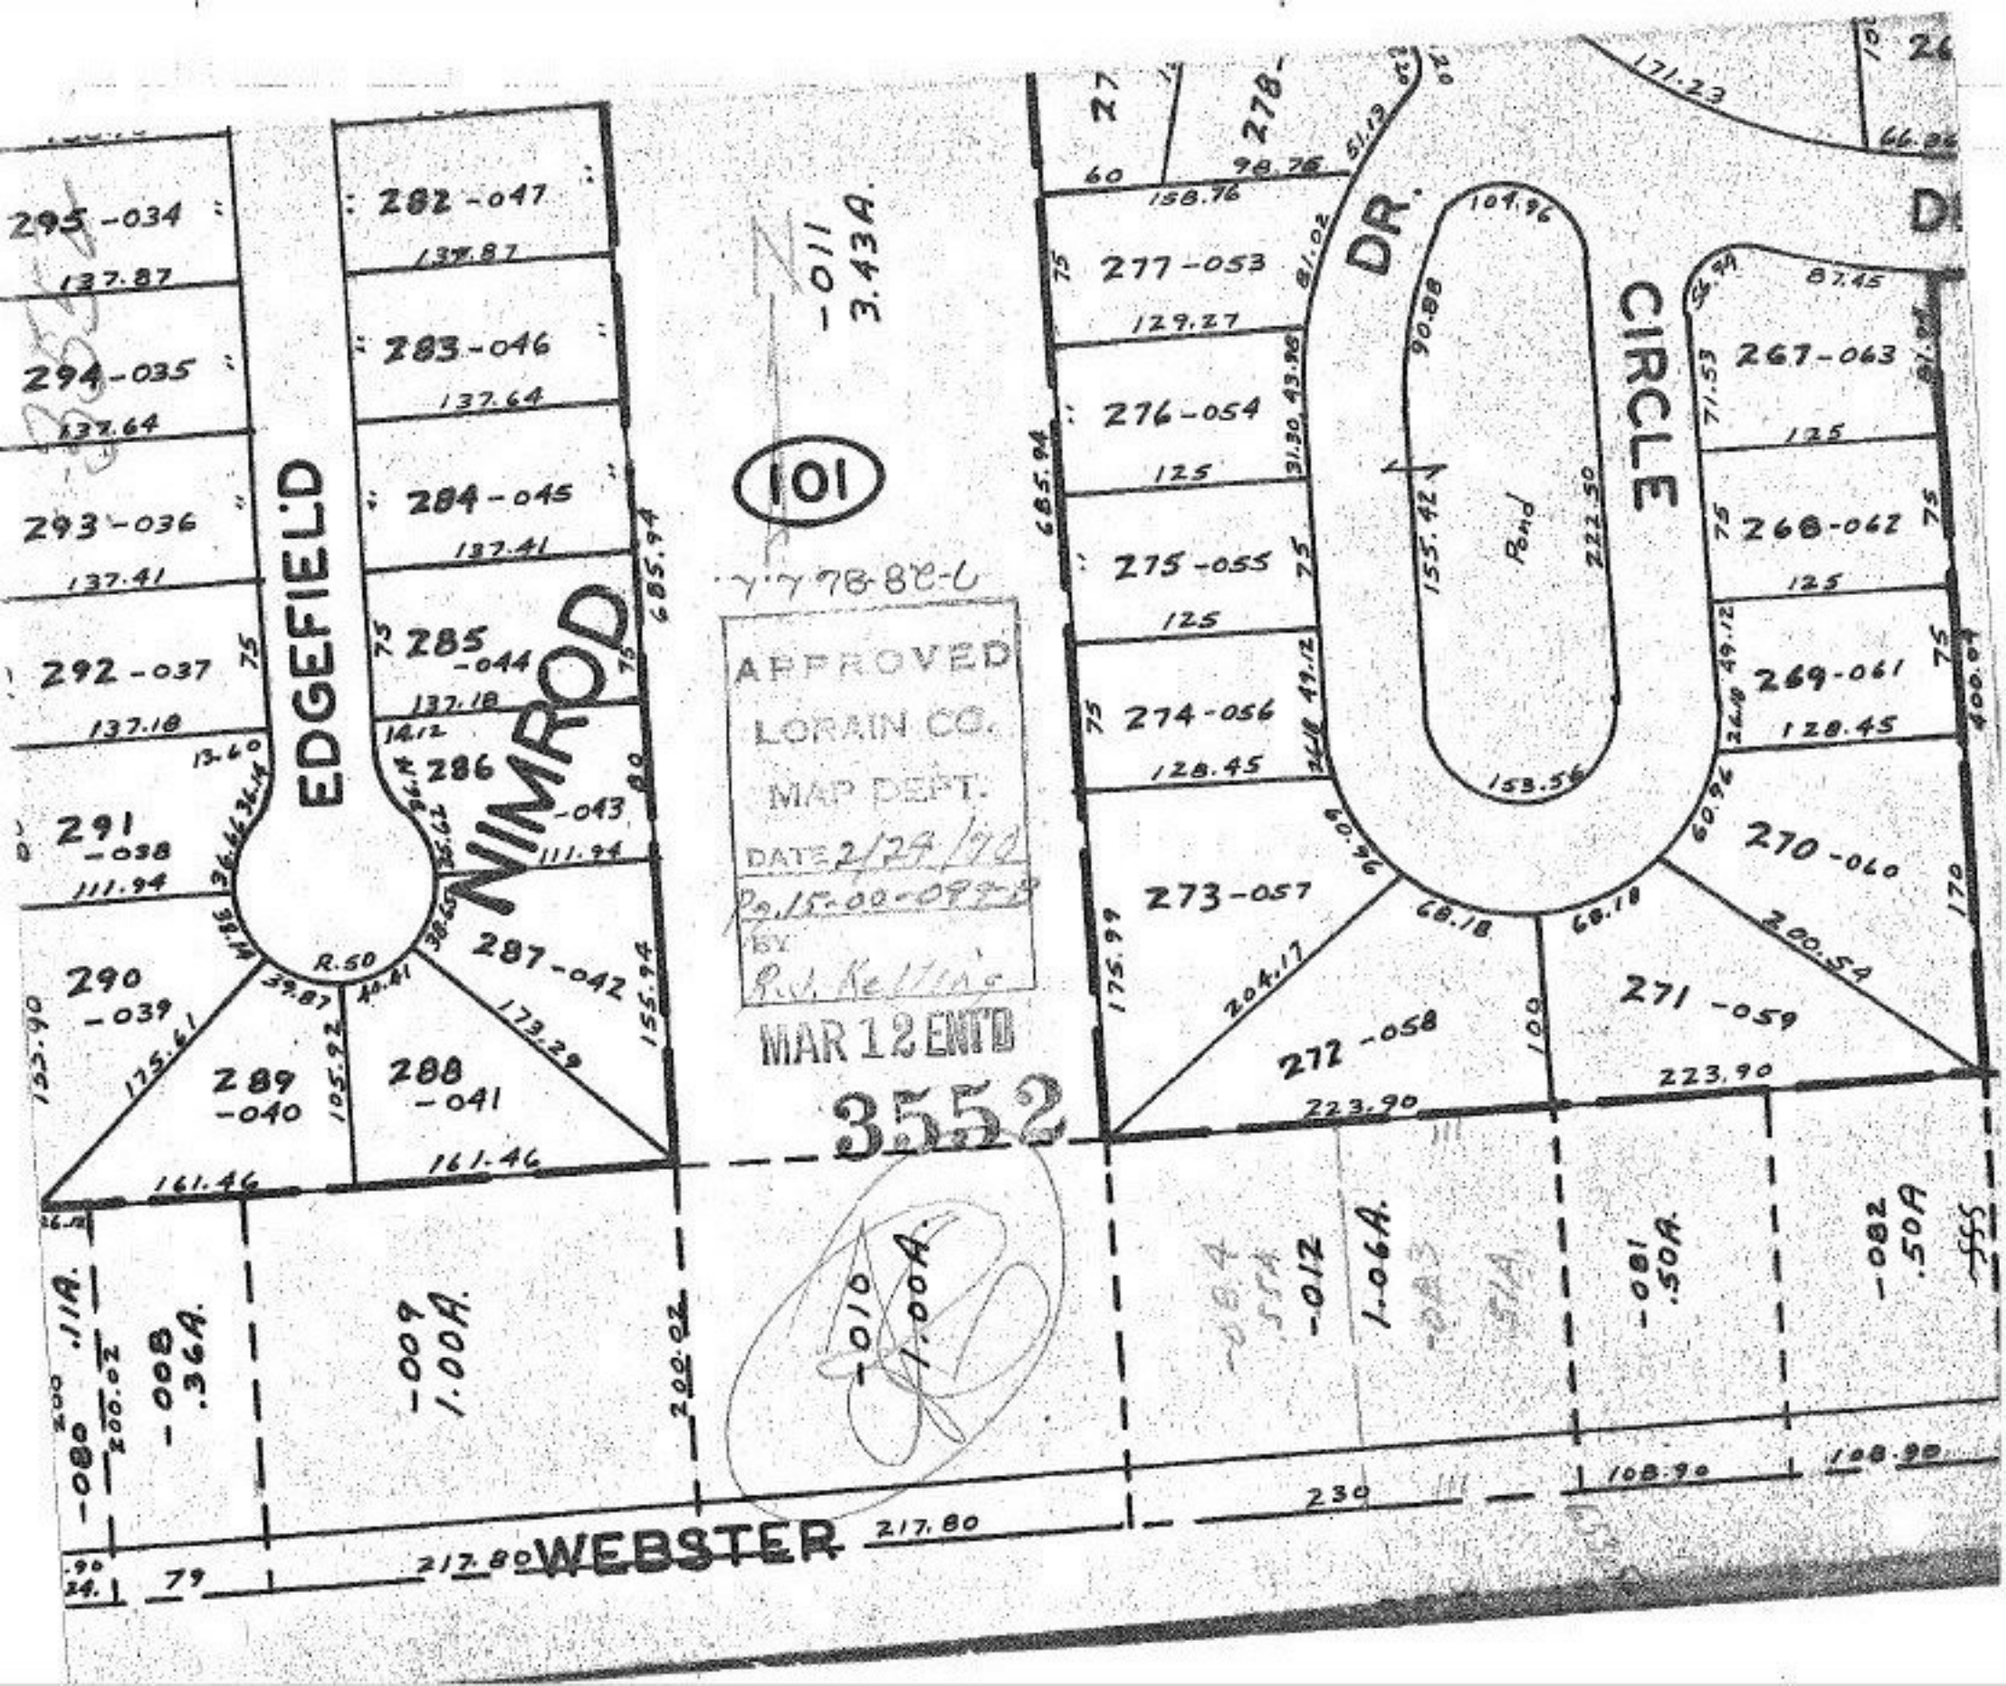
EDGEFIELD
NIMROD
DR.
CIRCLE
Pond
WEBSTER
101
-011
3.43A.
APPROVED
LORAIN CO.
MAP DEPT.
DATE 2/29/72
By R.J. Kellner
MAR 12 ENTD
3552
295-034
137.87
294-035
137.64
293-036
137.41
292-037
137.18
291-038
111.94
290-039
289-040
288-041
287-042
282-047
283-046
284-045
285-044
286-043
277-053
129.27
276-054
125
275-055
125
274-056
128.45
273-057
272-058
223.90
271-059
270-060
269-061
128.45
268-062
125
267-063
125
-008
.36A.
-009
1.00A.
-010
1.00A.
-012
1.06A.
-081
.50A.
-082
.50A.
-080
.11A.
685.94
200.02
217.80
230
108.90