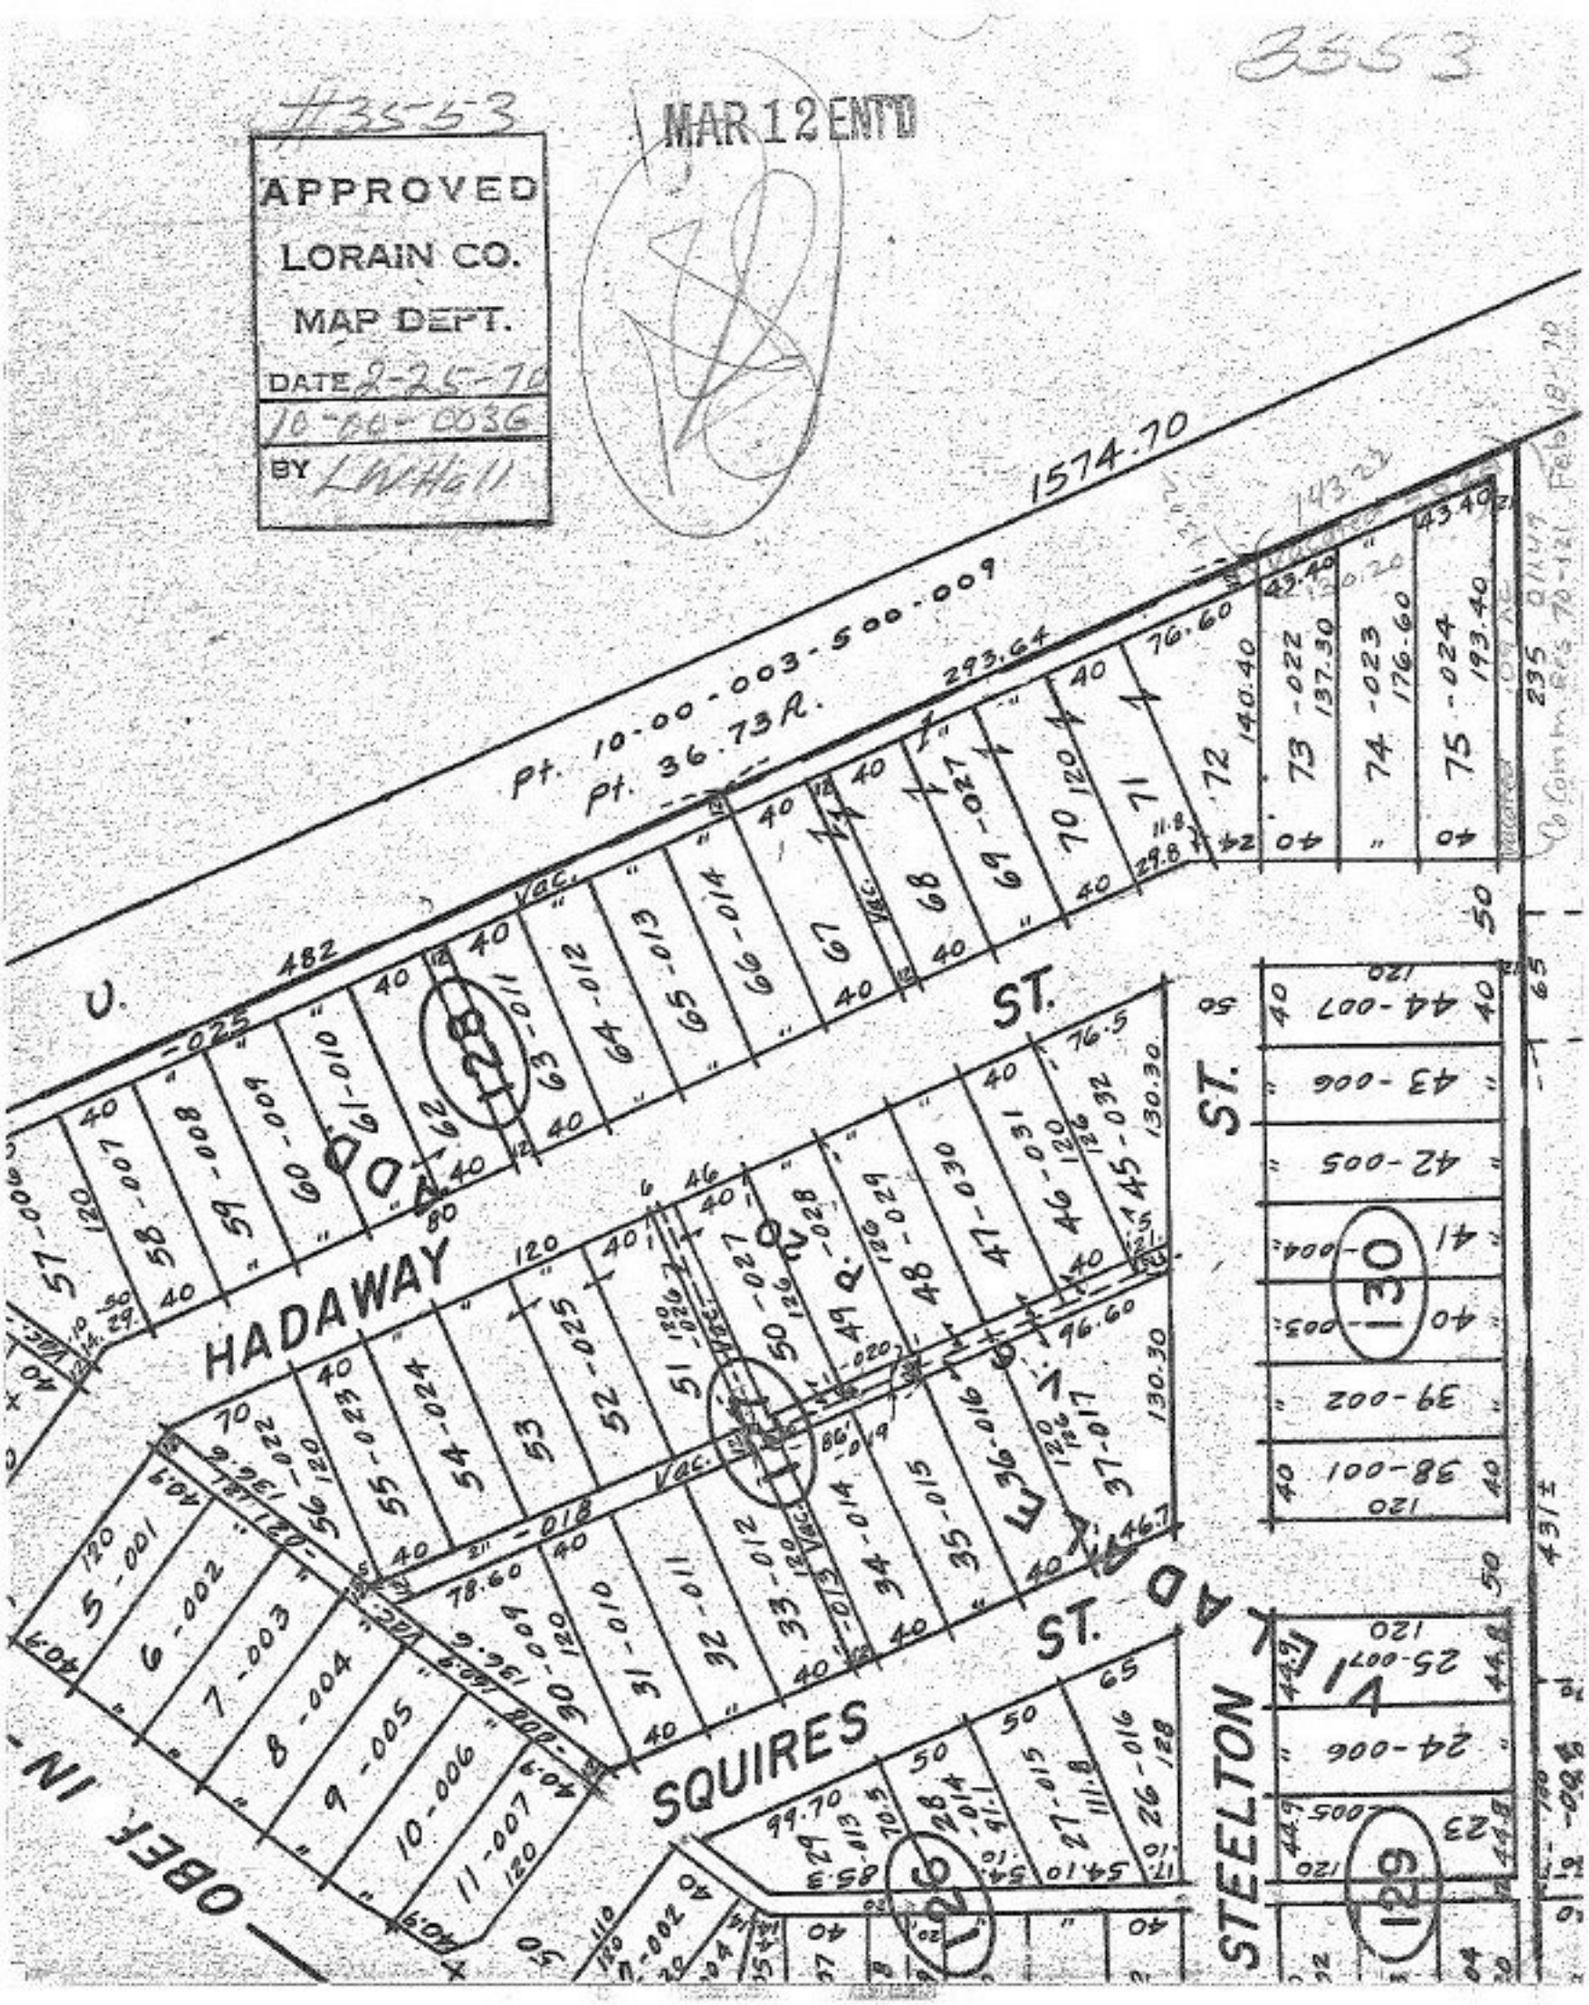

#3553
MAR 12 ENT'D
APPROVED
LORAIN CO.
MAP DEPT.
DATE 2-25-70
10-00-0036
BY LWHall
1574.70
Pt. 10-00-003-500-009
Pt. 36.73R.
293.64
HADAWAY
ST.
SQUIRES
ST.
STEELTON
ST.
OBEF IN
128
130
129
126