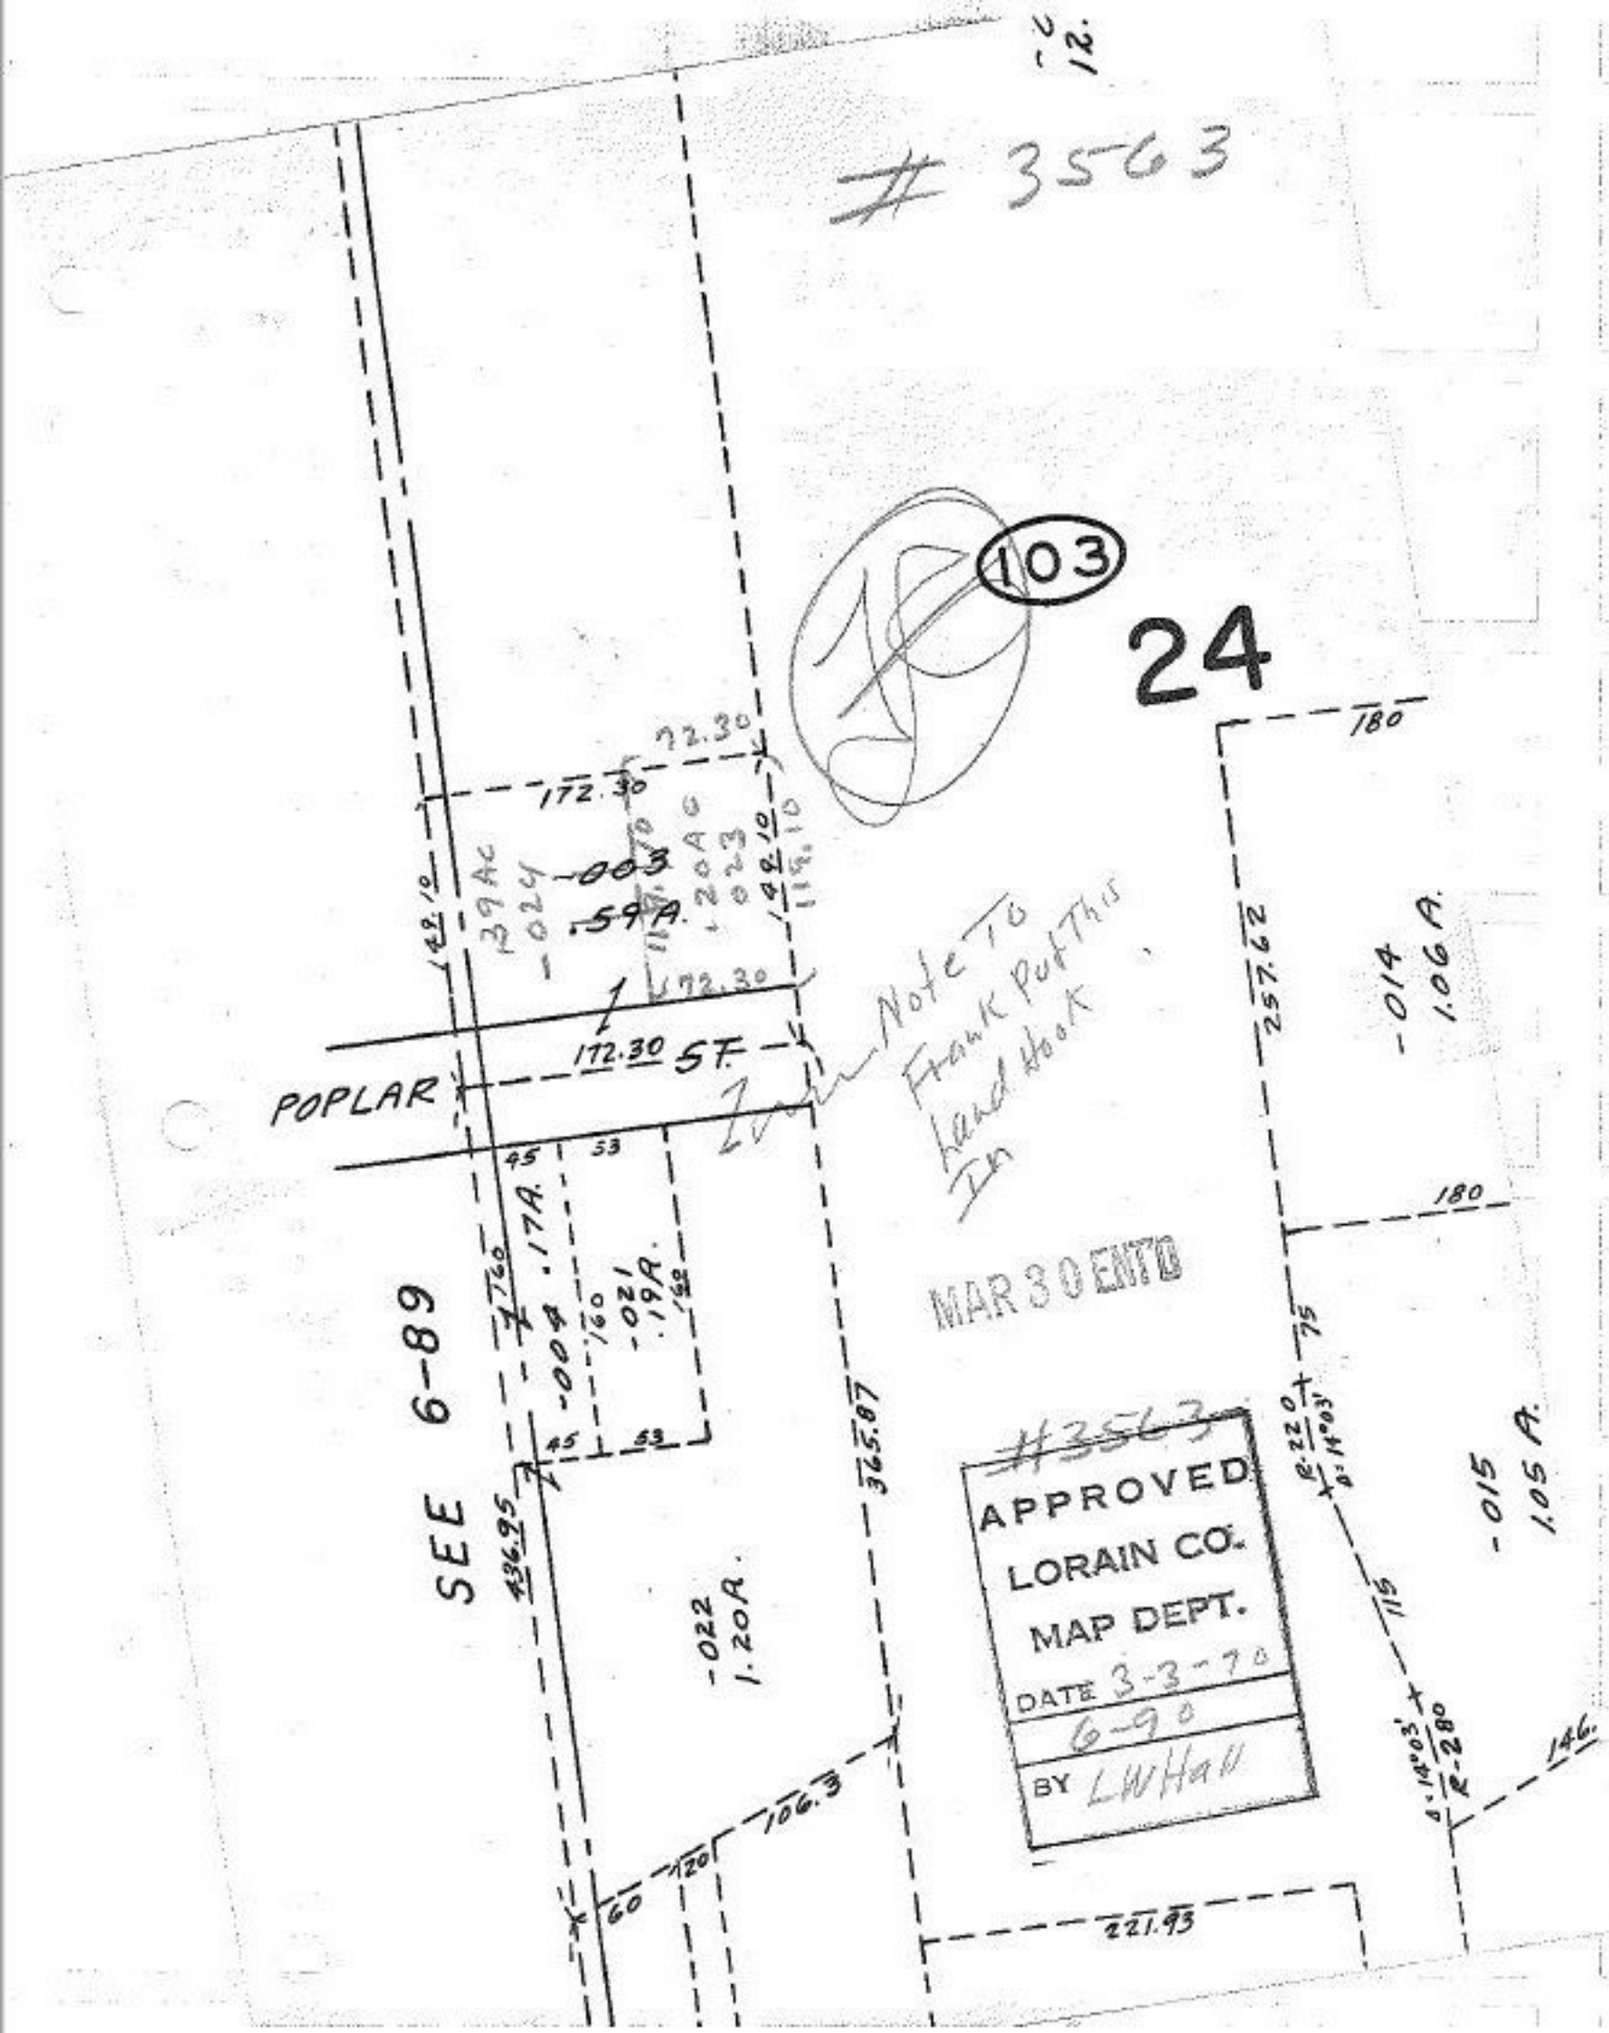

3563
103
24
POPLAR ST.
172.30
72.30
-003
.59A.
-004 .17A.
-021 .19A.
-022 1.20A.
-014 1.06A.
-015 1.05A.
SEE 6-89
436.95
365.87
257.62
221.93
106.3
180
146.
Note To Frank Put This Land Hook In
MAR 30 ENTD
#3563
APPROVED
LORAIN CO.
MAP DEPT.
DATE 3-3-70
6-90
BY LWHall