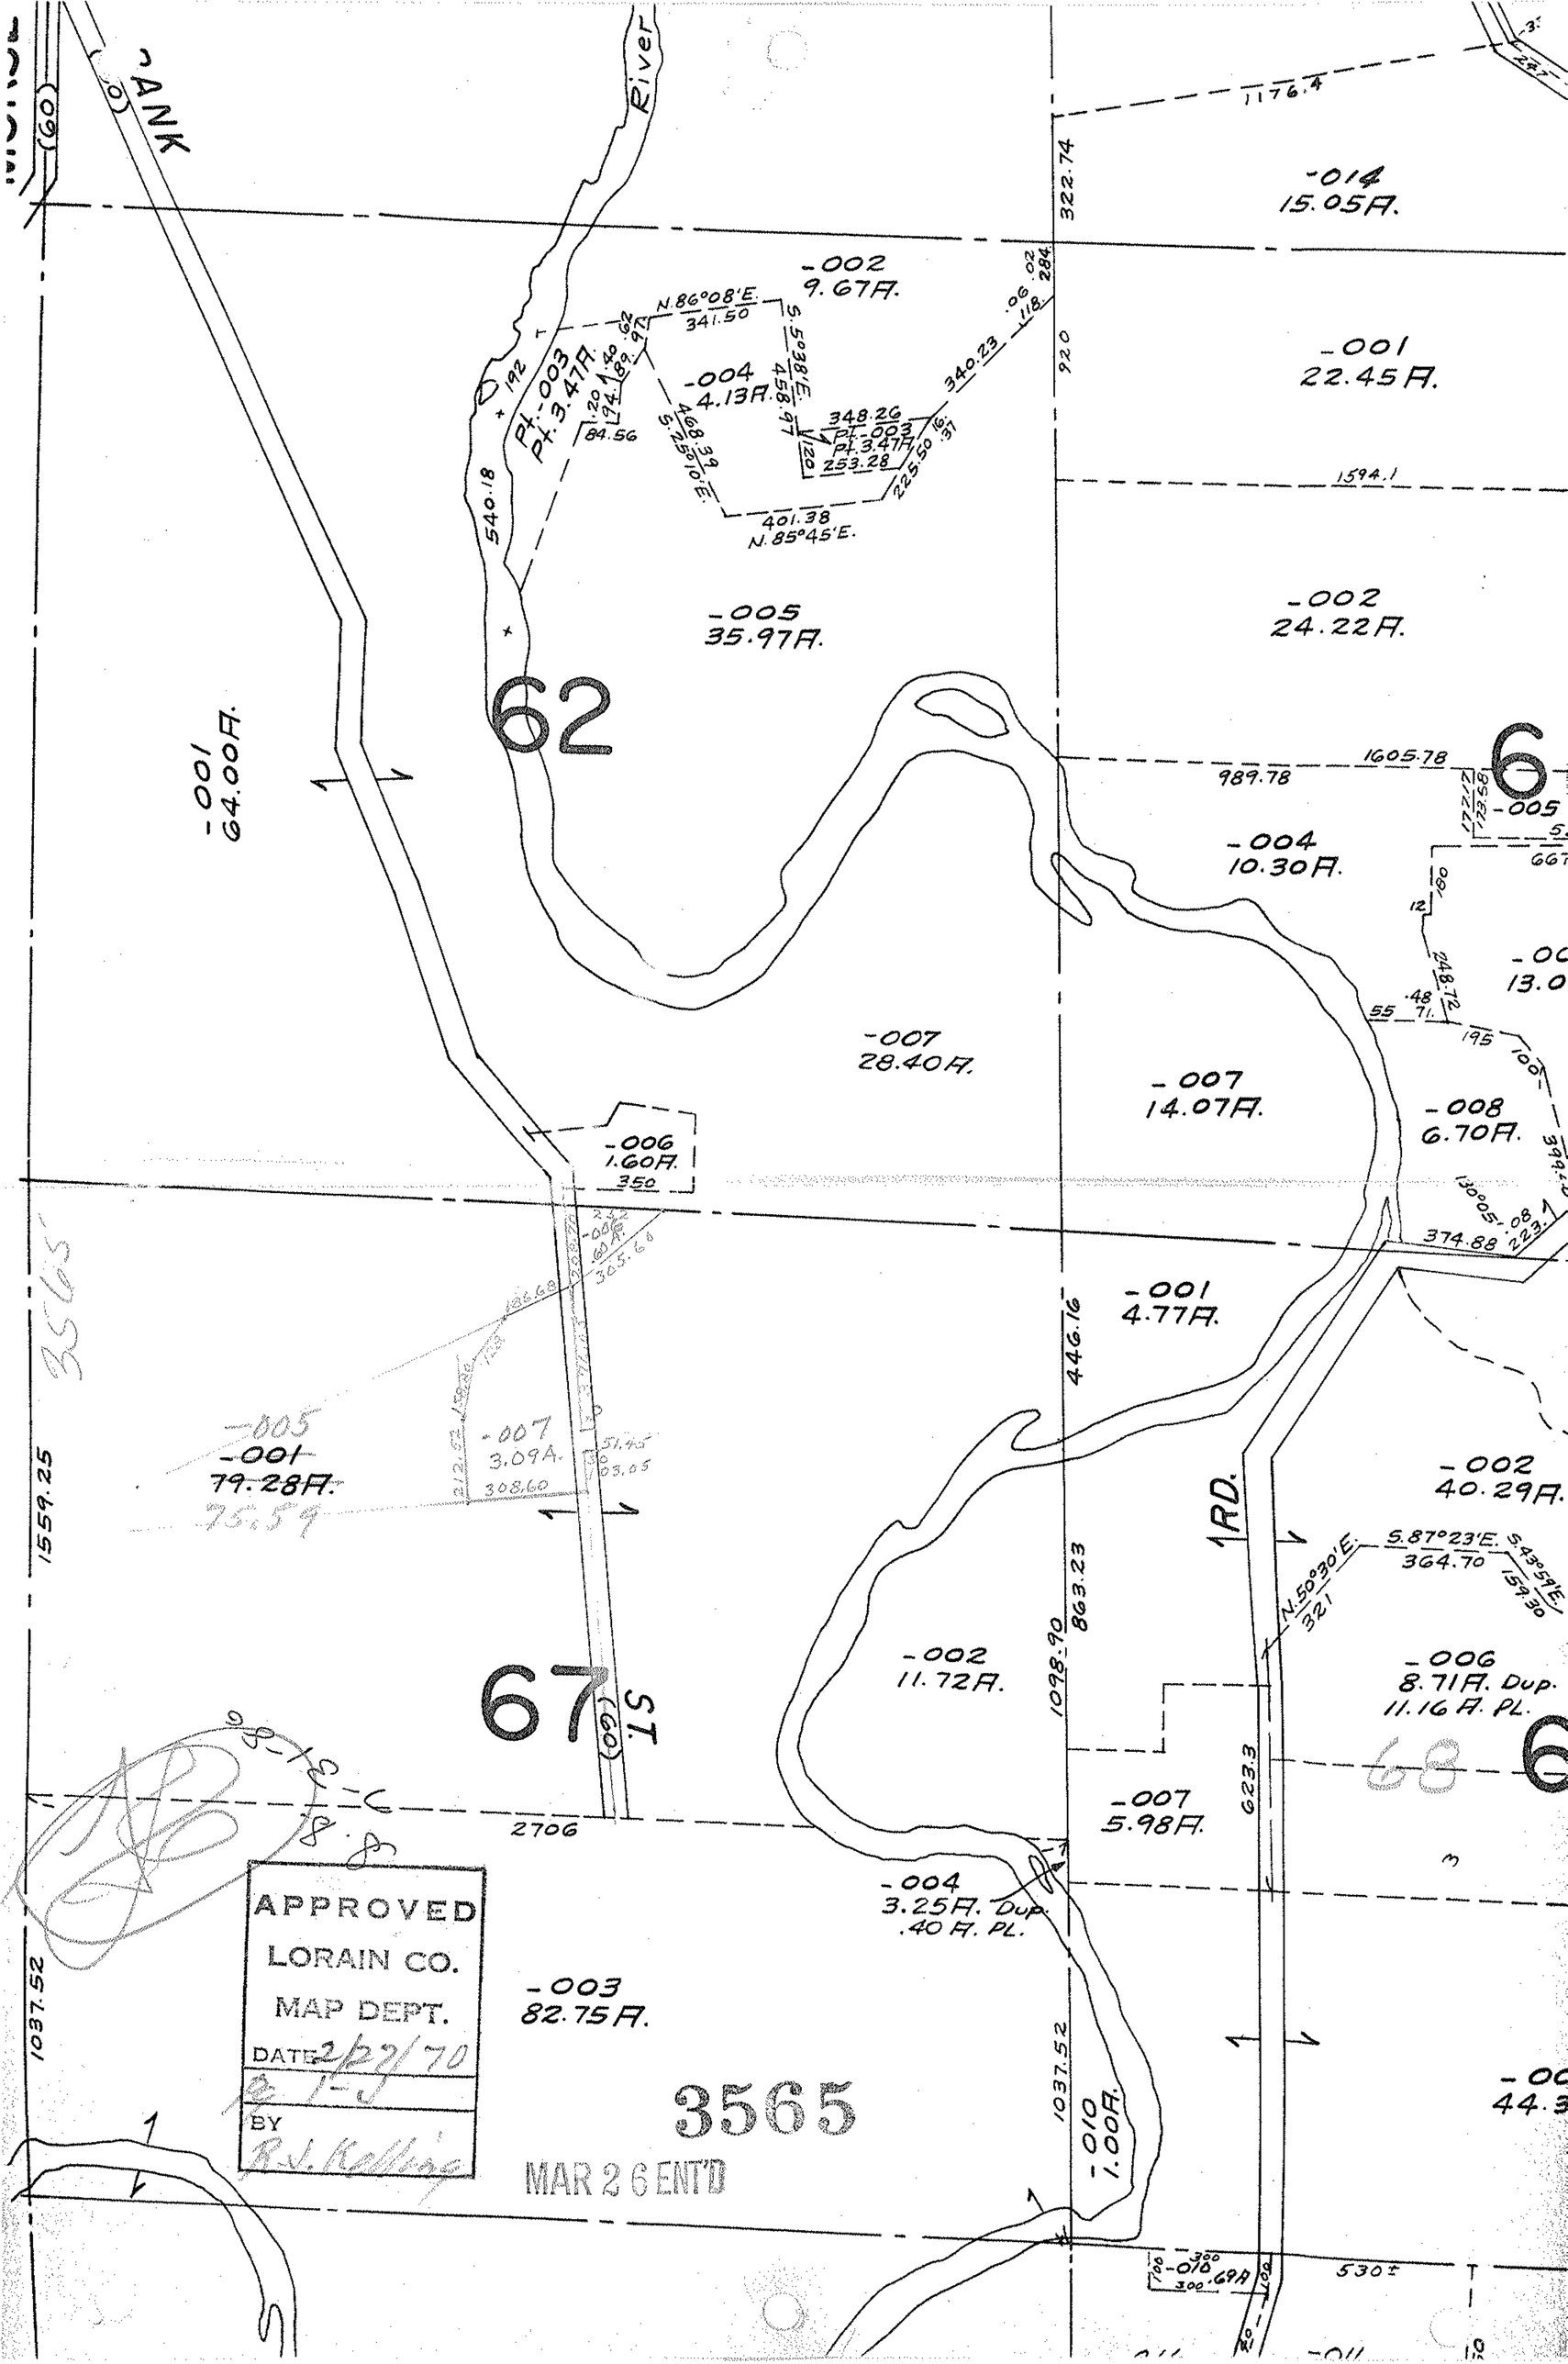
River
-002
9.67A.
-014
15.05A.
-001
22.45A.
-004
4.13A.
Pt.-003
Pt.3.47A.
-005
35.97A.
-002
24.22A.
62
-001
64.00A.
-004
10.30A.
-007
28.40A.
-007
14.07A.
-008
6.70A.
-006
1.60A.
-001
4.77A.
-007
3.09A.
-001
79.28A.
-002
40.29A.
1RD.
-002
11.72A.
-006
8.71A. Dup.
11.16A. PL.
67
ST.
-007
5.98A.
-004
3.25A. Dup.
.40A. PL.
-003
82.75A.
-010
1.00A.
-010
.69A
APPROVED
LORAIN CO.
MAP DEPT.
DATE 2/27/70
BY
3565
MAR 26 ENT'D