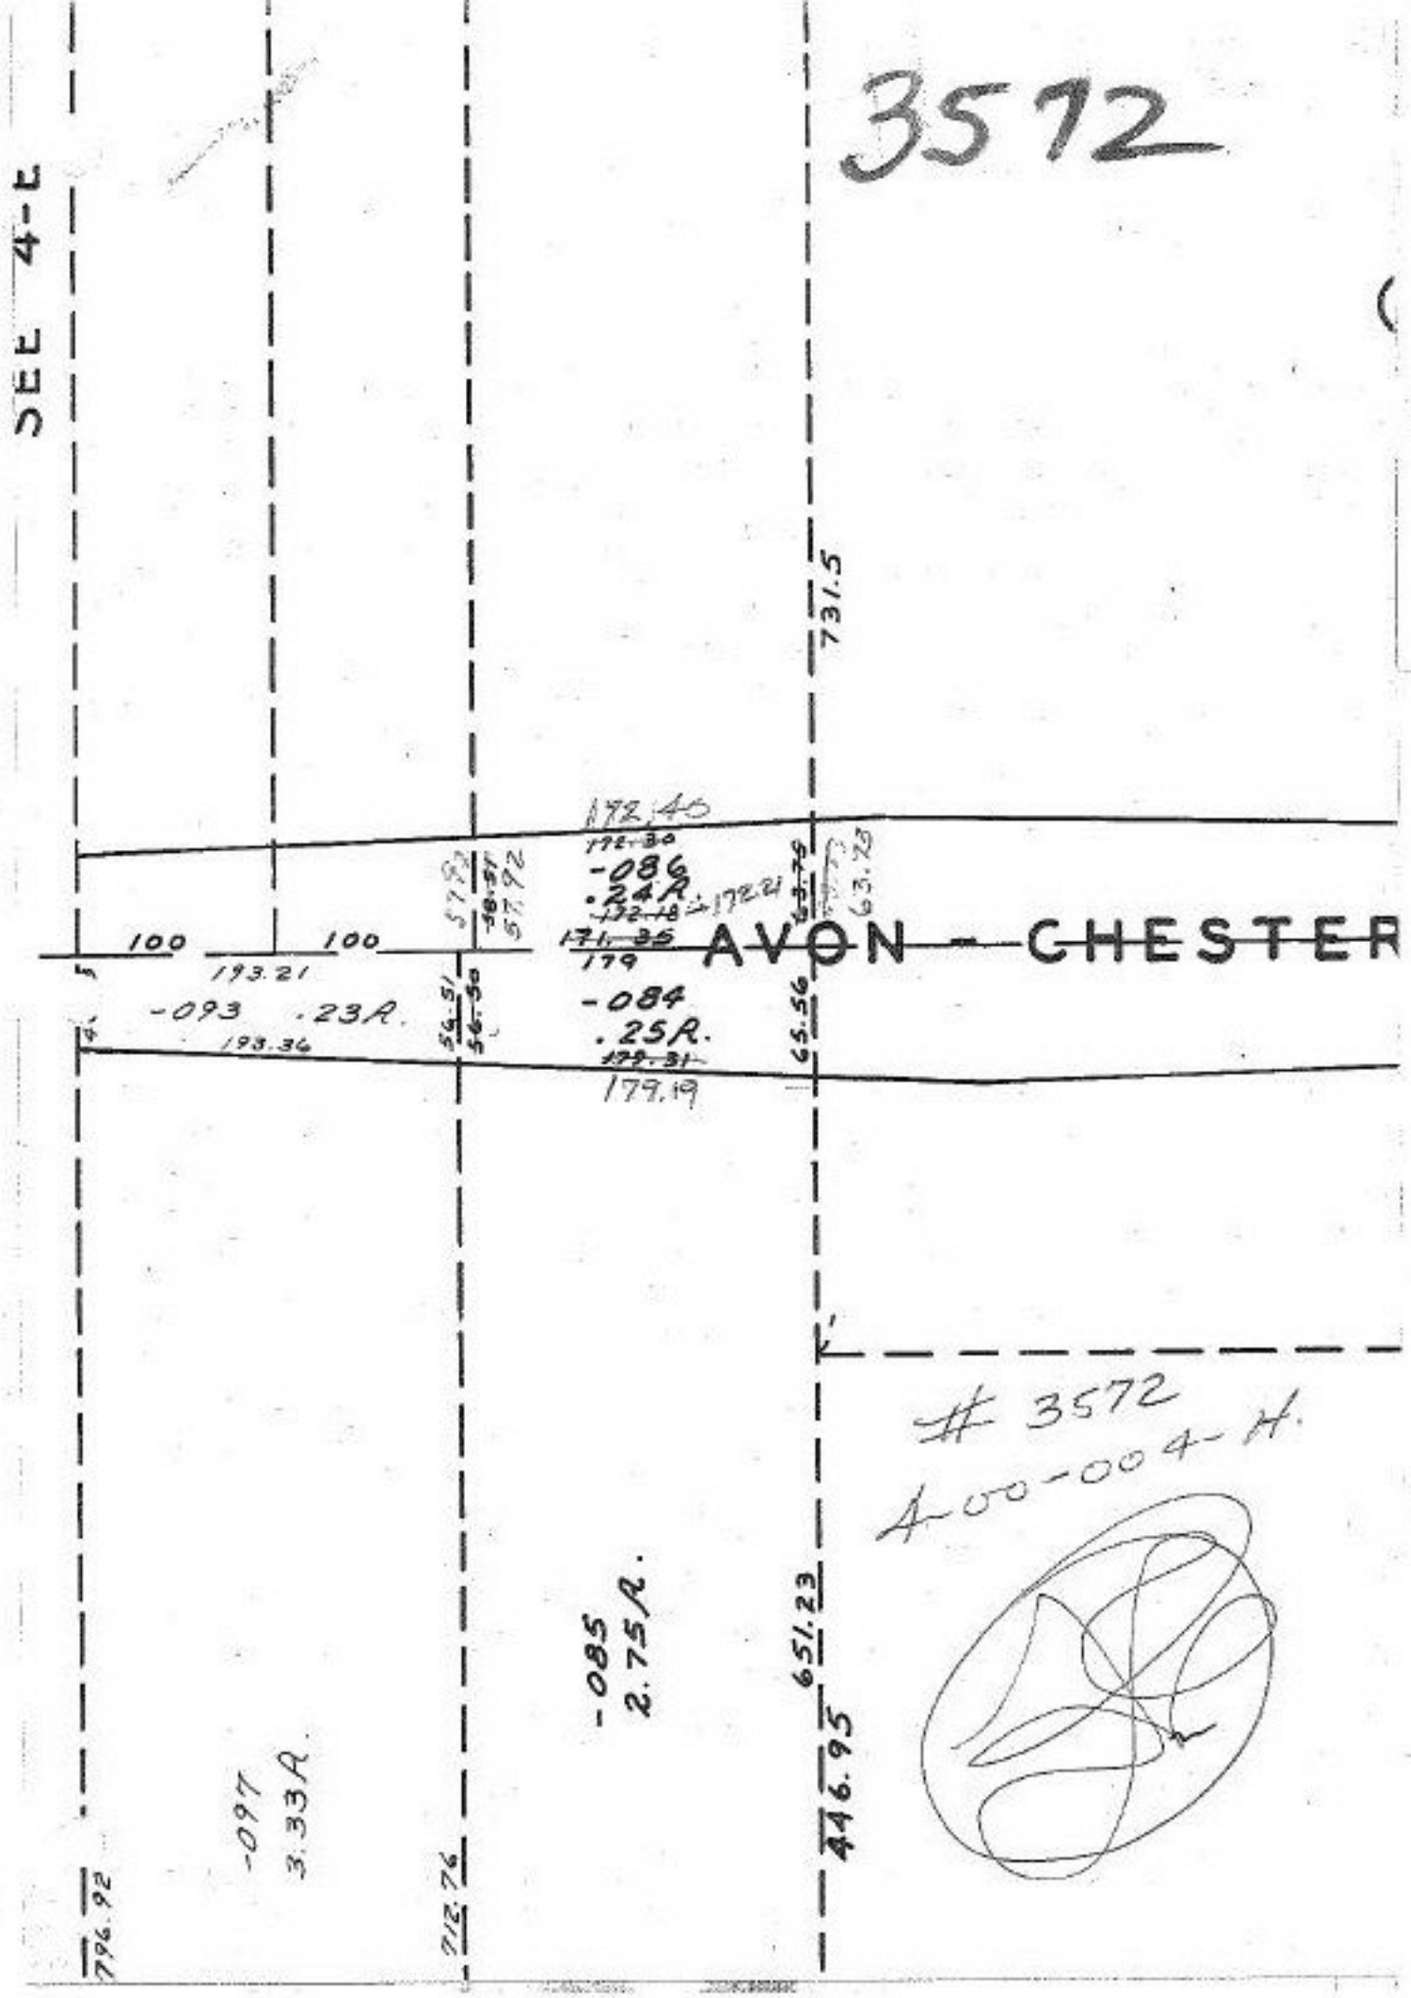
3572
SEE 4-E
731.5
172.40
172.30
-086
.24R.
172.18
172.21
63.73
57.92
100
100
171.35
179
AVON - CHESTER
193.21
-093
.23R.
193.36
56.51
56.50
-084
.25R.
179.31
179.19
65.56
3572
4-00-004-H.
-085
2.75R.
651.23
446.95
-097
3.33R.
796.92
712.76