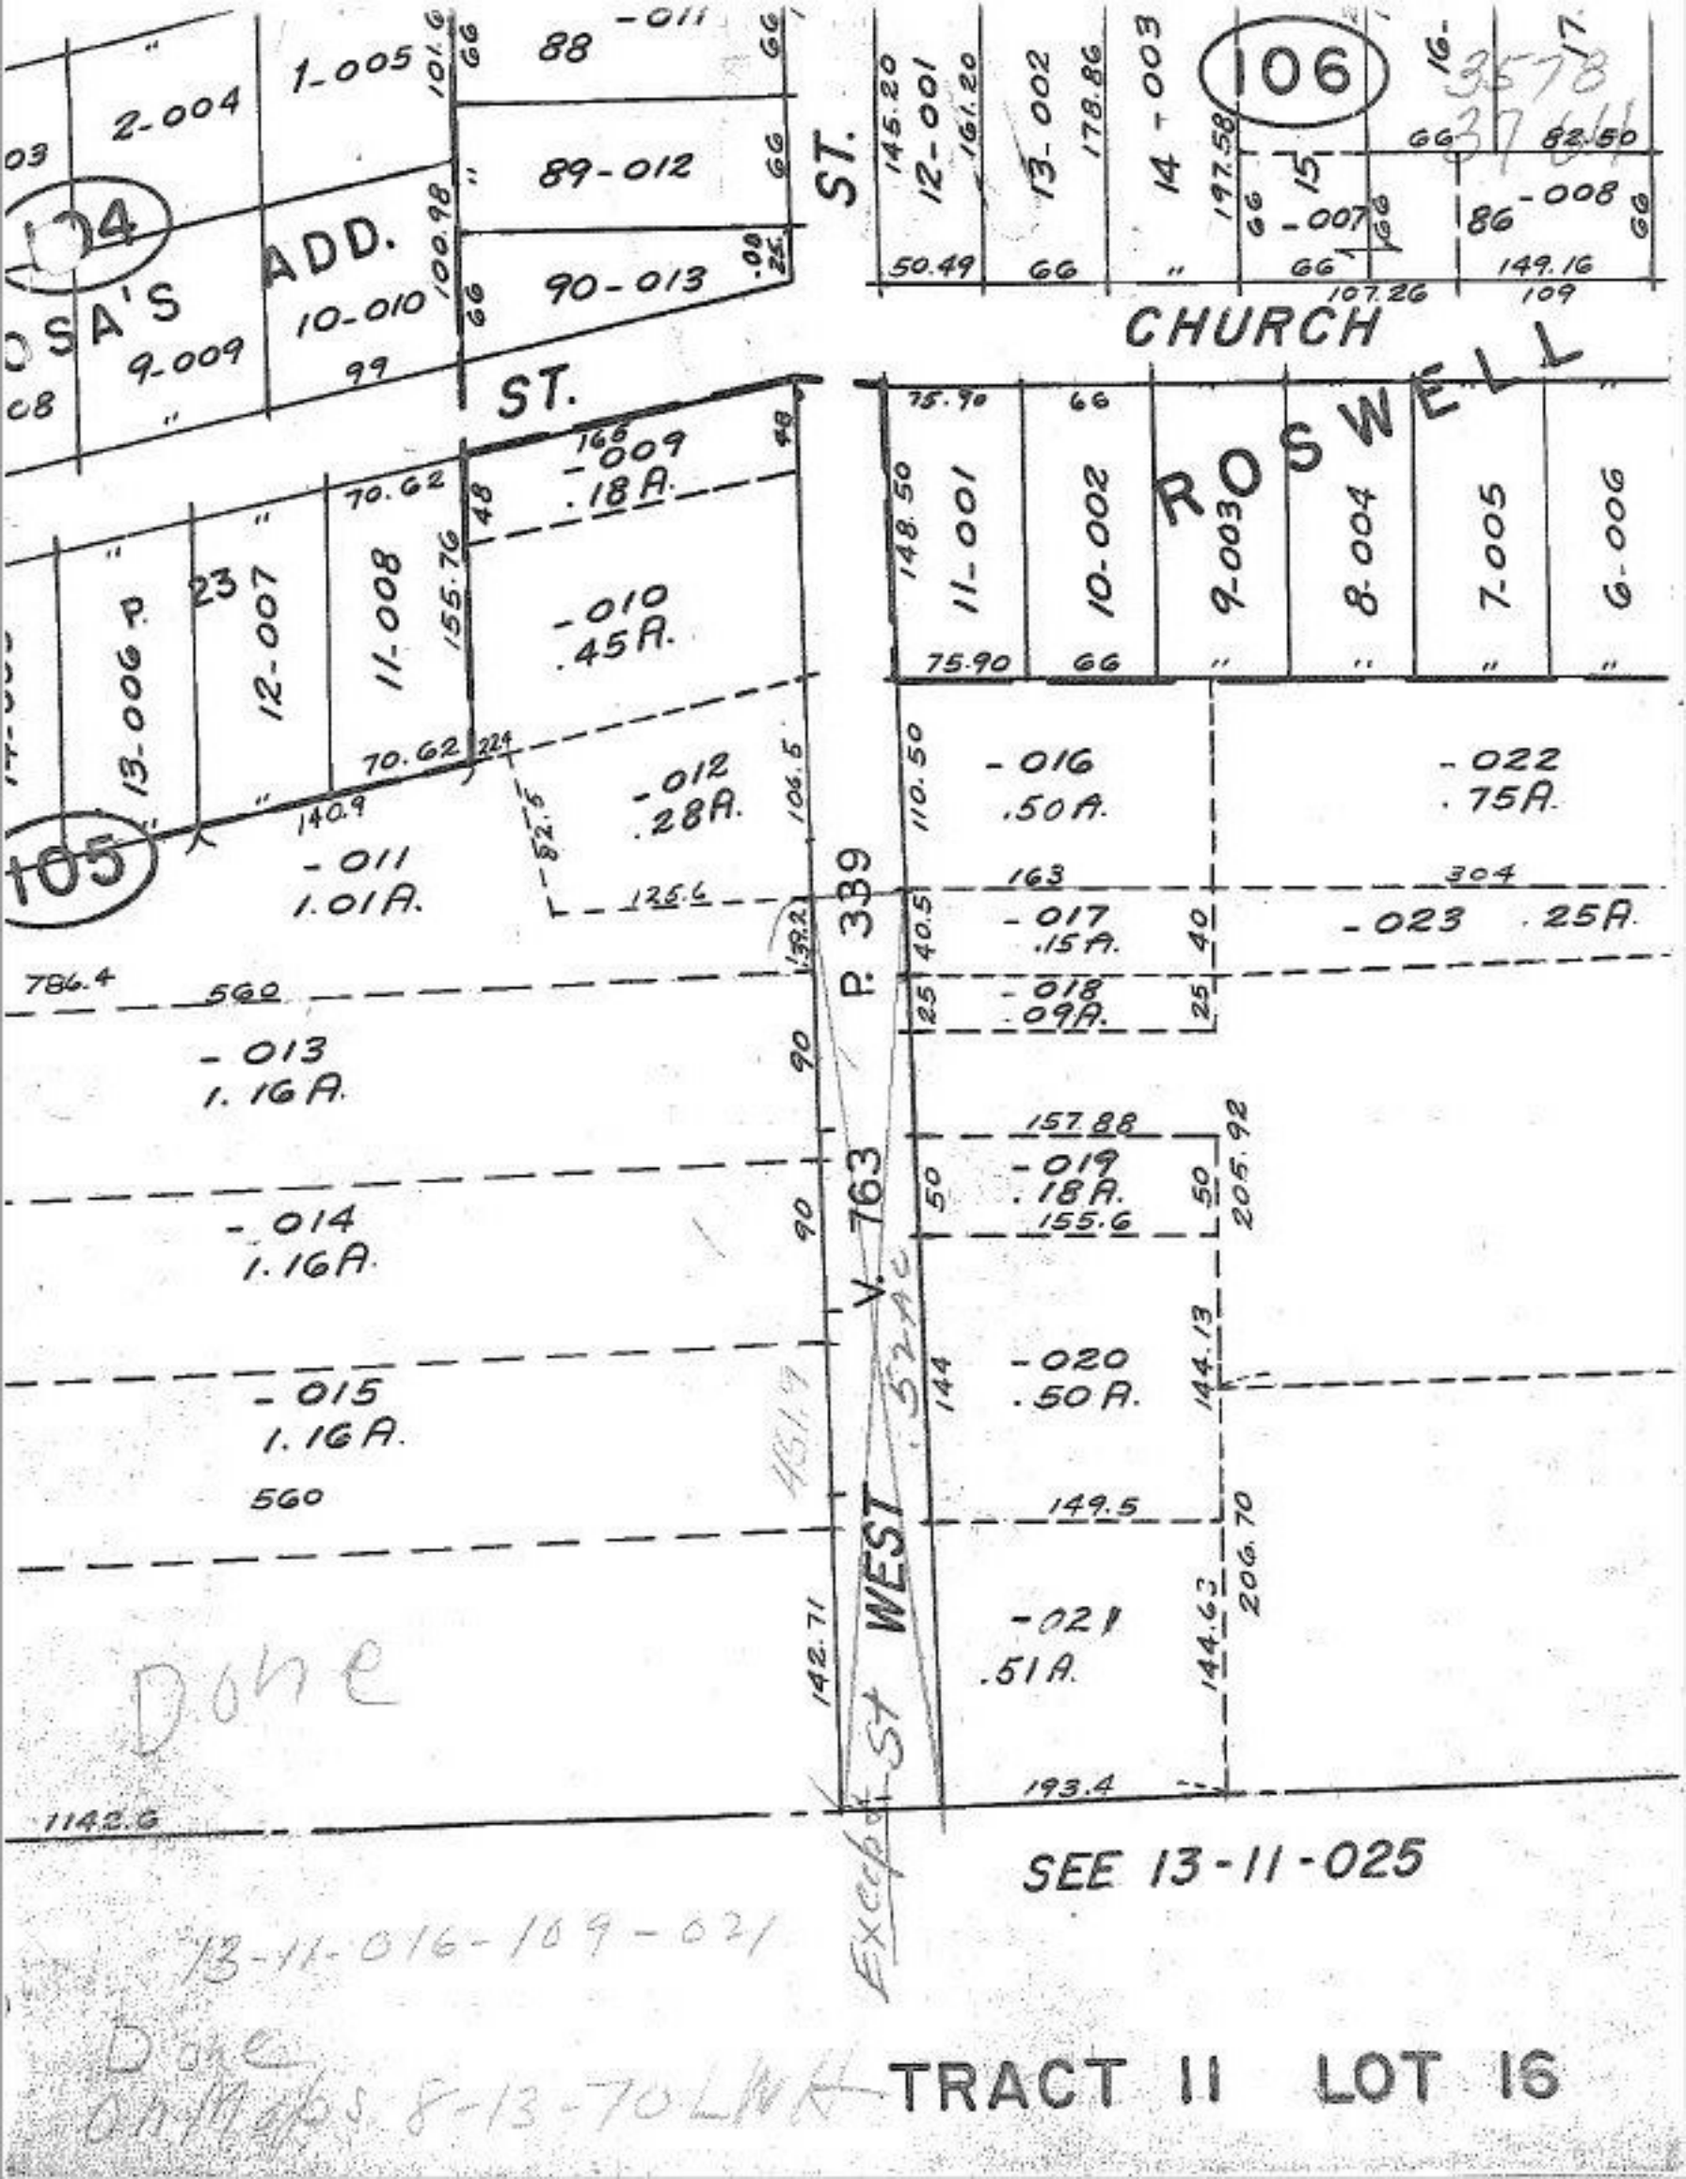
ADD.
ST.
CHURCH
ROSWELL
ST.
P. 339
V. 763
WEST
Except ST
SEE 13-11-025
Done
13-11-016-109-021
Done on Maps 8-13-70 LMH
TRACT 11 LOT 16