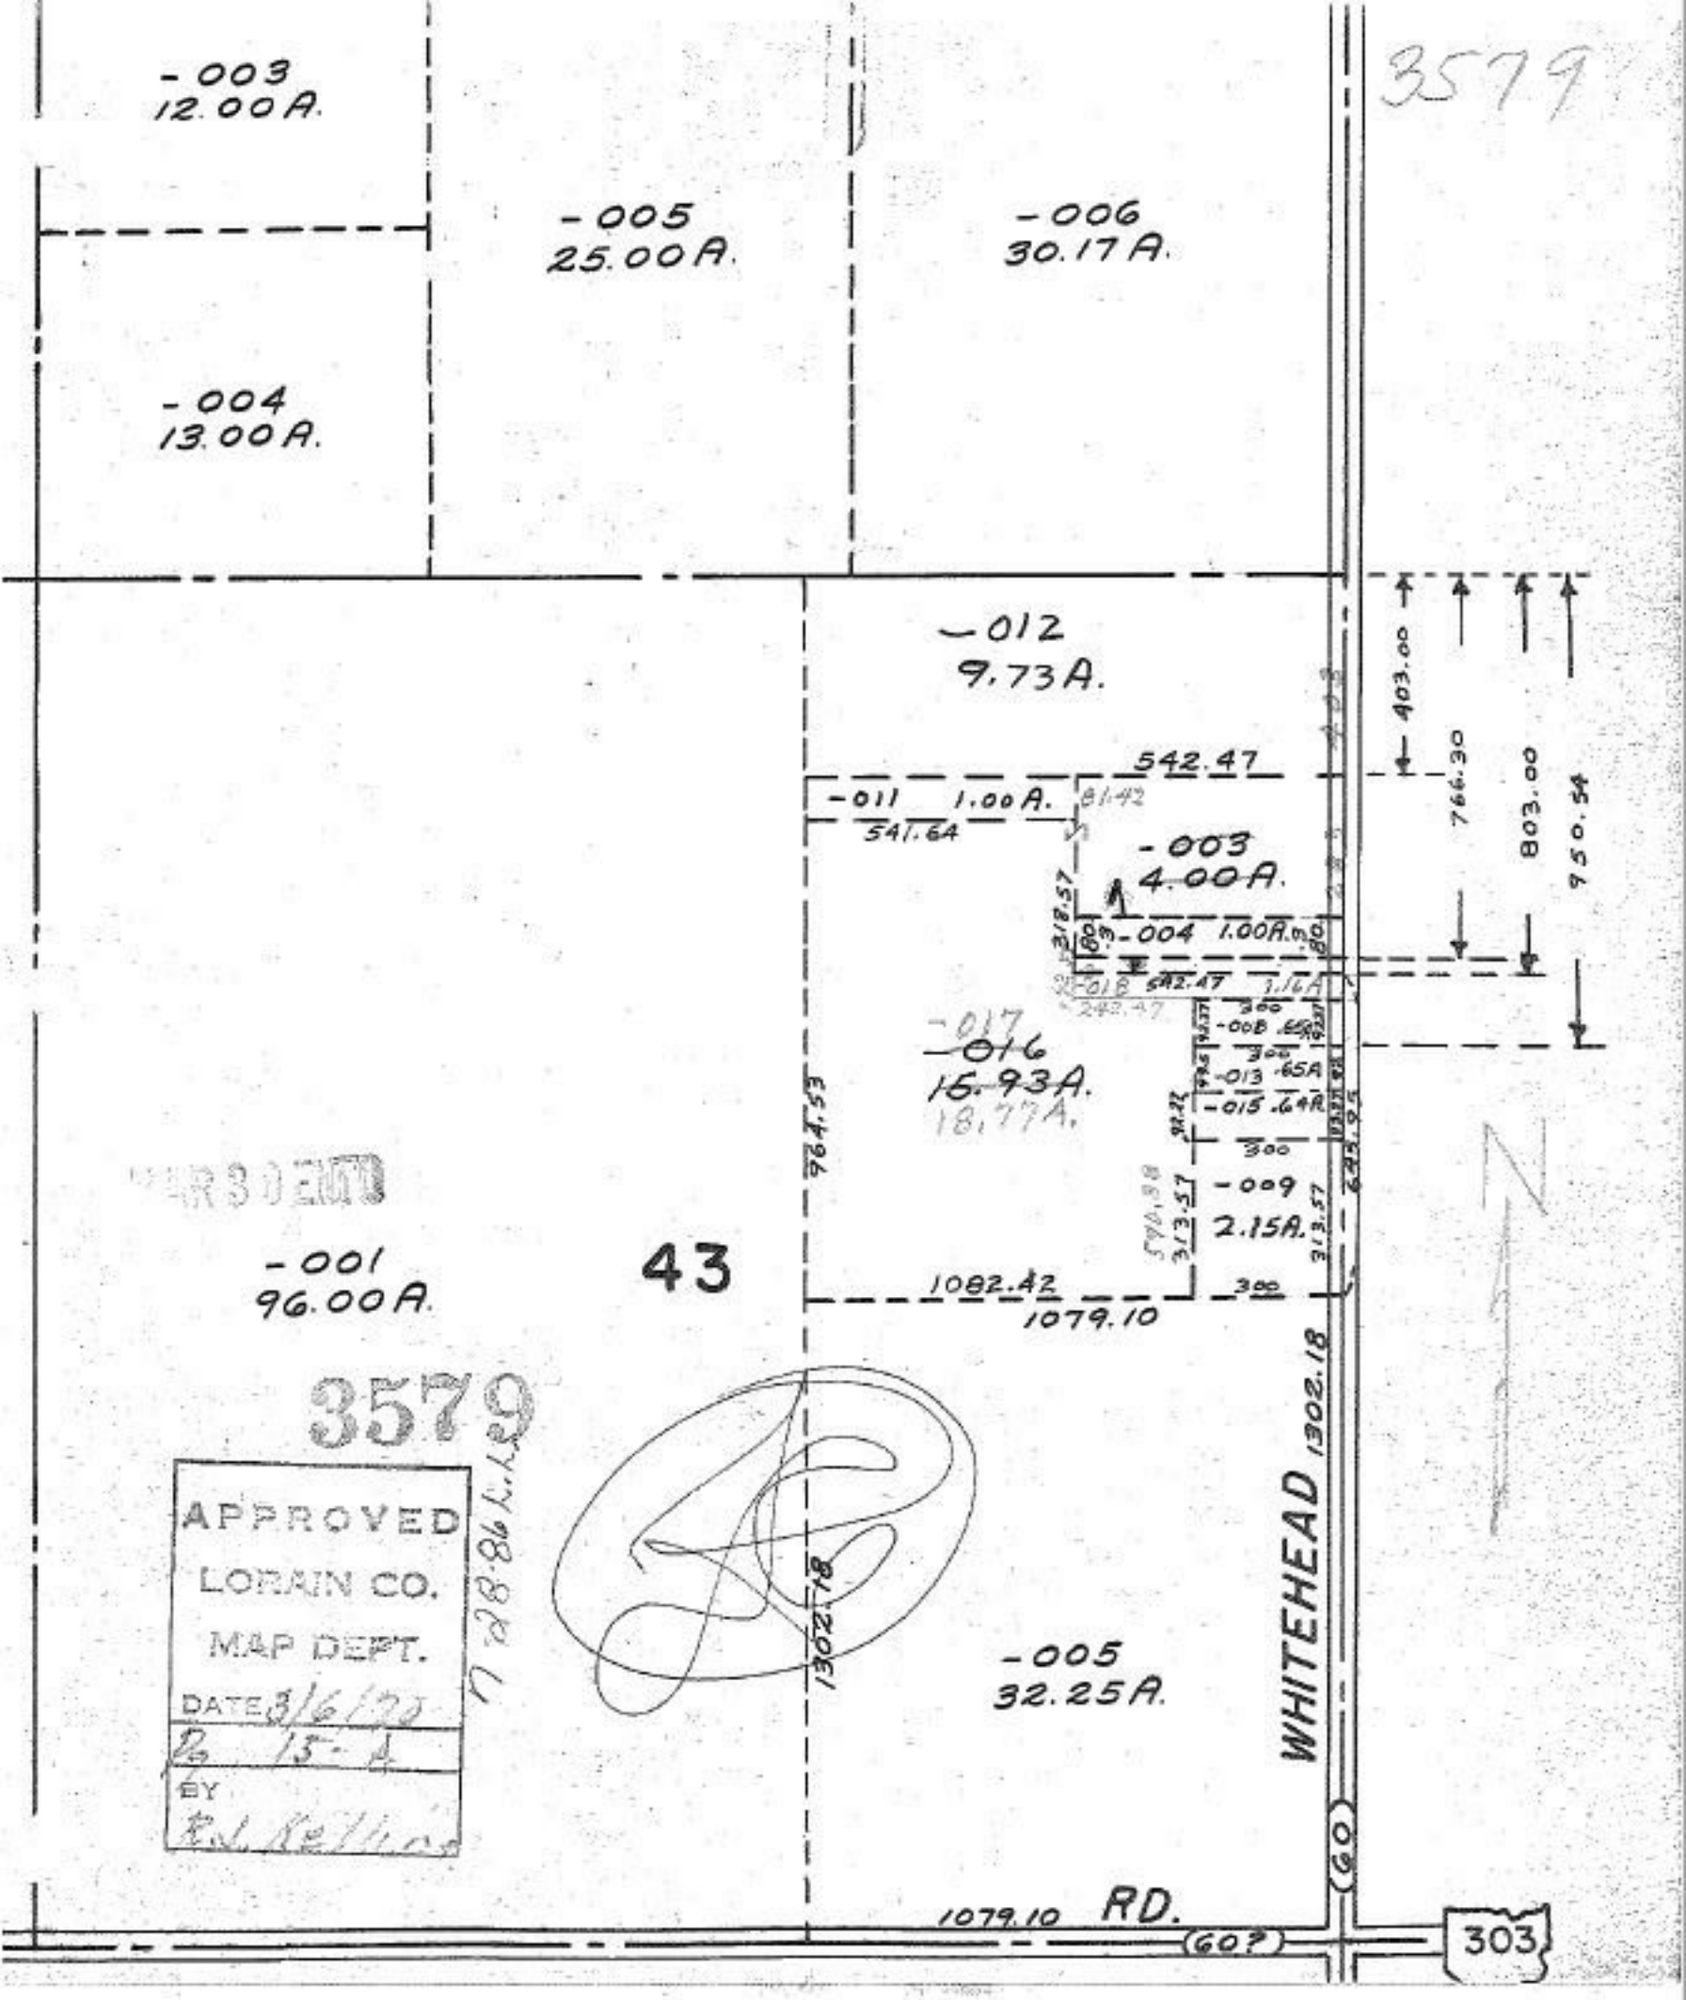
3579
-003
12.00A.
-005
25.00A.
-006
30.17A.
-004
13.00A.
-012
9.73A.
542.47
-011 1.00A.
541.64
-003
4.00A.
-004 1.00A.
-018 542.47 1.16A
-017
-016
15.93A.
18.77A.
-008 .65A
-013 .65A
-015 .64A
-009
2.15A.
964.53
313.57
1082.42
1079.10
-001
96.00A.
43
3579
APPROVED
LORAIN CO.
MAP DEPT.
DATE 3/6/70
BY
1302.18
-005
32.25A.
WHITEHEAD
1302.18
403.00
766.30
803.00
950.54
(60)
1079.10 RD.
(60?)
303