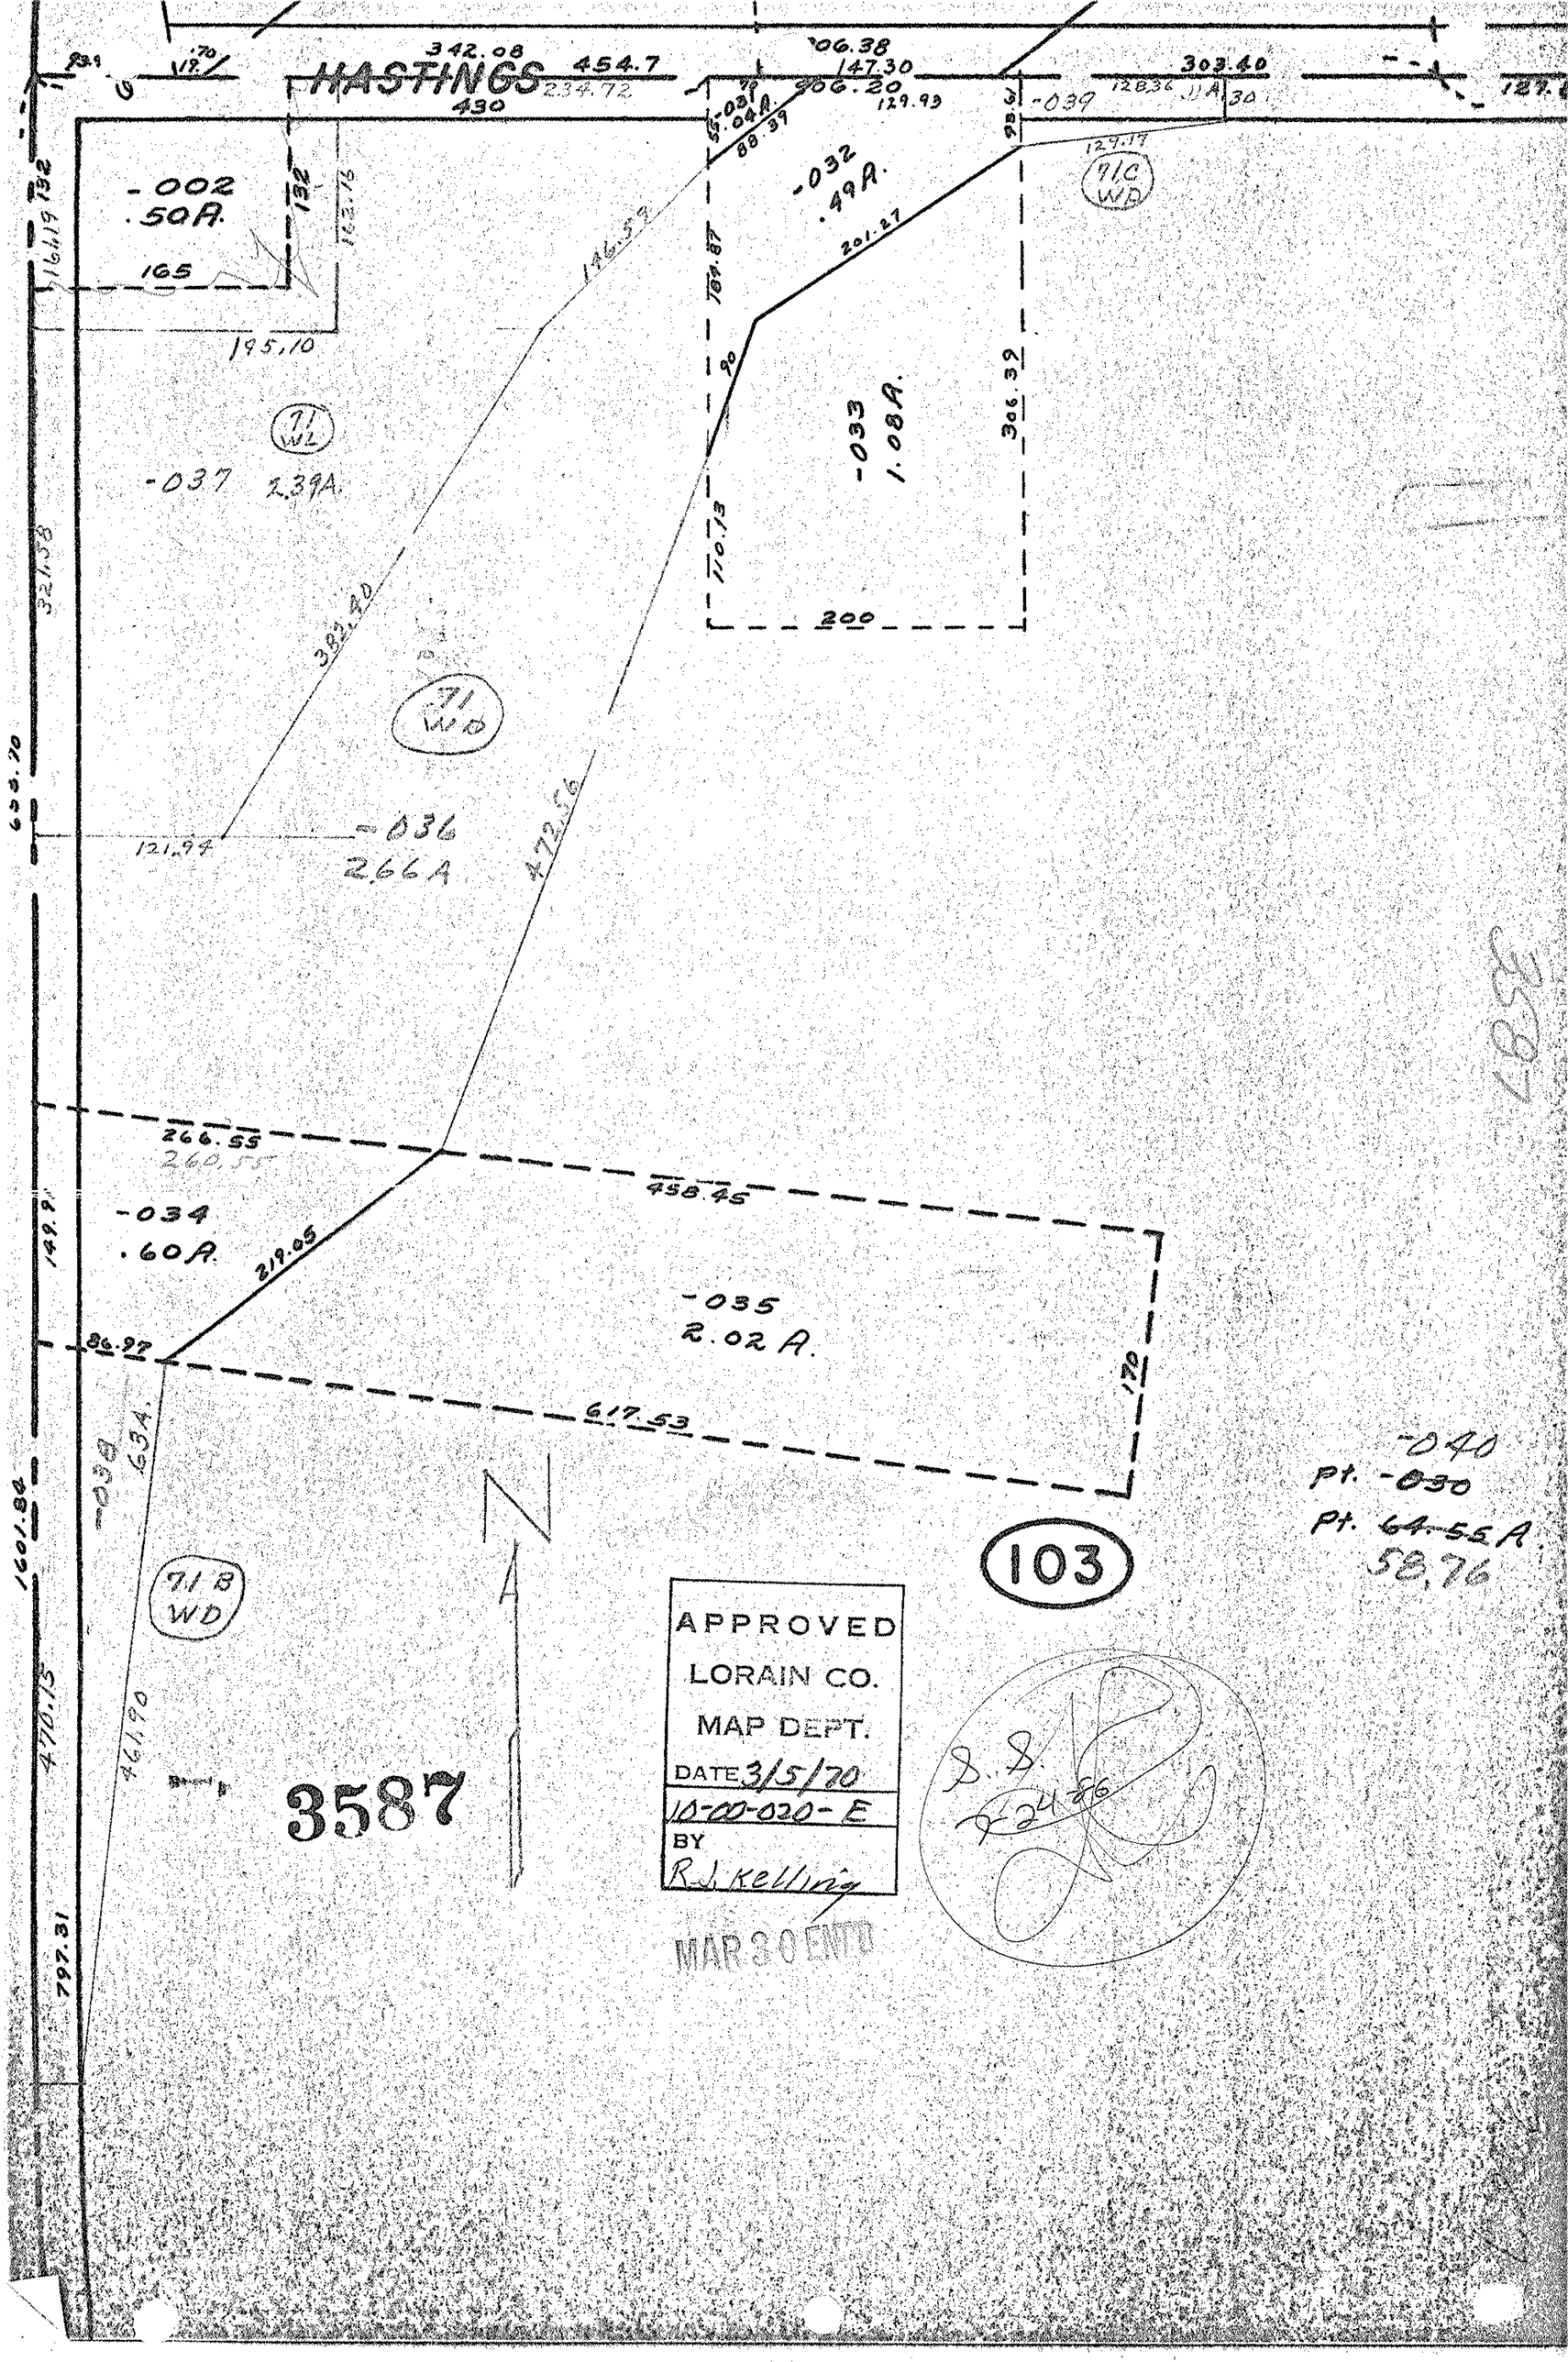
HASTINGS
342.08
454.7
234.72
430
306.38
147.30
306.20
129.93
303.40
128.36
-039
129.17
71C WD
-002
.50A.
165
132
162.16
195.10
-032
.49A.
201.27
146.59
184.87
90
-033
1.08A.
306.39
110.13
200
71 WL
-037
2.39A.
382.40
71 WD
-036
2.66A
121.94
472.56
266.55
260.55
458.45
-034
.60A.
219.05
-035
2.02 A.
86.97
617.53
170
-038
63A.
71 B WD
461.90
797.31
1601.84
321.58
633.70
149.91
470.15
-040
Pt. -030
Pt. 64.55A
58.76
103
APPROVED
LORAIN CO.
MAP DEPT.
DATE 3/5/70
10-00-020-E
BY
R.J. Kelling
MAR 30 ENT'D
3587