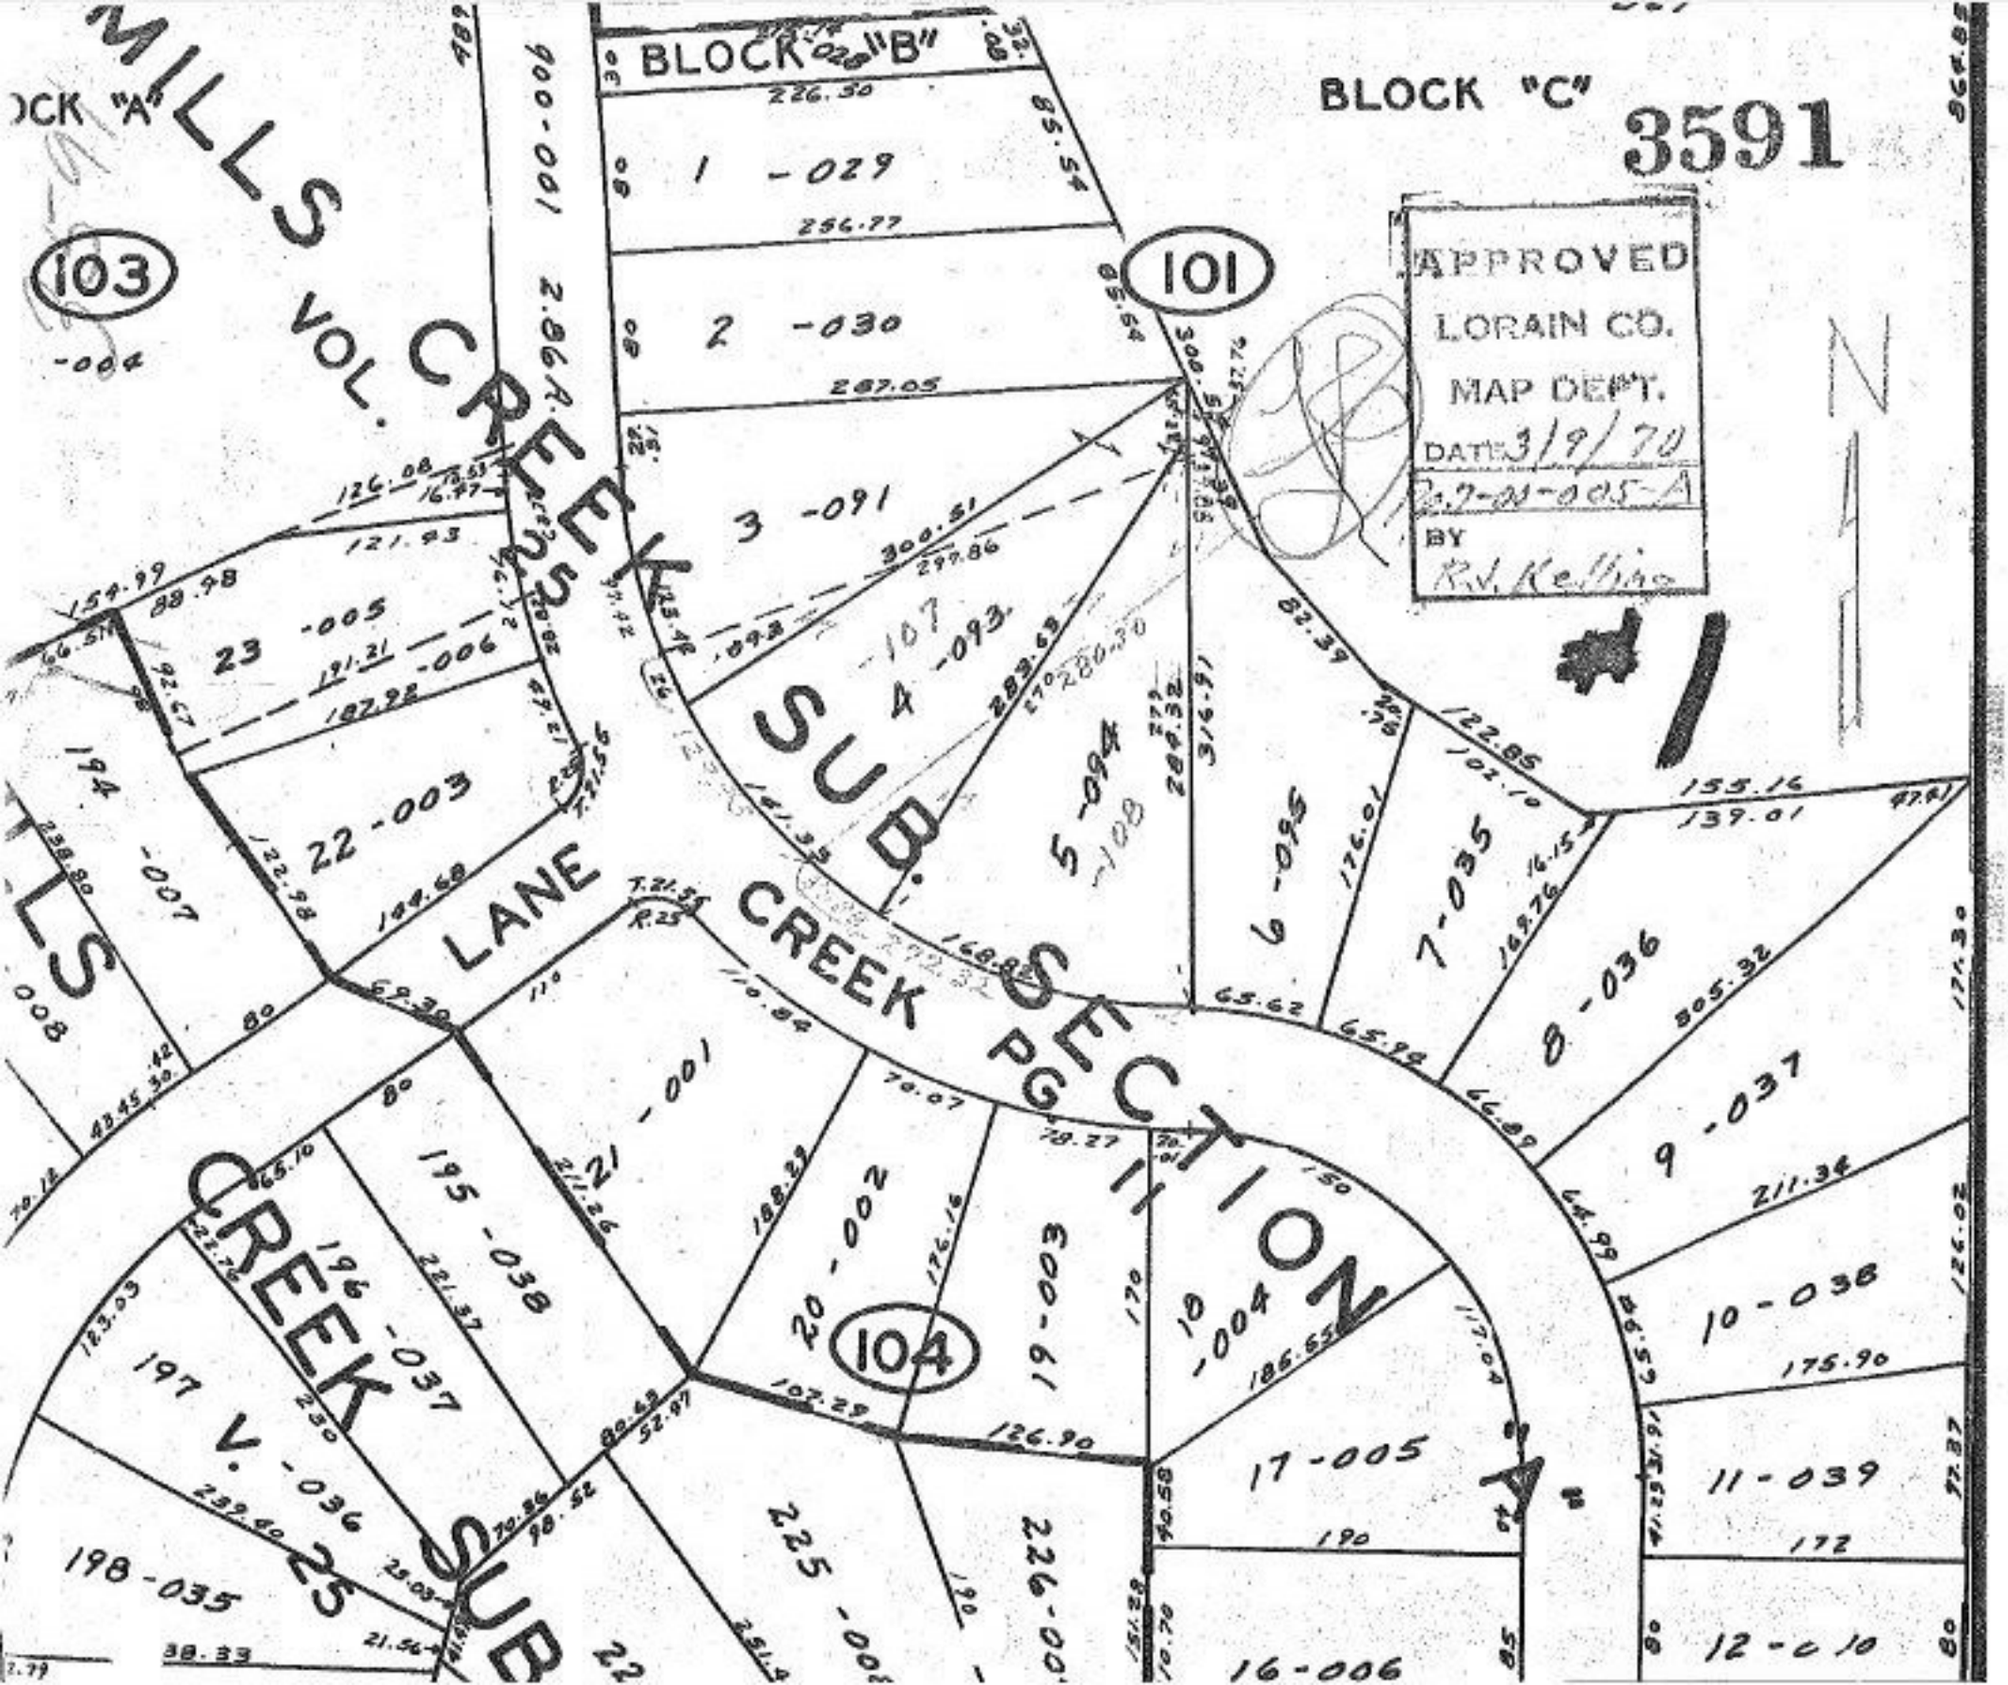
BLOCK "A"
BLOCK "B"
BLOCK "C"
3591
APPROVED
LORAIN CO.
MAP DEPT.
DATE 3/9/70
BY R.V. Kelbin
MILLS VOL.
CREEK
SUB. SECTION
LANE
CREEK
SUB
CREEK
SUB
101
103
104
1 -029
2 -030
3 -091
4 -093
5 -094
6 -095
7-035
8 -036
9 -037
10 -036
11 -039
12 -010
10 -004
17 -005
16 -006
19 -003
20 -002
21 -001
22 -003
23 -005
194 -007
195 -038
196 -037
197 V. -036
198 -035
225 -008
226 -009
N