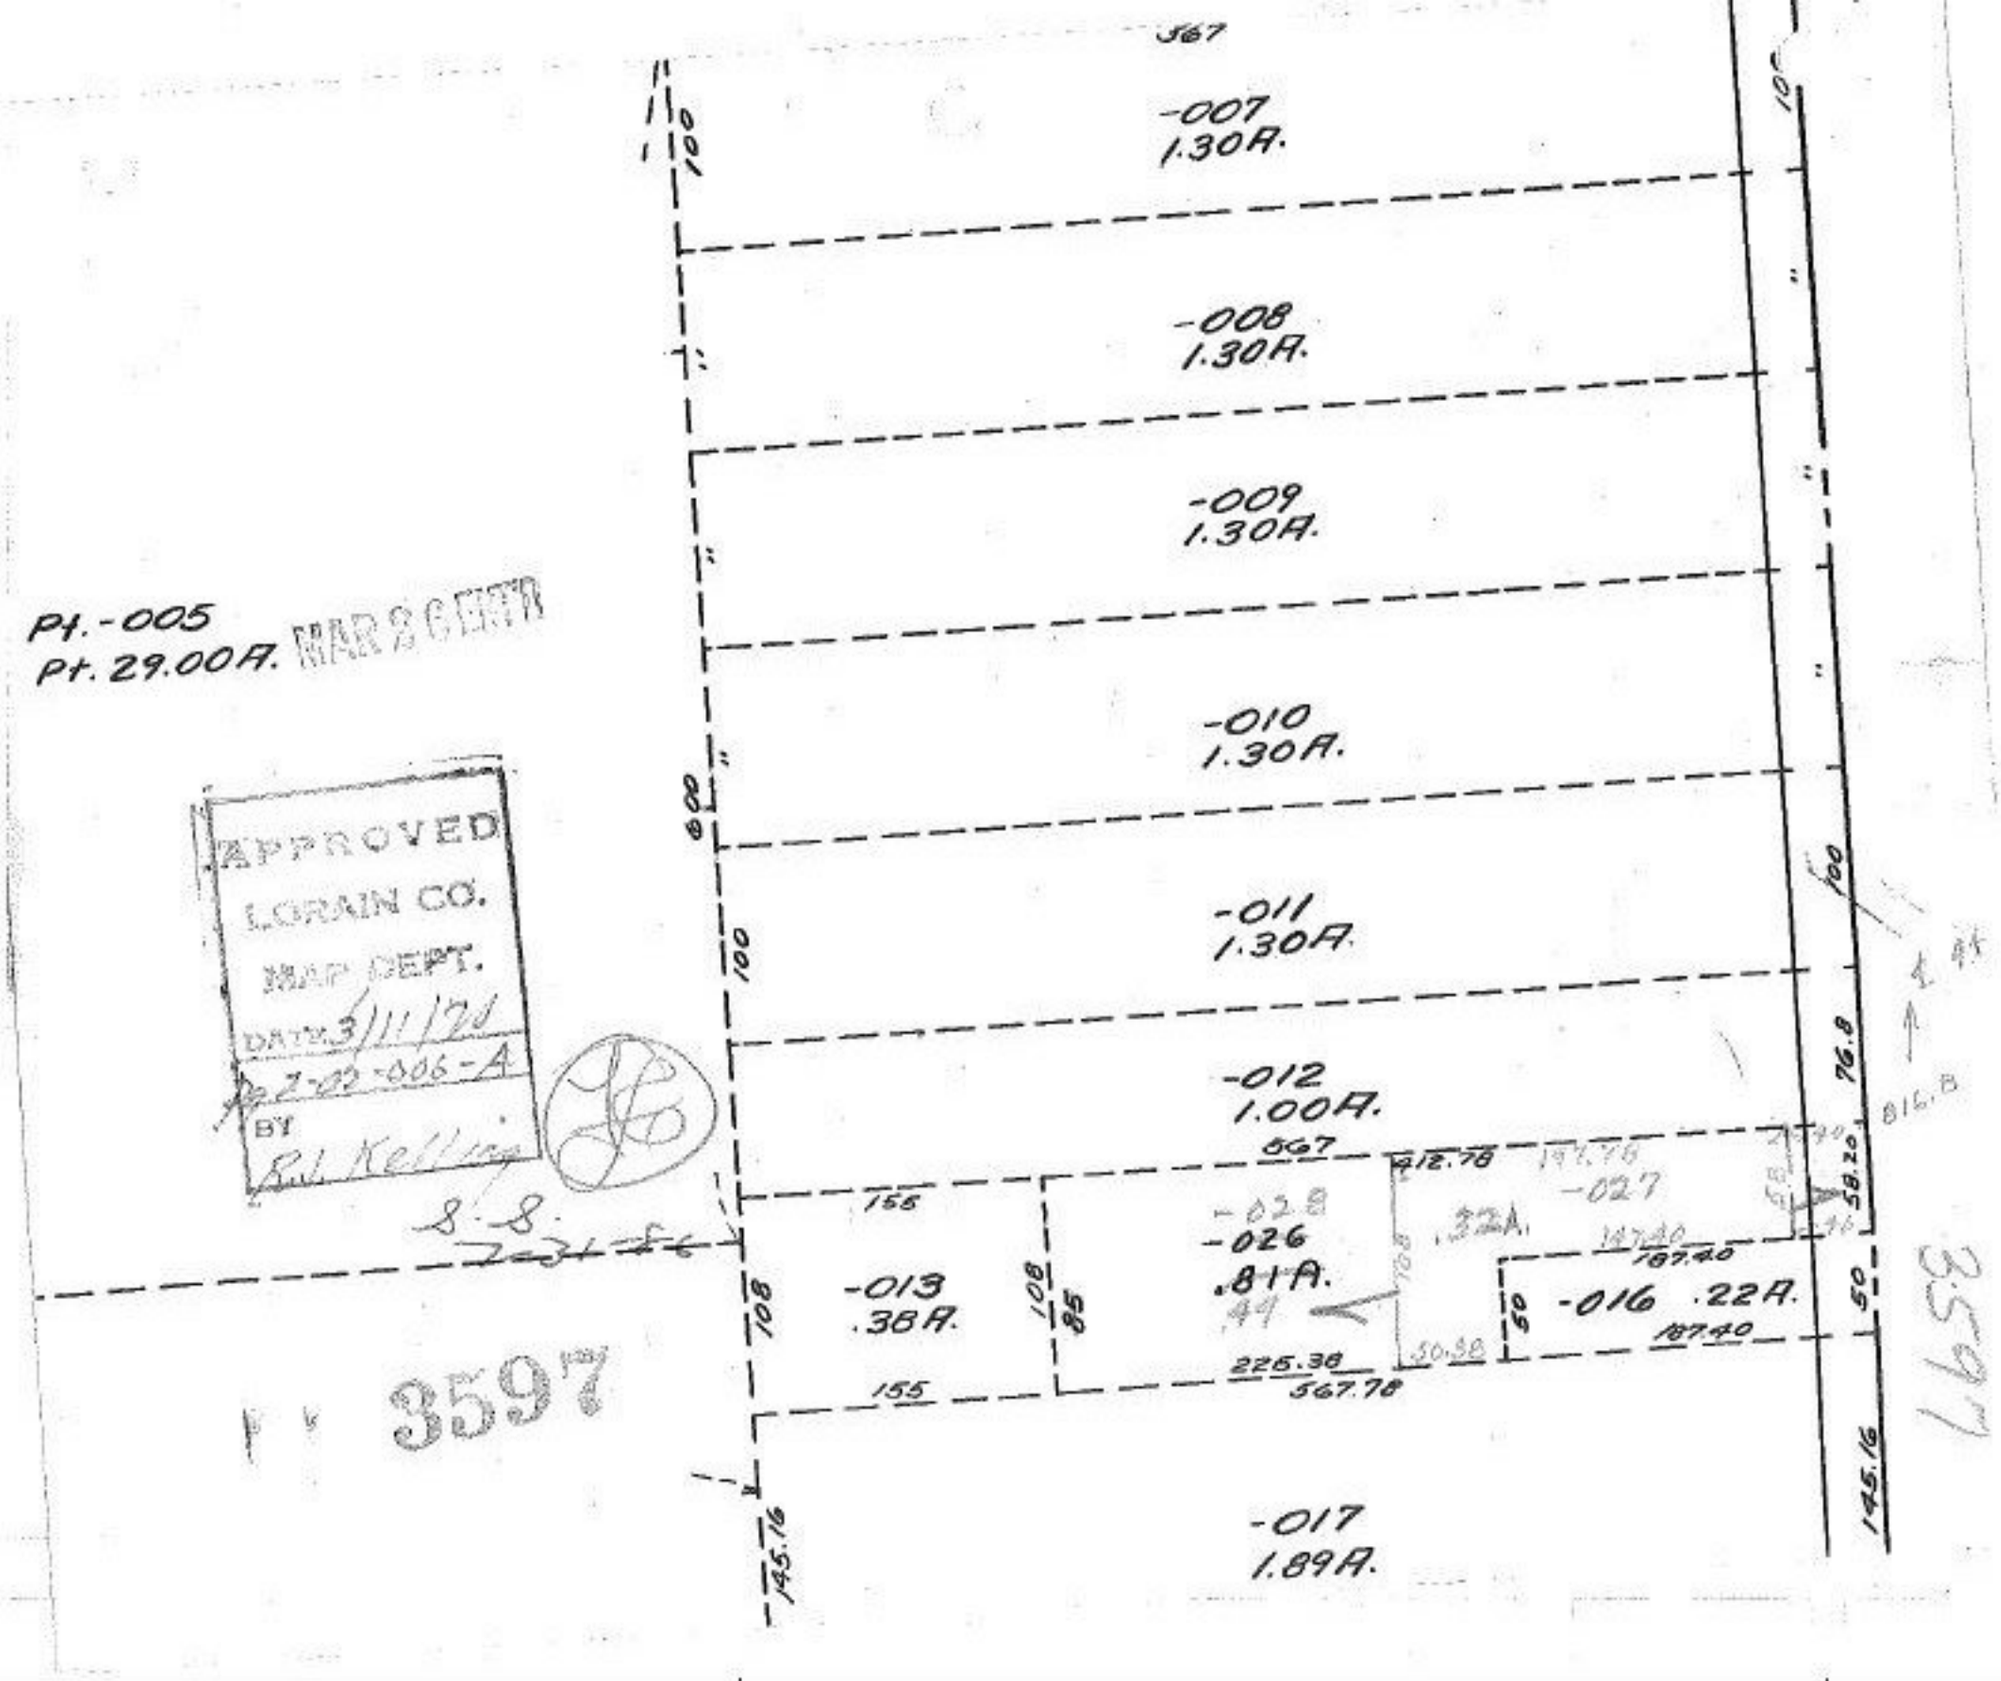

567
-007
1.30A.
-008
1.30A.
-009
1.30A.
-010
1.30A.
-011
1.30A.
-012
1.00A.
567
412.78
-027
.32A.
-028
-026
.81A.
.44
-013
.38A.
-016
.22A.
187.40
225.38
567.78
155
108
85
50
76.8
58.20
145.16
-017
1.89A.
Pt.-005
Pt. 29.00A.
MAR 26 ENTR
APPROVED
LORAIN CO.
MAP DEPT.
DATE 3/11/70
BY
3597