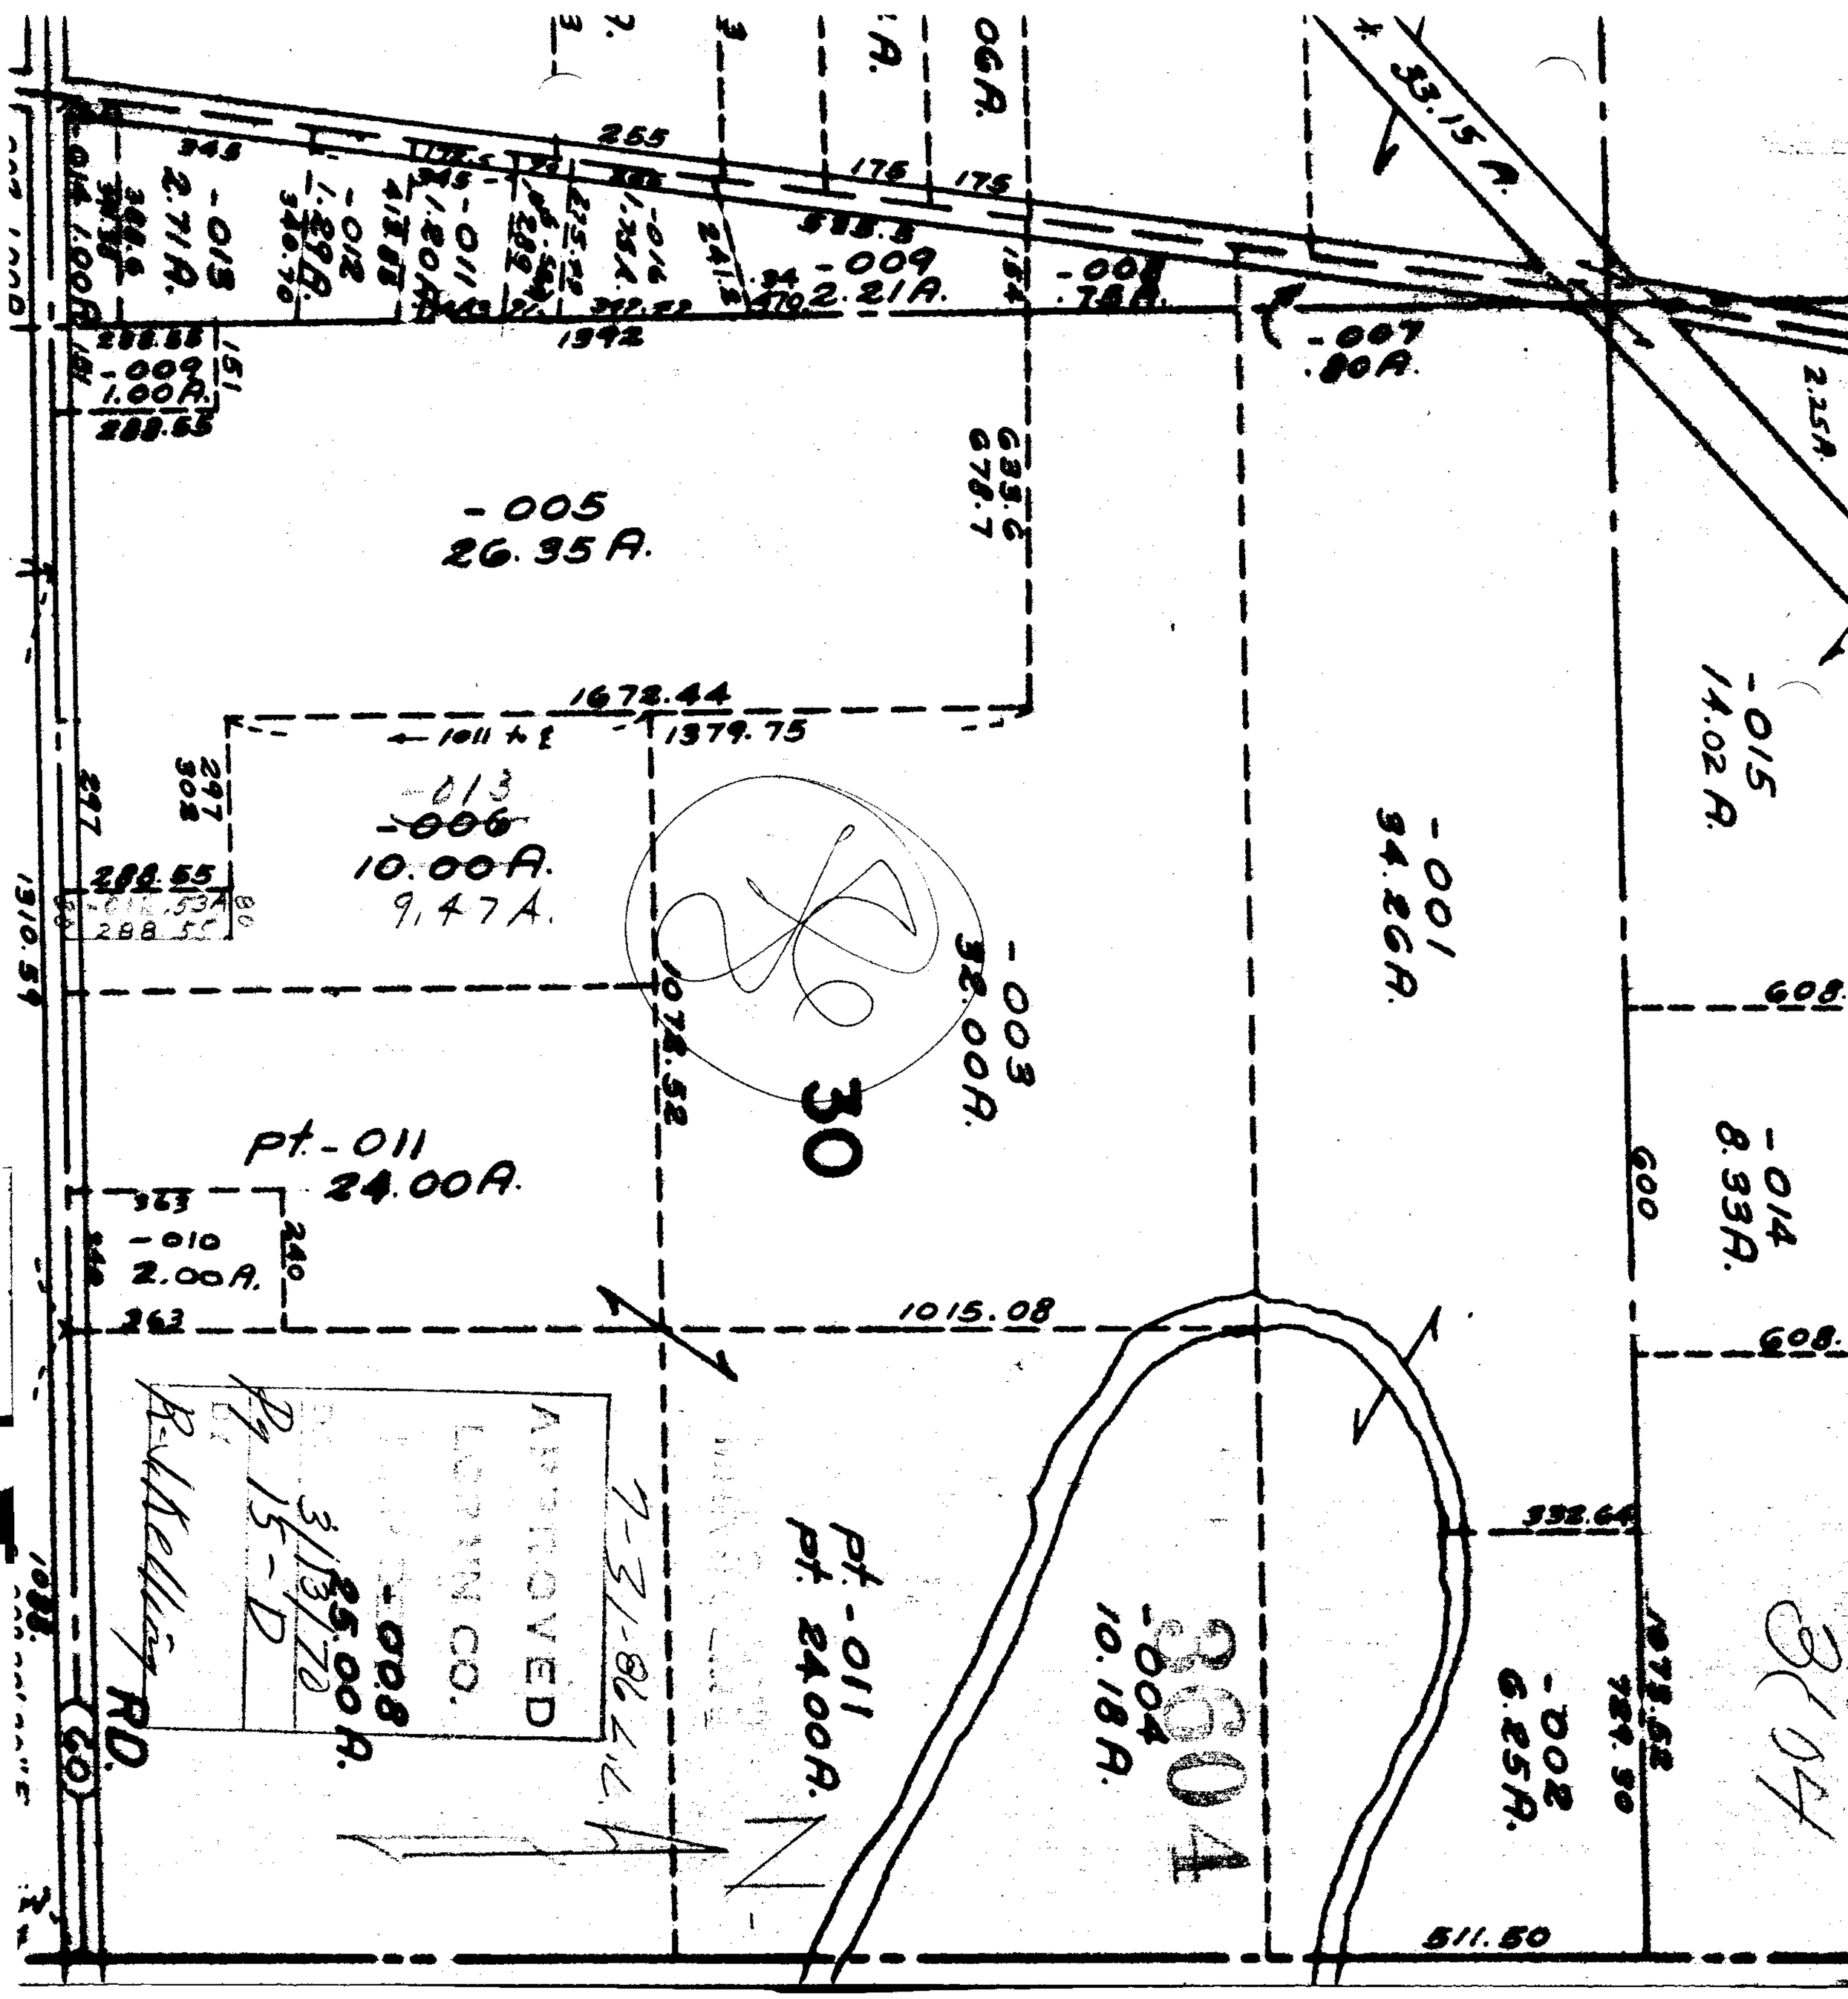

-005
26.35 A.
-009
2.21 A.
-008
.78 A.
-007
.80 A.
-009
1.00 A.
-013
2.71 A.
-012
1.29 A.
-011
1.20 A.
-016
1.75 A.
33.15 A.
2.25 A.
-015
14.02 A.
-001
34.26 A.
-003
32.00 A.
-013
~~-006~~
10.00 A.
9.47 A.
pt.-011
24.00 A.
-010
2.00 A.
-014
8.33 A.
-002
6.25 A.
-004
10.18 A.
pt.-011
pt. 24.00 A.
-008
25.00 A.
1672.44
1379.75
1015.08
1072.52
1073.52
1310.59
1392
255
175
608
600
332.64
511.50
RD.
30
3604
APPROVED
LORAIN CO.