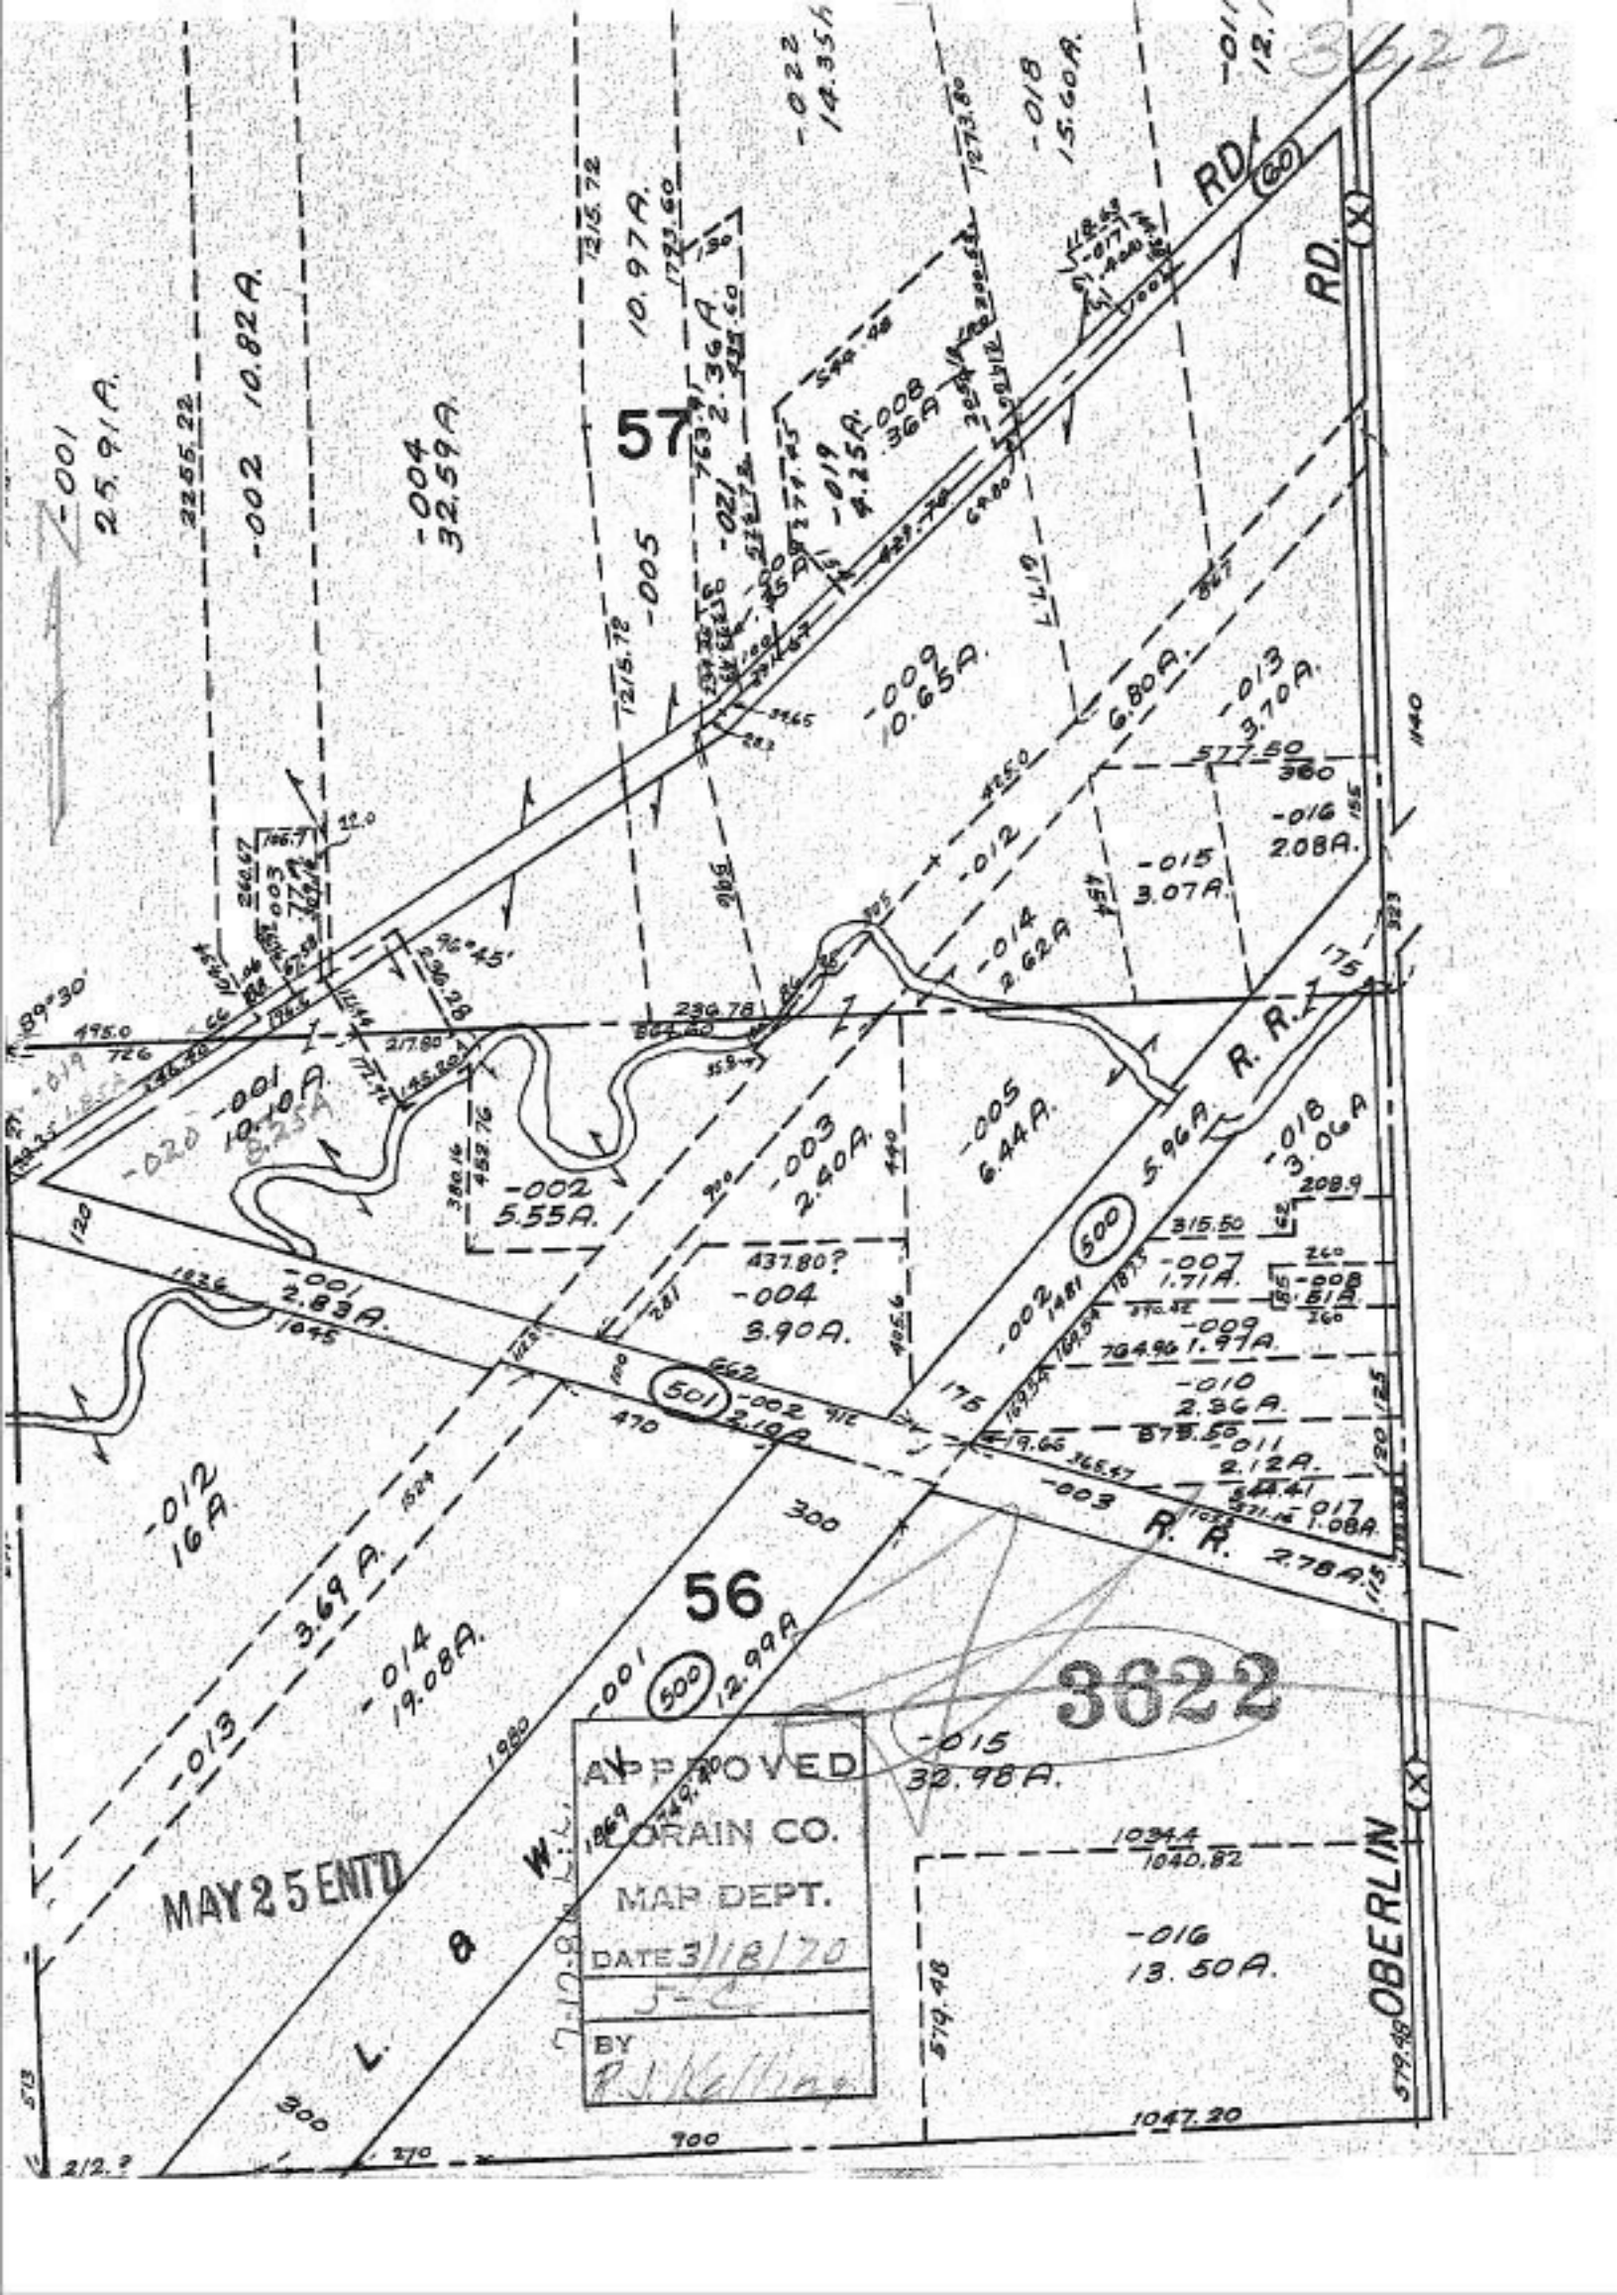
3822
57
56
RD.
RD.
R. R.
R. R.
OBERLIN
APPROVED
LORAIN CO.
MAP DEPT.
DATE 3/18/70
BY
MAY 25 ENTD
-001 25.91A.
-002 10.82A.
-004 32.59A.
-005 10.97A.
-009 10.65A.
-013 3.70A.
-016 2.08A.
-015 3.07A.
-012 6.80A.
-014 2.62A.
-020 -001 10.10A. 8.35A
-002 5.55A.
-003 2.40A.
-005 6.44A.
5.96A.
-018 3.06A
-001 2.83A.
-004 3.90A.
-002 2.19A.
-012 16A.
-013 3.69A.
-014 19.08A.
-001 12.99A.
-015 32.98A.
-016 13.50A.
-007 1.71A.
-009 1.97A.
-010 2.36A.
-011 2.12A.
-017 1.08A.
2.78A.