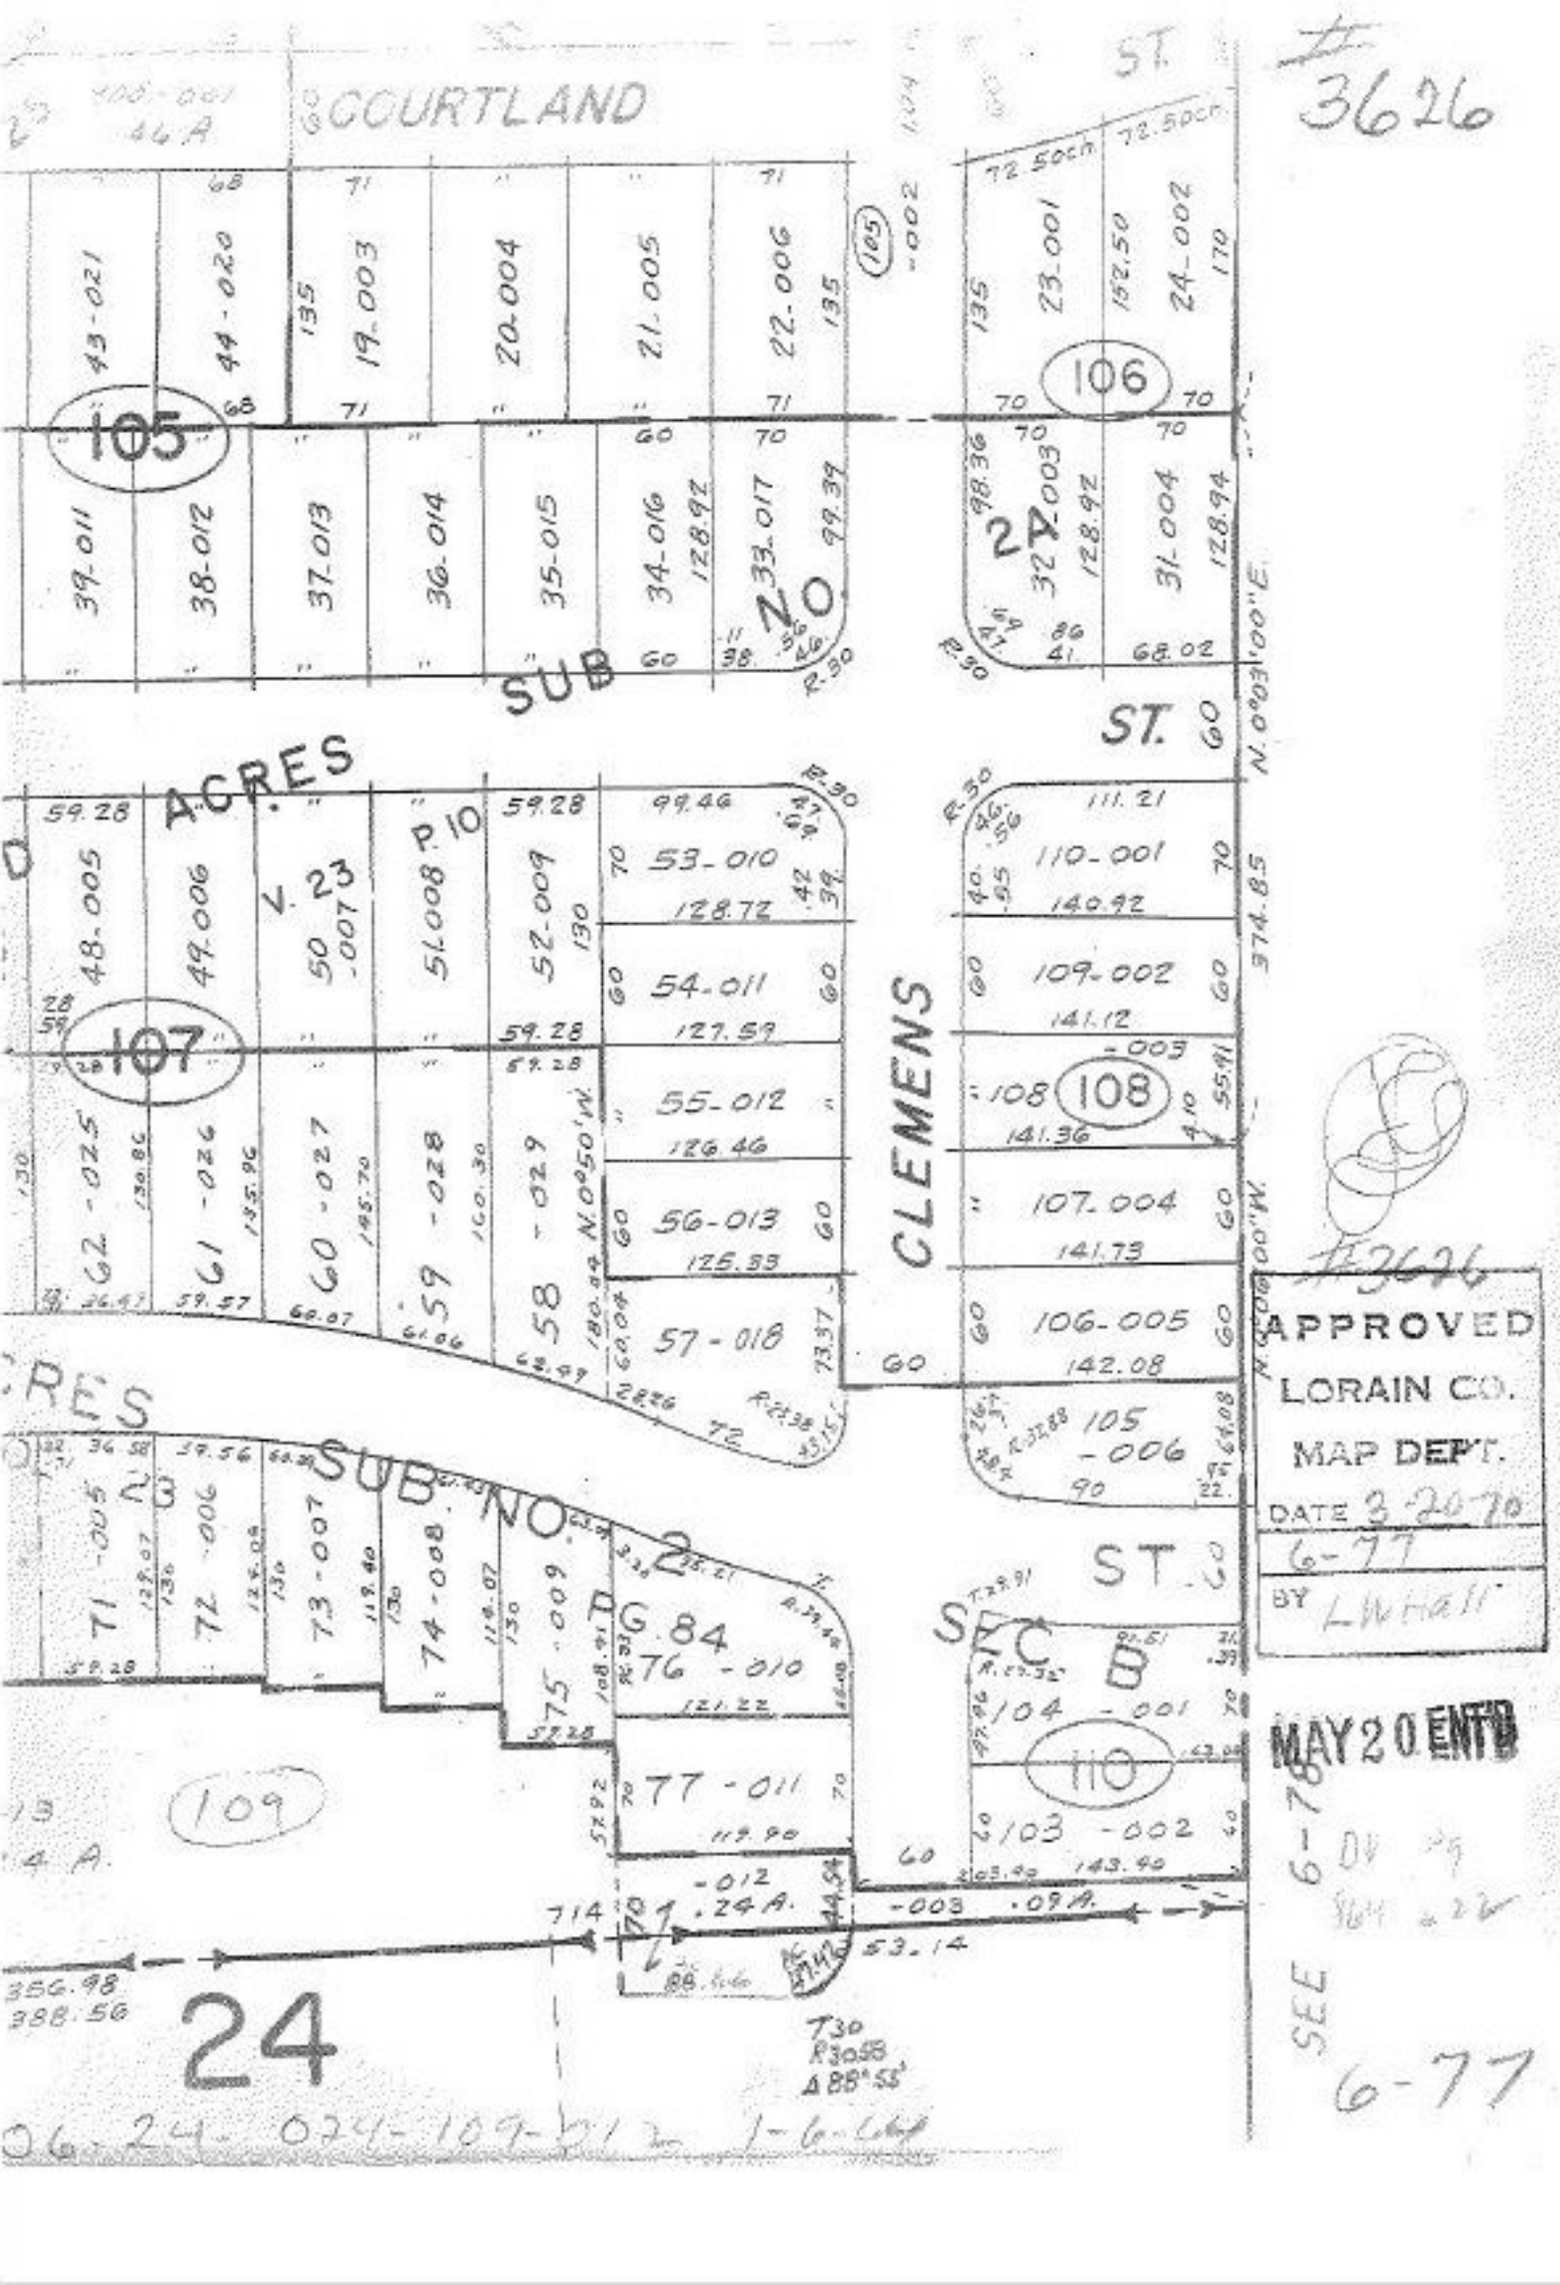
COURTLAND
ST.
SUB
ACRES
CLEMENS
SUB NO 2
SEC B
ST.
105
106
107
108
109
110
APPROVED
LORAIN CO.
MAP DEPT.
DATE 3-20-70
6-77
BY LWHall
MAY 20 ENTD
SEE 6-77
24
T30
R30S8
Δ 88° 55'