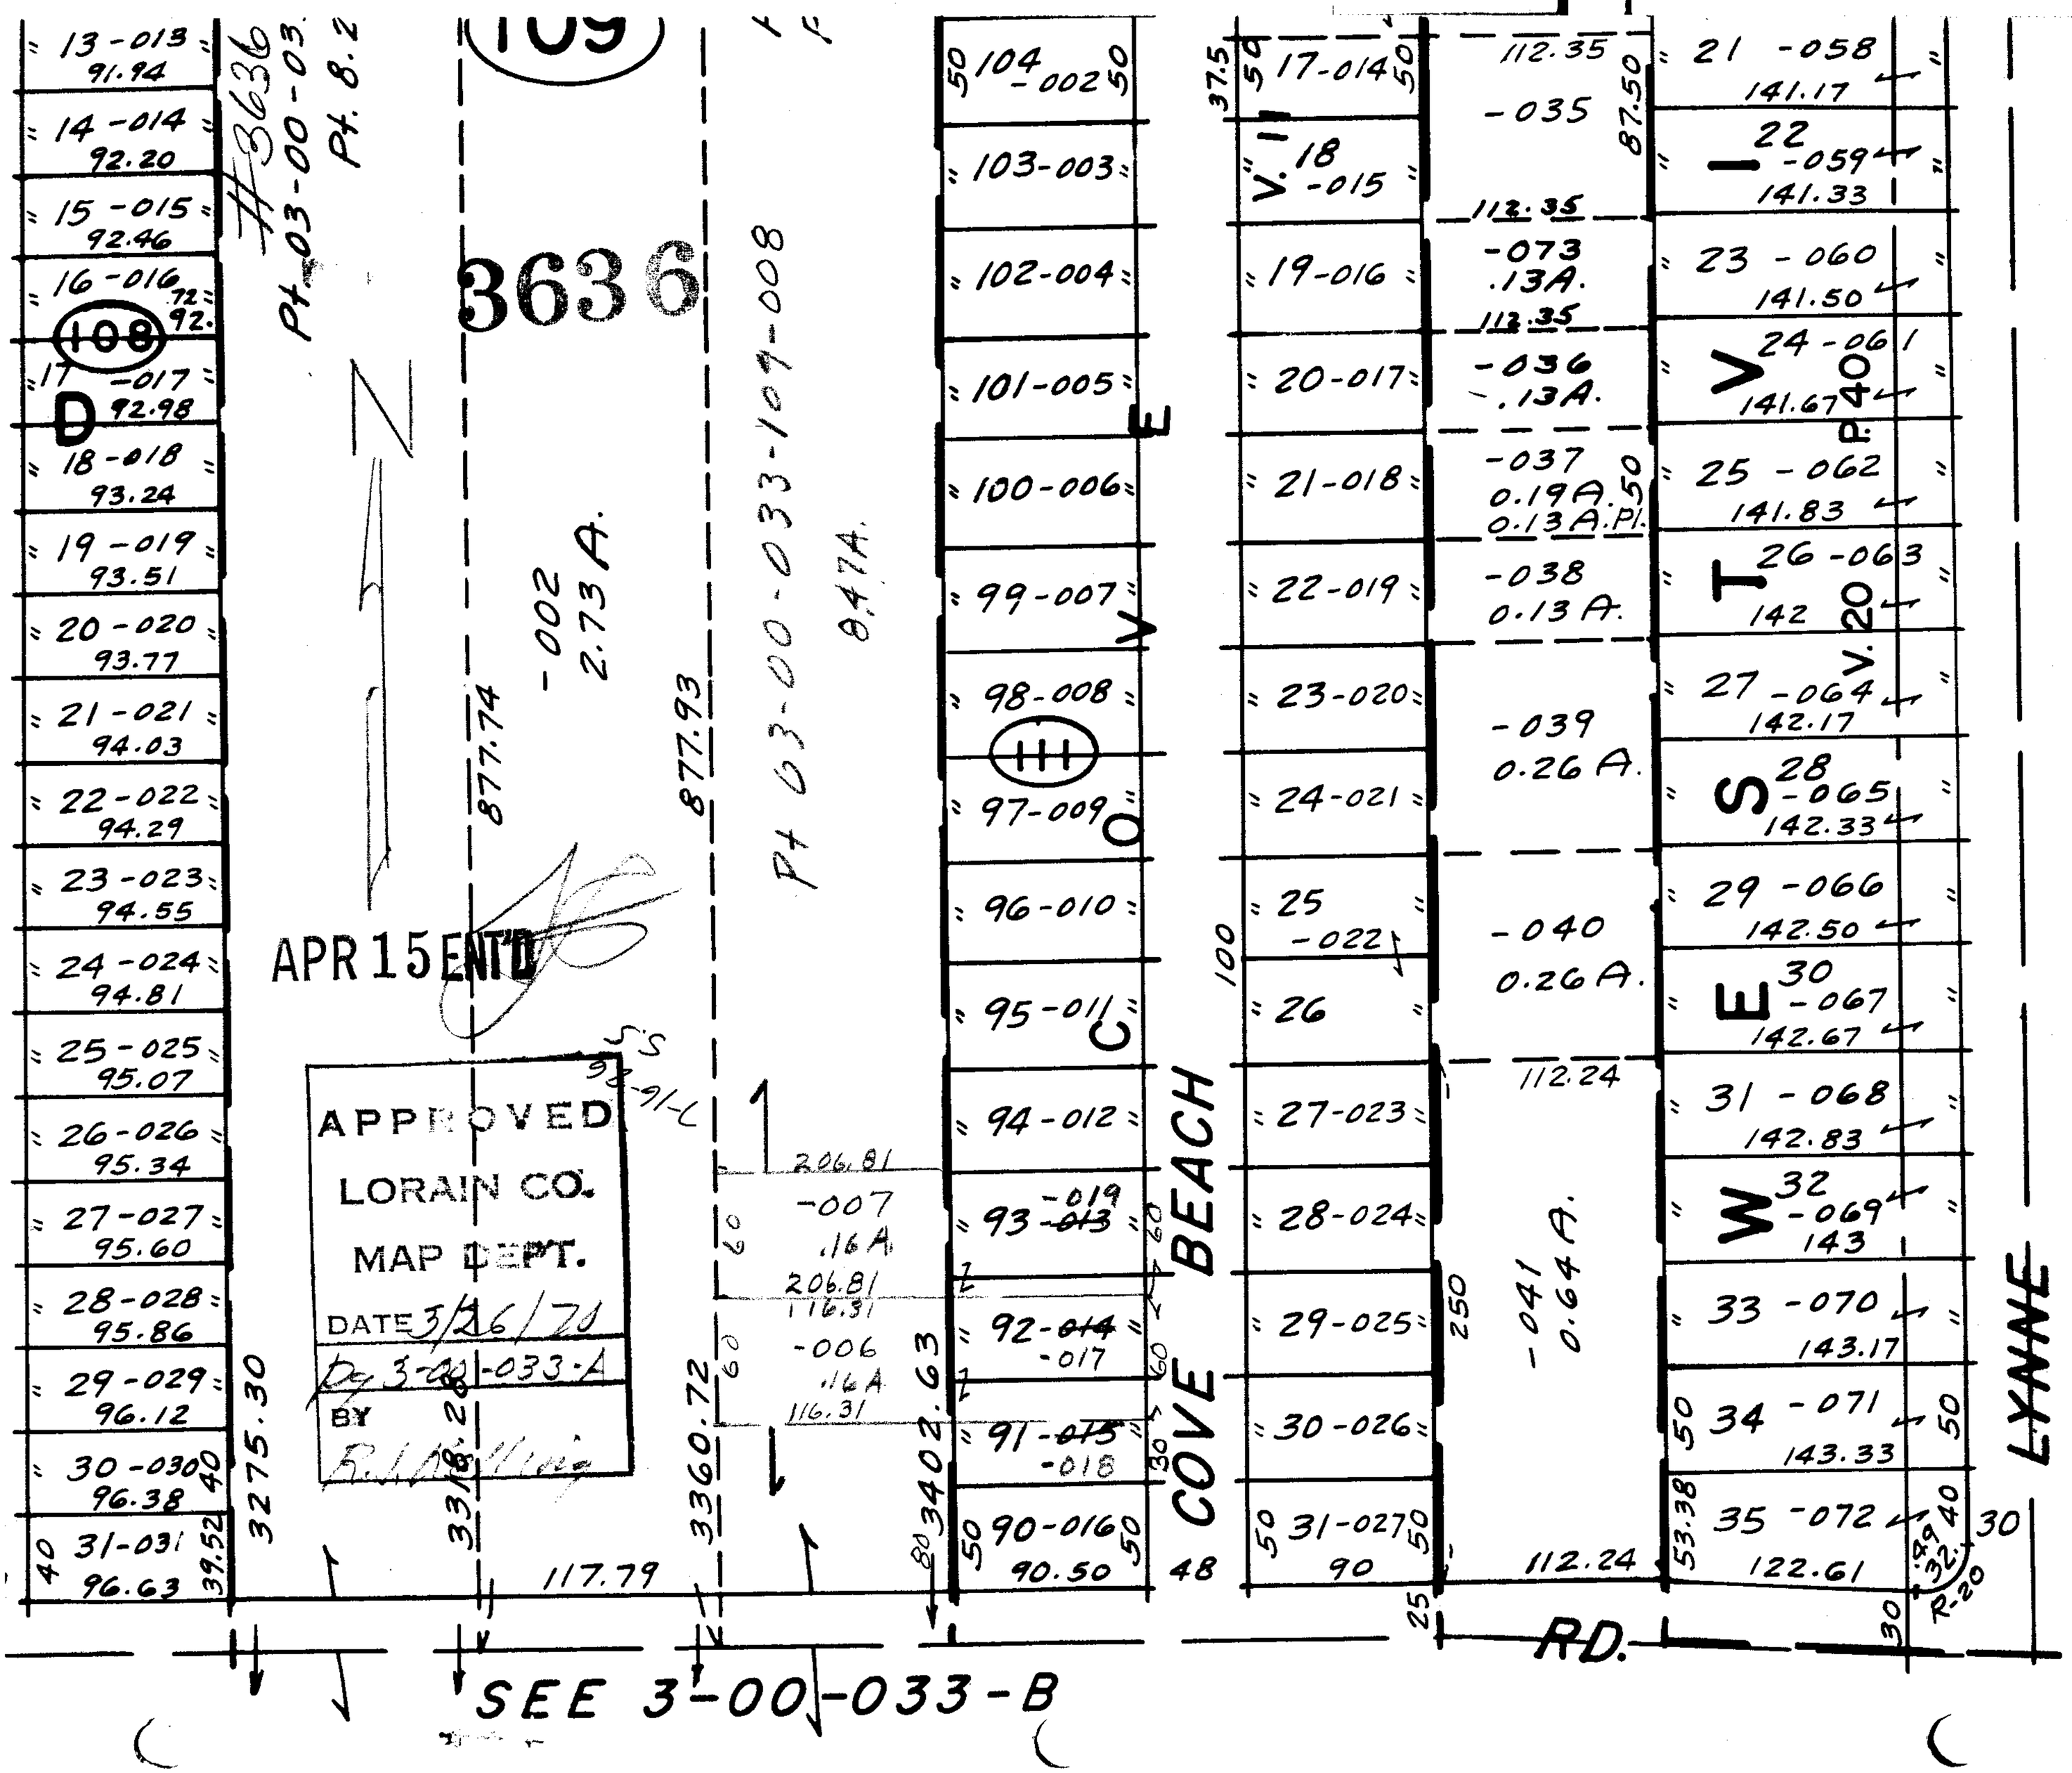

109
3636
#3636
Pt. 03-00-03
Pt. 8.2
Pt 03-00-033-109-008
8.47A.
-002
2.73 A.
877.74
877.93
APR 15 ENT'D
APPROVED
LORAIN CO.
MAP DEPT.
DATE 3/26/70
BY
3275.30
3318.28
3360.72
3402.63
117.79
206.81
-007
.16A
206.81
116.31
-006
.16A
116.31
104-002
103-003
102-004
101-005
100-006
99-007
98-008
97-009
96-010
95-011
94-012
93-019
92-017
91-018
90-016
90.50
17-014
18-015
19-016
20-017
21-018
22-019
23-020
24-021
25-022
26
27-023
28-024
29-025
30-026
31-027
90
112.35
-035
112.35
-073
.13A.
112.35
-036
.13A.
-037
0.19A.
0.13A.Pl.
-038
0.13 A.
-039
0.26 A.
-040
0.26 A.
112.24
-041
0.64 A.
112.24
21-058
141.17
22-059
141.33
23-060
141.50
24-061
141.67
25-062
141.83
26-063
142
27-064
142.17
28-065
142.33
29-066
142.50
30-067
142.67
31-068
142.83
32-069
143
33-070
143.17
34-071
143.33
35-072
122.61
COVE BEACH
LYNNE
RD.
SEE 3-00-033-B