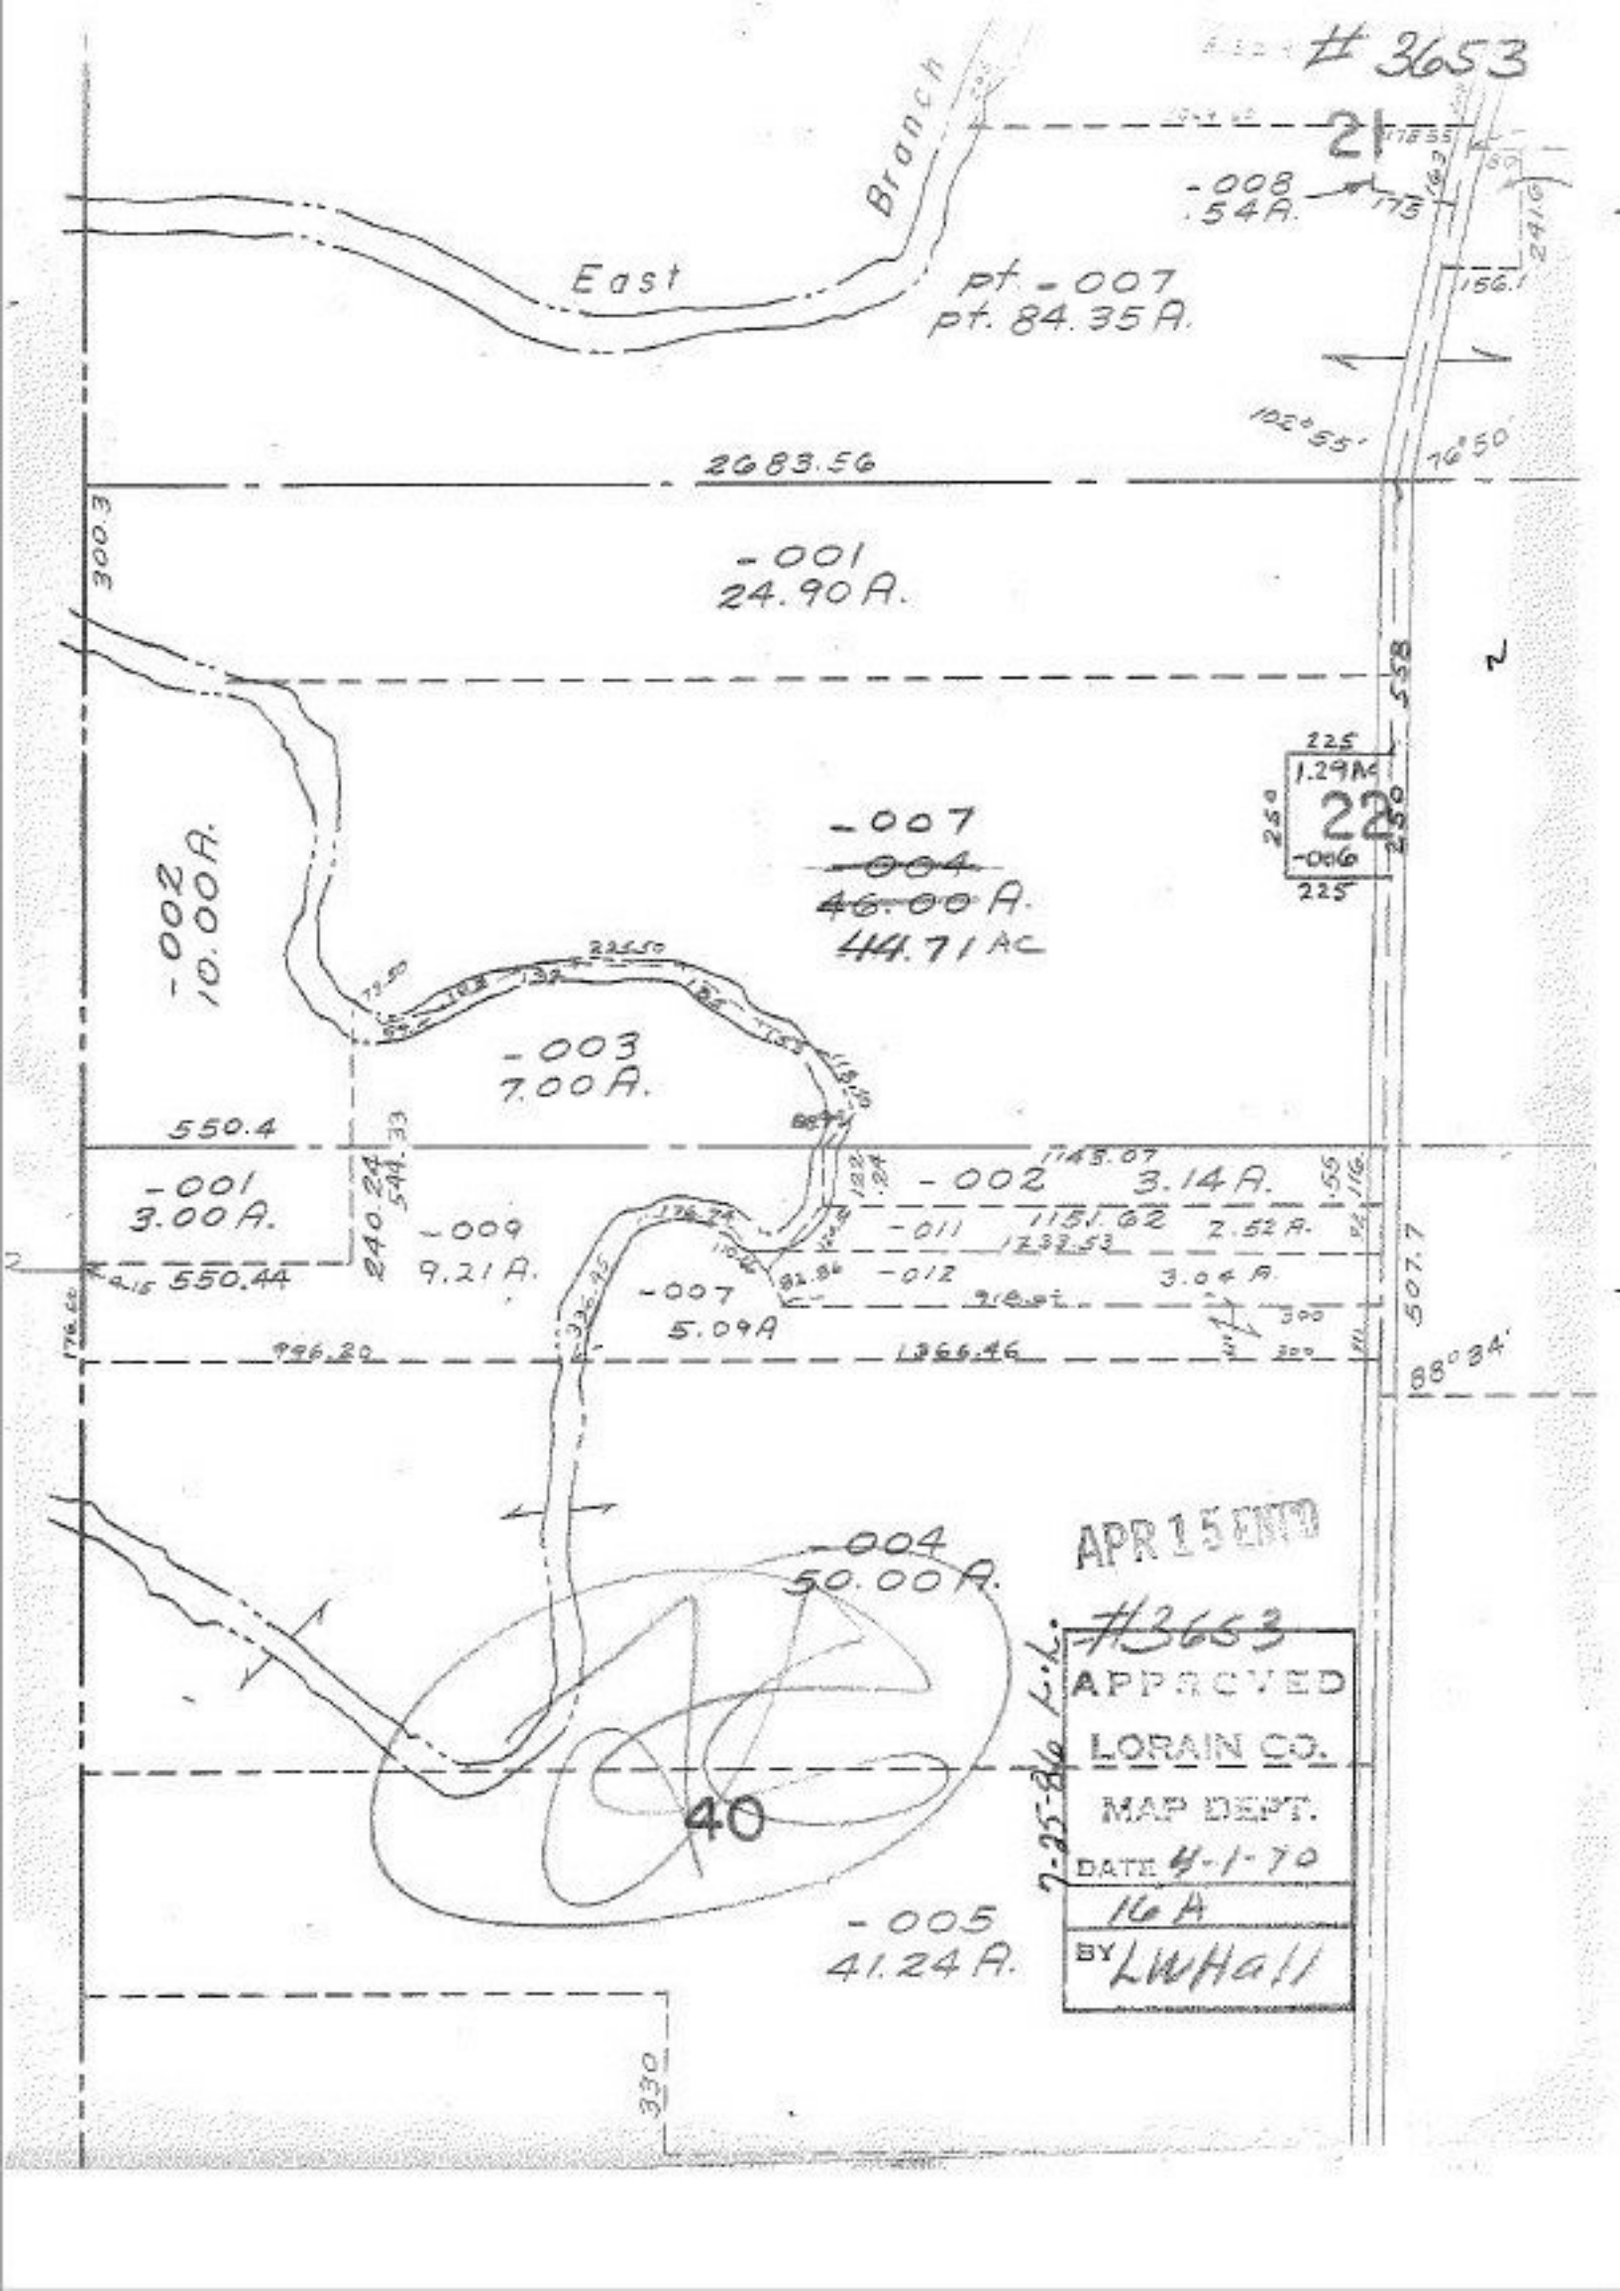
#3653
East Branch
pt. -007
pt. 84.35 A.
-008
.54A.
21
2683.56
-001
24.90 A.
-002
10.00 A.
-003
7.00 A.
-007
-004
46.00 A.
44.71 AC
1.29 AC
22
-006
-001
3.00 A.
-009
9.21 A.
-007
5.09 A
-002
3.14 A.
-011
2.52 A.
-012
3.04 A.
-004
50.00 A.
40
-005
41.24 A.
APR 15
#3653
APPROVED
LORAIN CO.
MAP DEPT.
DATE 4-1-70
16 A
BY LWHall
2-25-Ble L.L.
550.4
996.20
1366.46
507.7
330