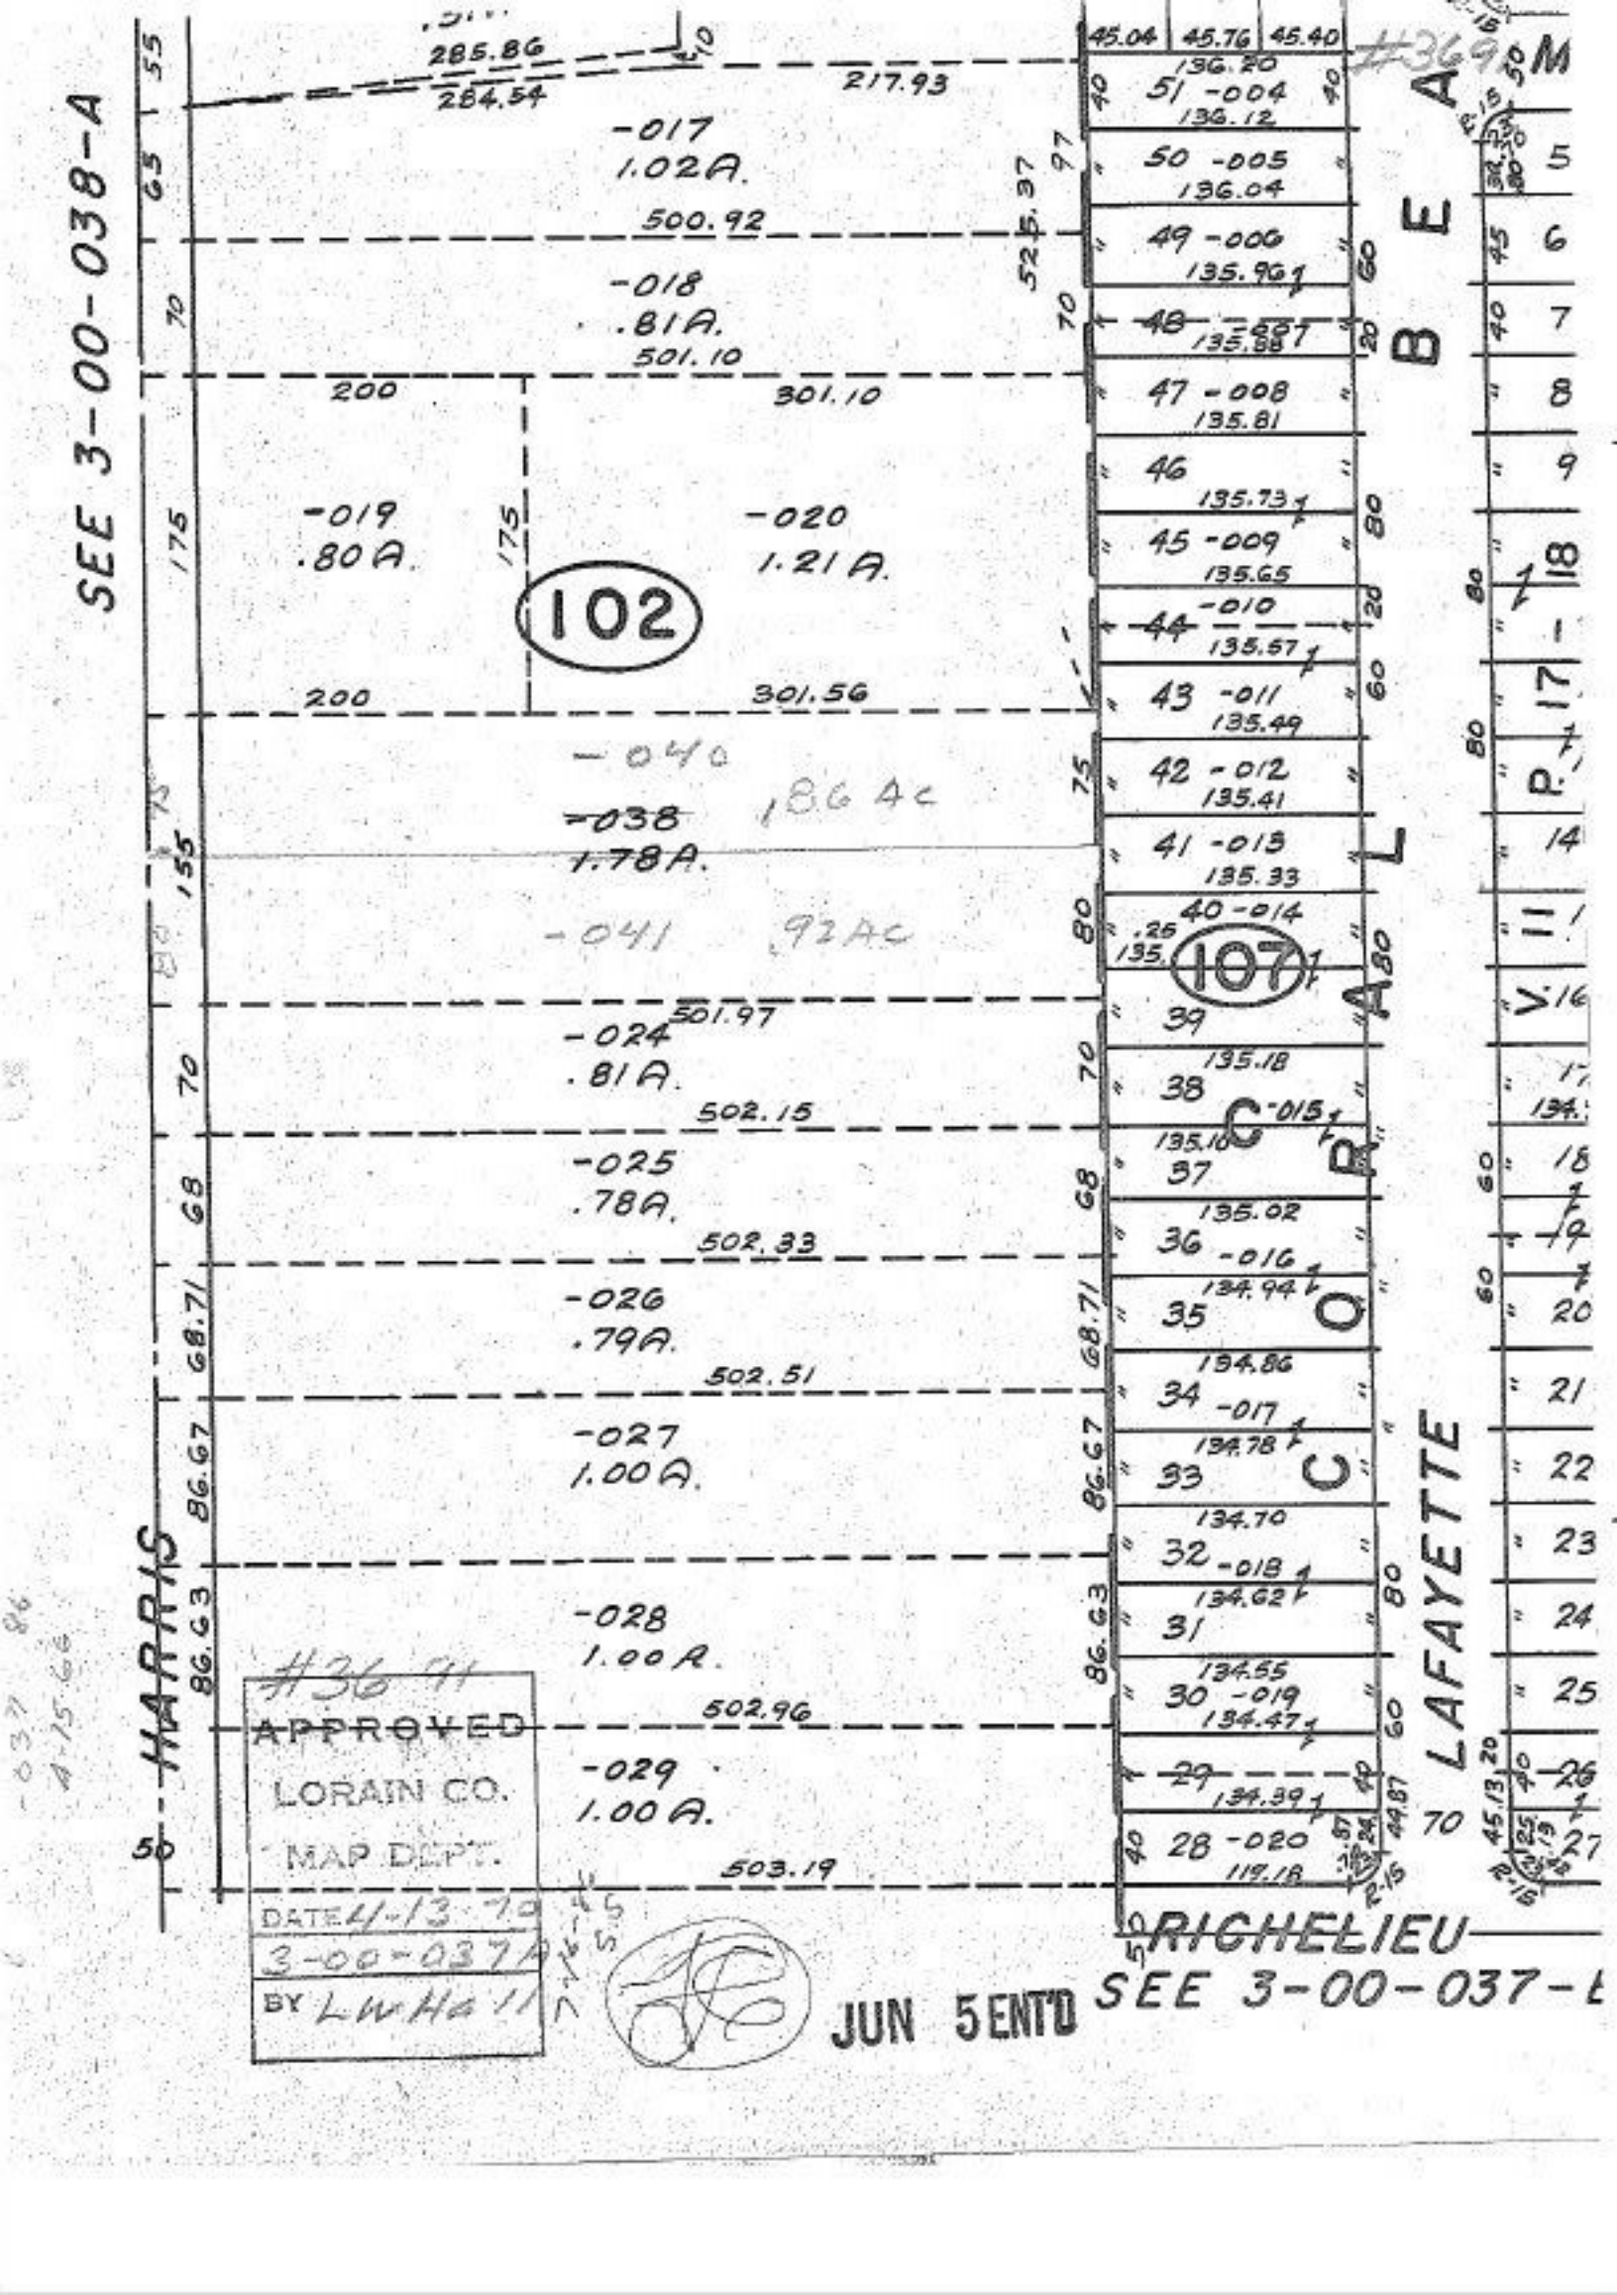
SEE 3-00-038-A
HARRIS
285.86
284.54
217.93
-017
1.02A.
500.92
-018
.81A.
501.10
200
301.10
-019
.80A.
-020
1.21A.
102
200
301.56
-040
.86 Ac
-038
1.78A.
-041
.92Ac
501.97
-024
.81A.
502.15
-025
.78A.
502.33
-026
.79A.
502.51
-027
1.00A.
-028
1.00A.
502.96
-029
1.00A.
503.19
525.37
45.04
45.76
45.40
136.20
51 -004
136.12
50 -005
136.04
49 -006
135.96
48 -007
135.88
47 -008
135.81
46
135.73
45 -009
135.65
44 -010
135.57
43 -011
135.49
42 -012
135.41
41 -013
135.33
40 -014
107
39
135.18
38 -015
135.10
37
135.02
36 -016
134.94
35
134.86
34 -017
134.78
33
134.70
32 -018
134.62
31
134.55
30 -019
134.47
29
134.39
28 -020
119.18
CORAL BEA
LAFAYETTE
RICHELIEU
SEE 3-00-037-B
#3691
#36 91
APPROVED
LORAIN CO.
MAP DEPT.
DATE 4-13-70
3-00-037A
BY LWHall
JUN 5 ENT'D