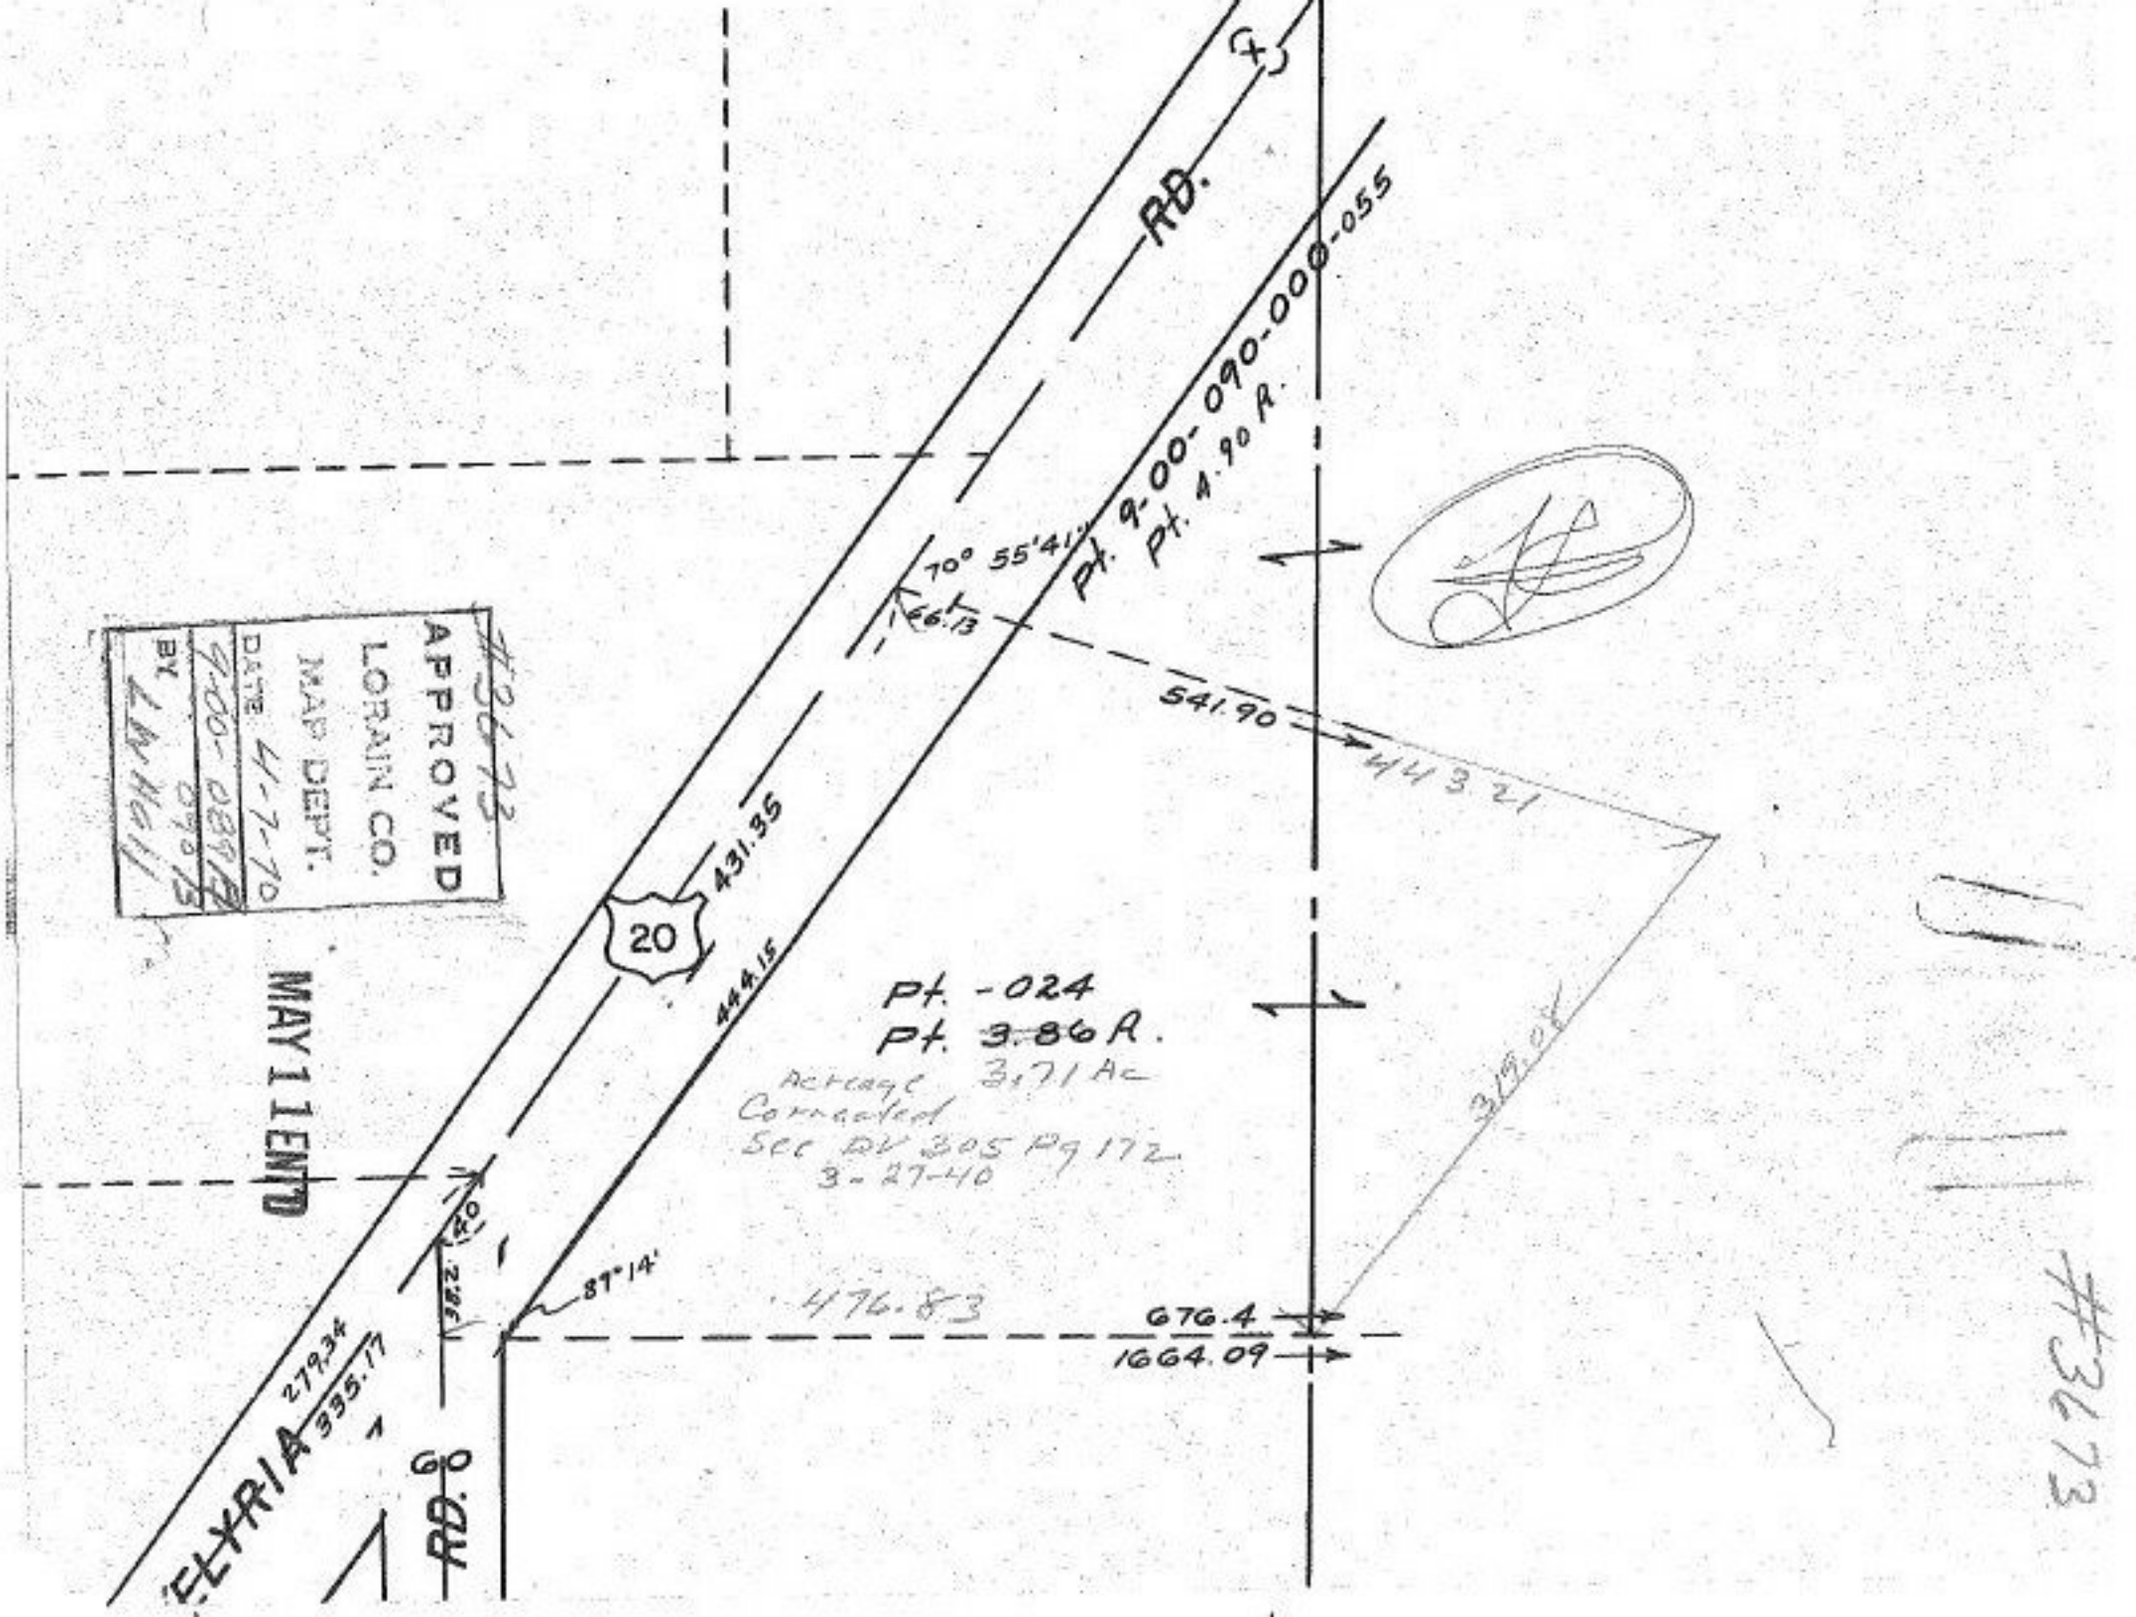
RD.
Pt. 9.00-090-000-055
Pt. 4.90 A.
70° 55'41"
166.13
541.90
431.35
444.15
20
APPROVED
LORAIN CO.
MAP DEPT.
DATE 4-7-10
BY
MAY 1 LEND
Pt. -024
Pt. 3.86 A.
Acreage 3.71 Ac
Corrected
See DV 305 Pg 172
3-27-40
319.08
87°14'
476.83
676.4
1664.09
279.34
335.17
RD.
40
ELYRIA