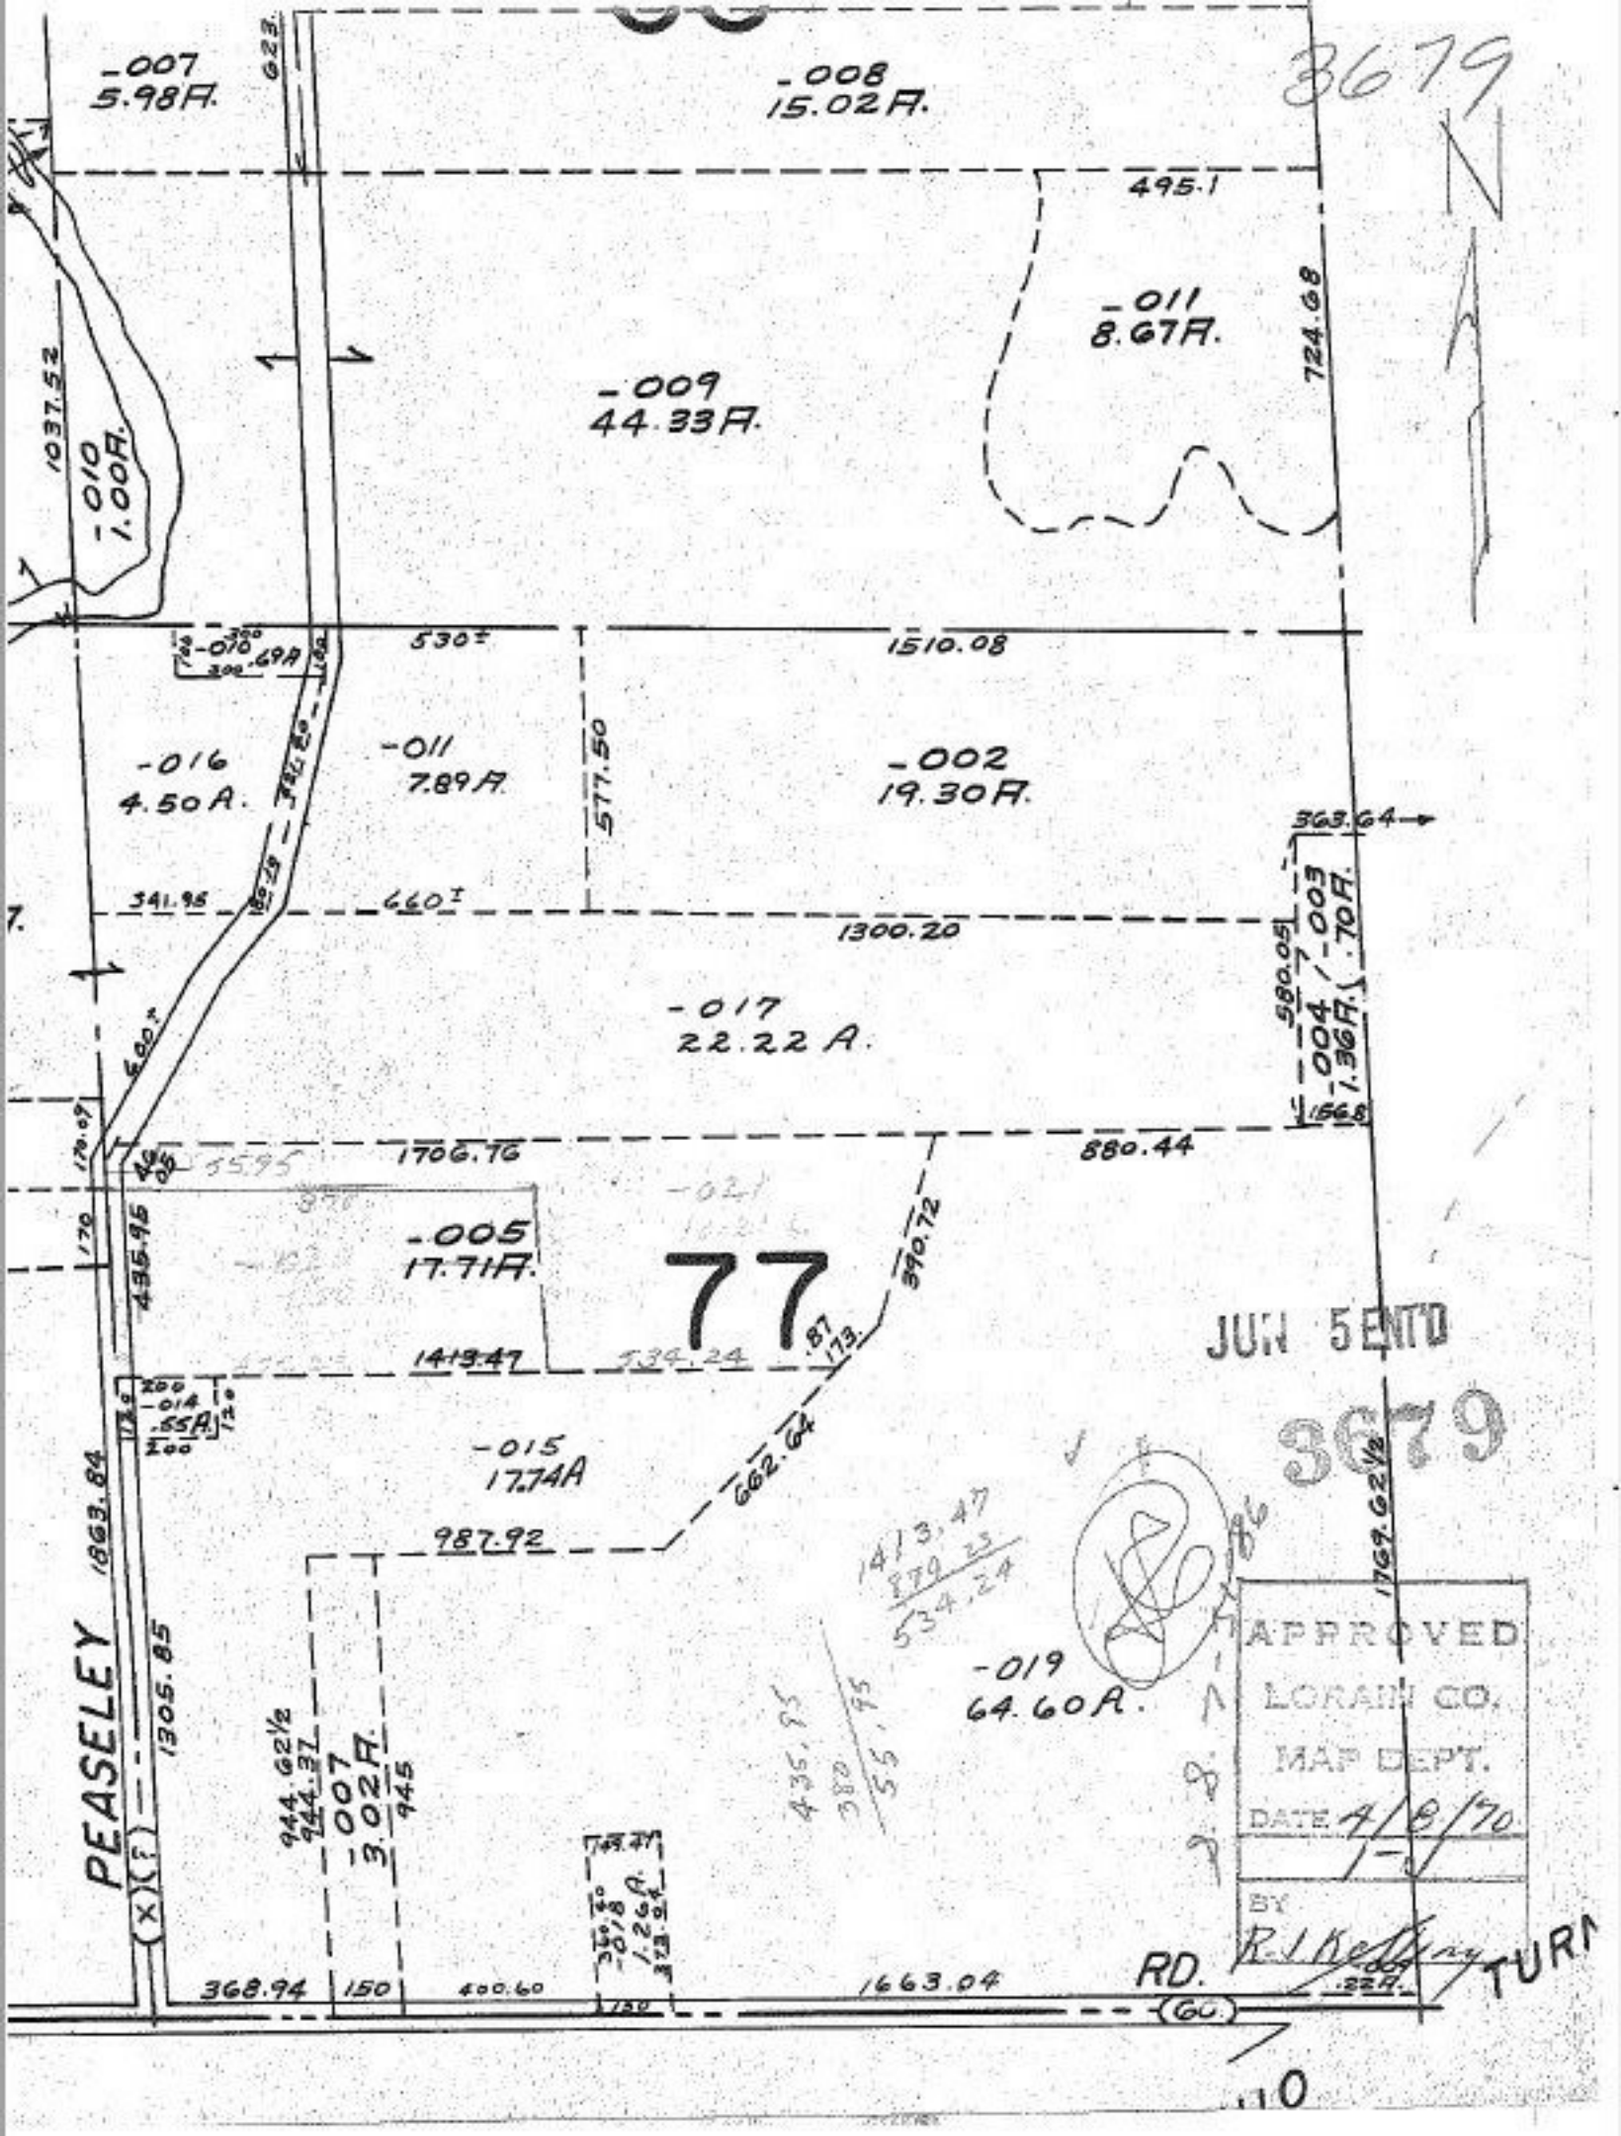
-007
5.98A.
623.
-008
15.02A.
3679
N
495.1
-011
8.67A.
724.68
-009
44.33A.
1037.52
-010
1.00A.
530±
1510.08
-016
4.50A.
-011
7.89A.
577.50
-002
19.30A.
363.64
341.95
660±
1300.20
-003
1.70A.
-004
1.36A.
590.05
-017
22.22A.
680±
1706.76
880.44
-005
17.71A.
77
390.72
JUN 5 ENTD
1413.47
534.24
-015
17.74A
662.64
3679
987.92
1769.62½
1863.84
1305.85
PEASELEY
-019
64.60A.
APPROVED
LORAIN CO.
MAP DEPT.
DATE 4/8/70
BY R.J. Kelly
944.62½
944.37
-007
3.02A.
945
-018
1.26A.
368.94
150
400.60
1663.04
RD.
(60)
TURN