


3702

APPROVED
LORAIN CO.
MAP DEPT.
DATE 4/15/70
A-00-012 G+H
BY
R. J. Kelling

MAY 20 1970
PT. 050

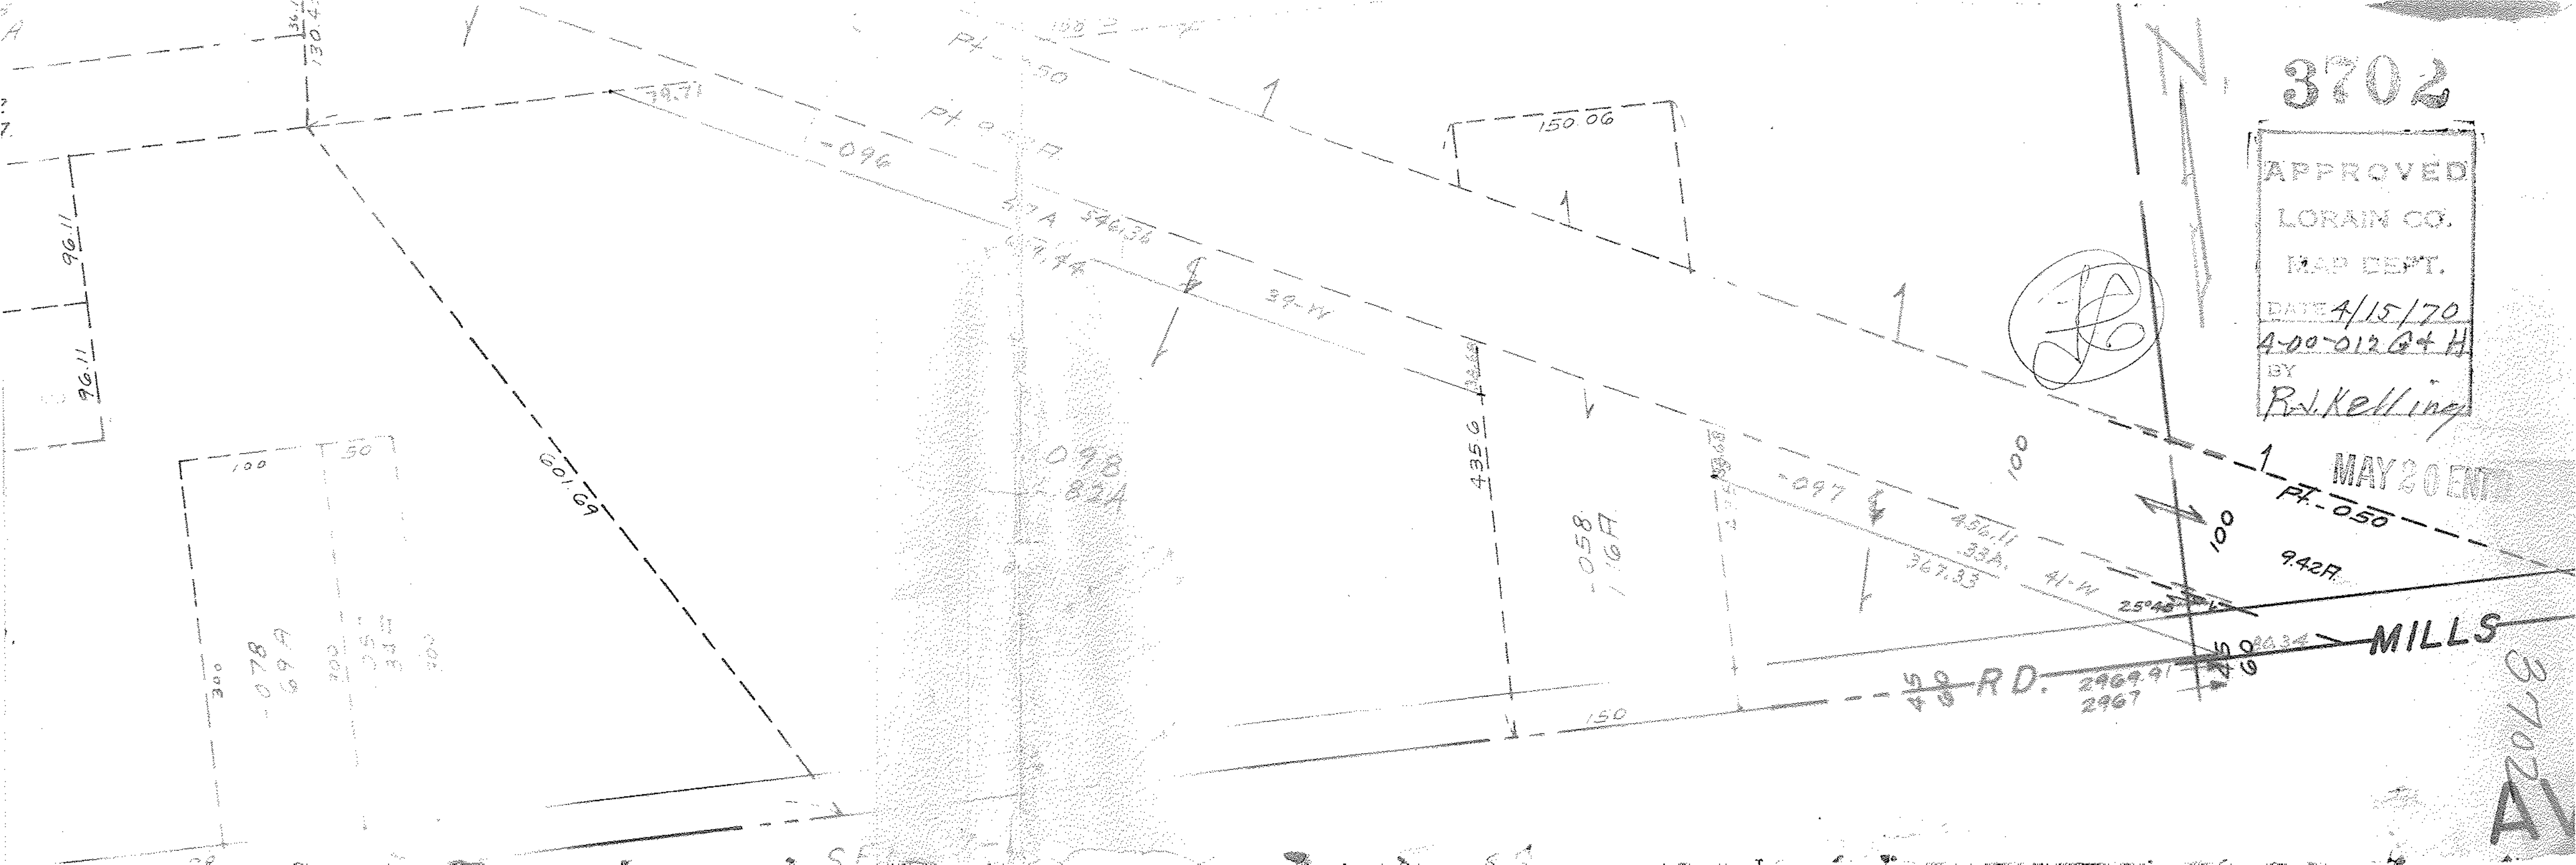

3702
A