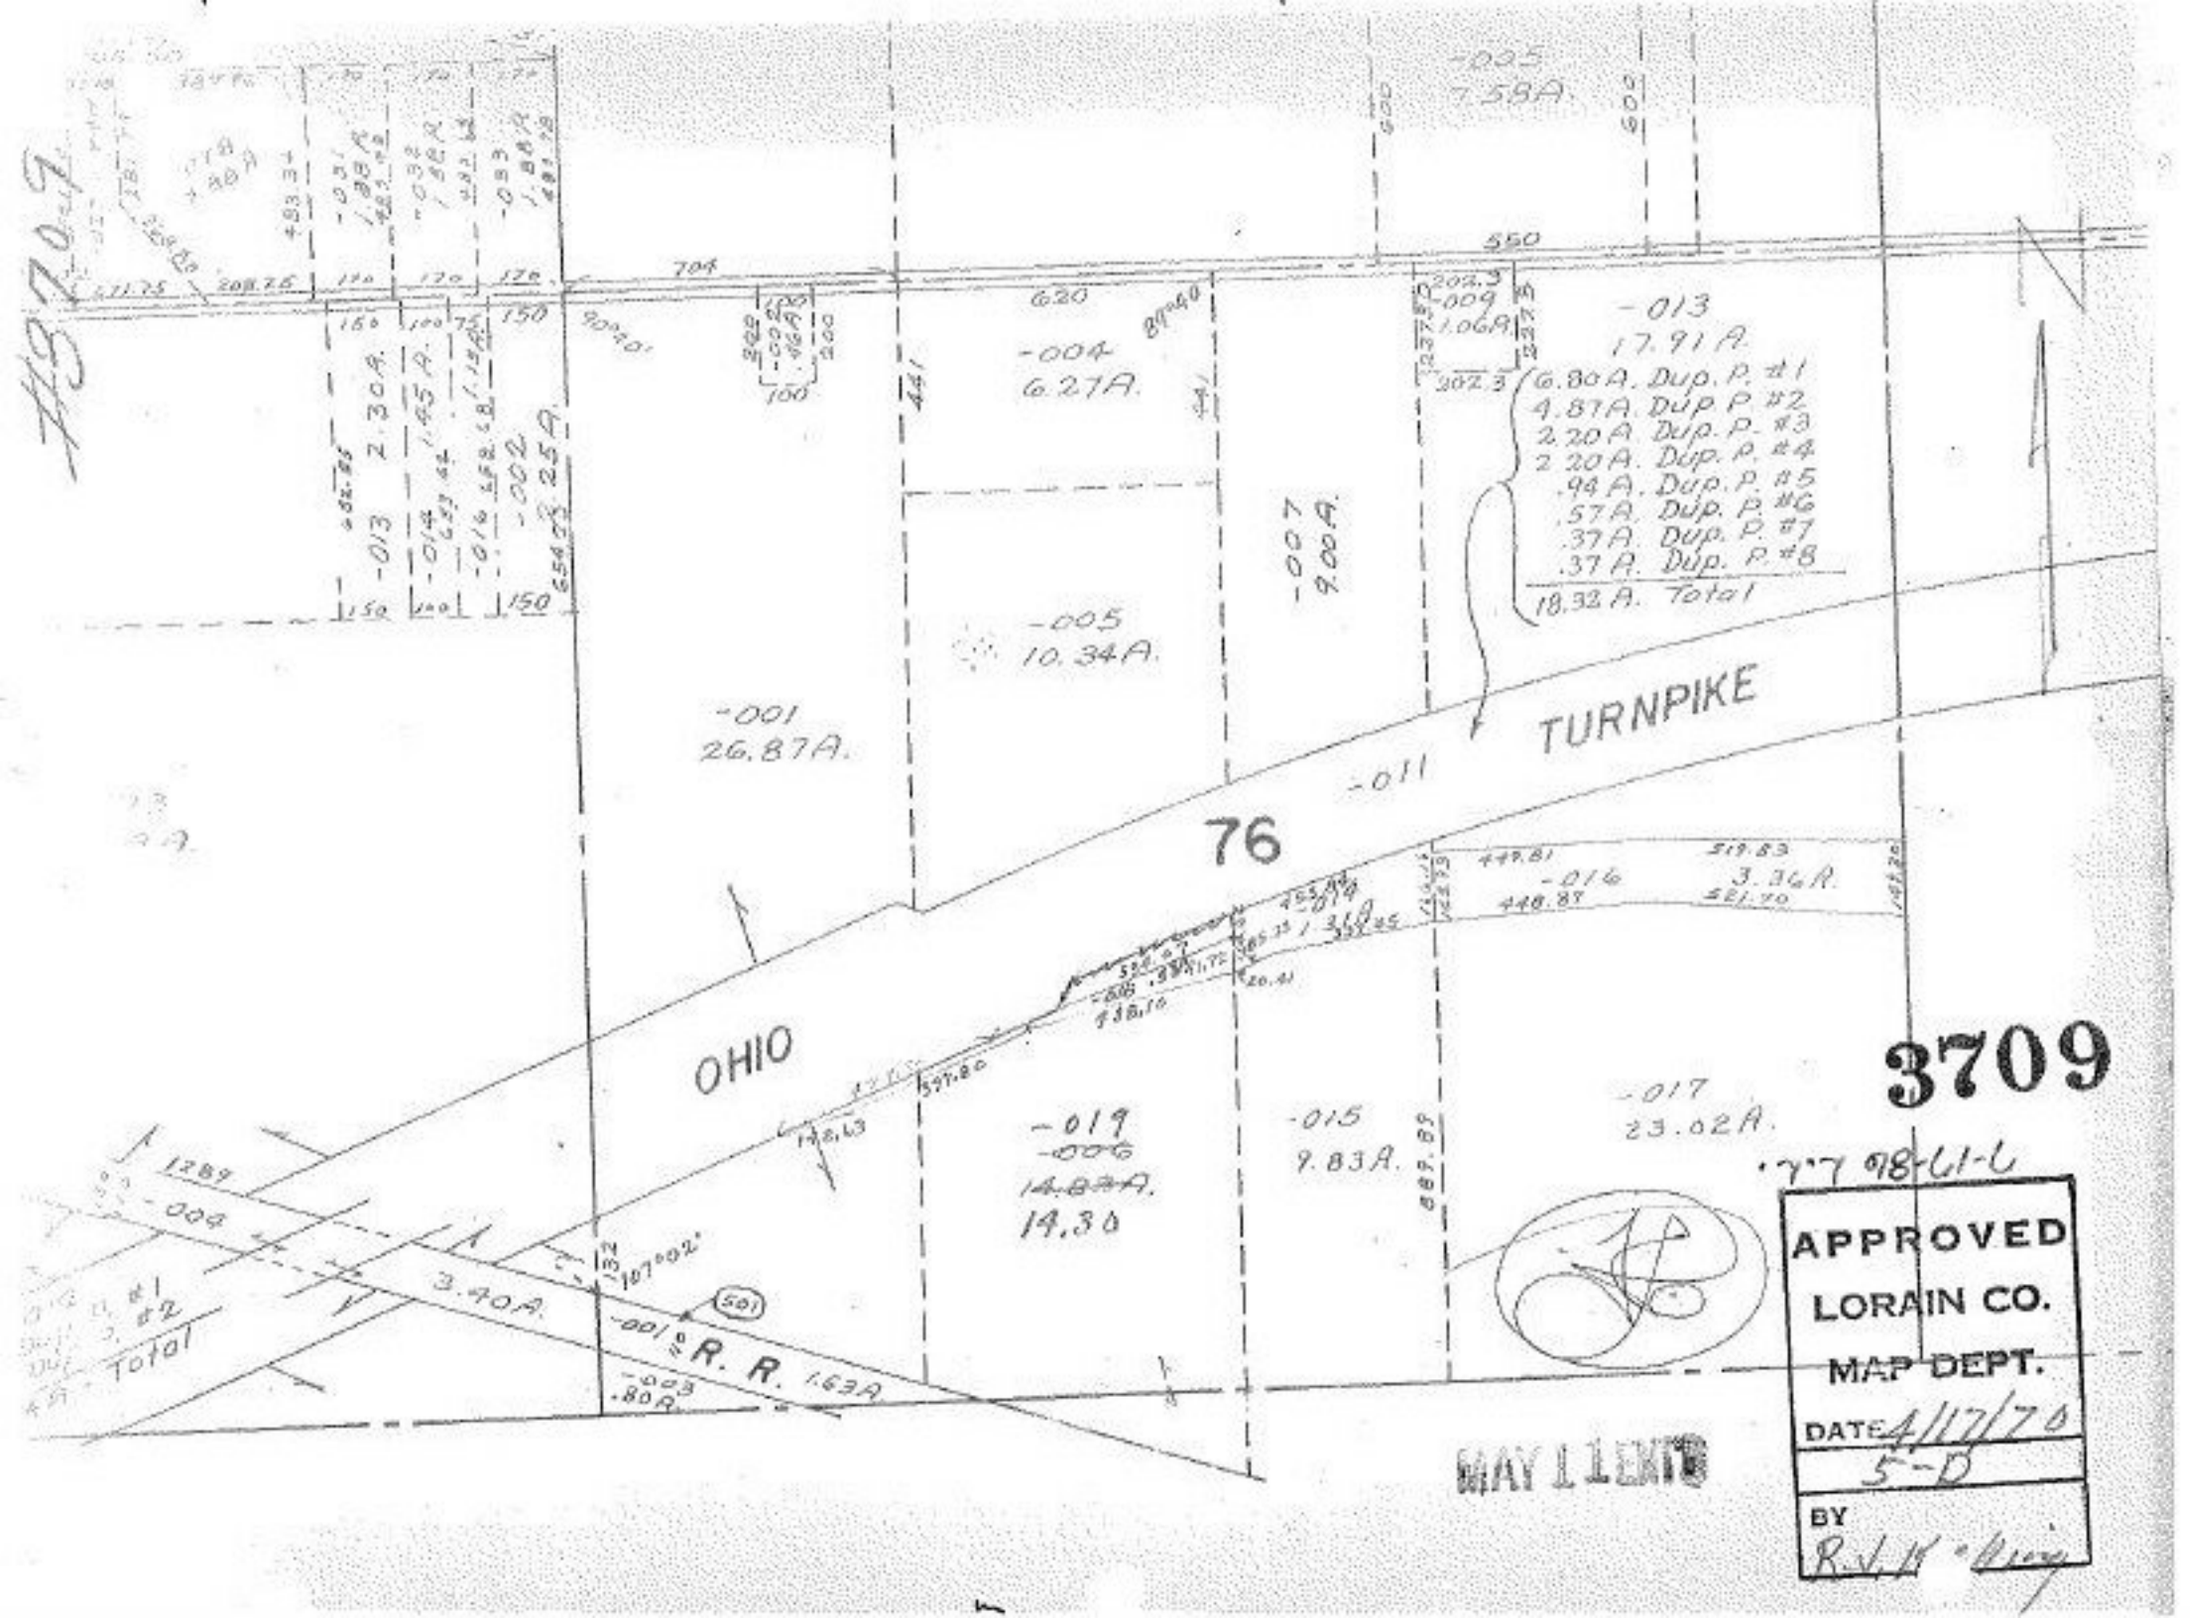
TURNPIKE
OHIO
76
-001
26.87A.
-005
10.34A.
-007
9.00A.
-004
6.27A.
-013
17.91A.
(6.80A. Dup. P. #1
4.87A. Dup. P. #2
2.20A. Dup. P. #3
2.20A. Dup. P. #4
.94A. Dup. P. #5
.57A. Dup. P. #6
.37A. Dup. P. #7
.37A. Dup. P. #8
18.32A. Total)
-009
1.06A.
-011
-014
-016
3.36A.
-017
23.02A.
-019
-006
14.83A.
14.30
-015
9.83A.
-001
R. R.
1.63A
3.40A.
-009
Total
3709
APPROVED
LORAIN CO.
MAP DEPT.
DATE 4/17/70
5-D
BY R.V.K.
MAY 11 1970