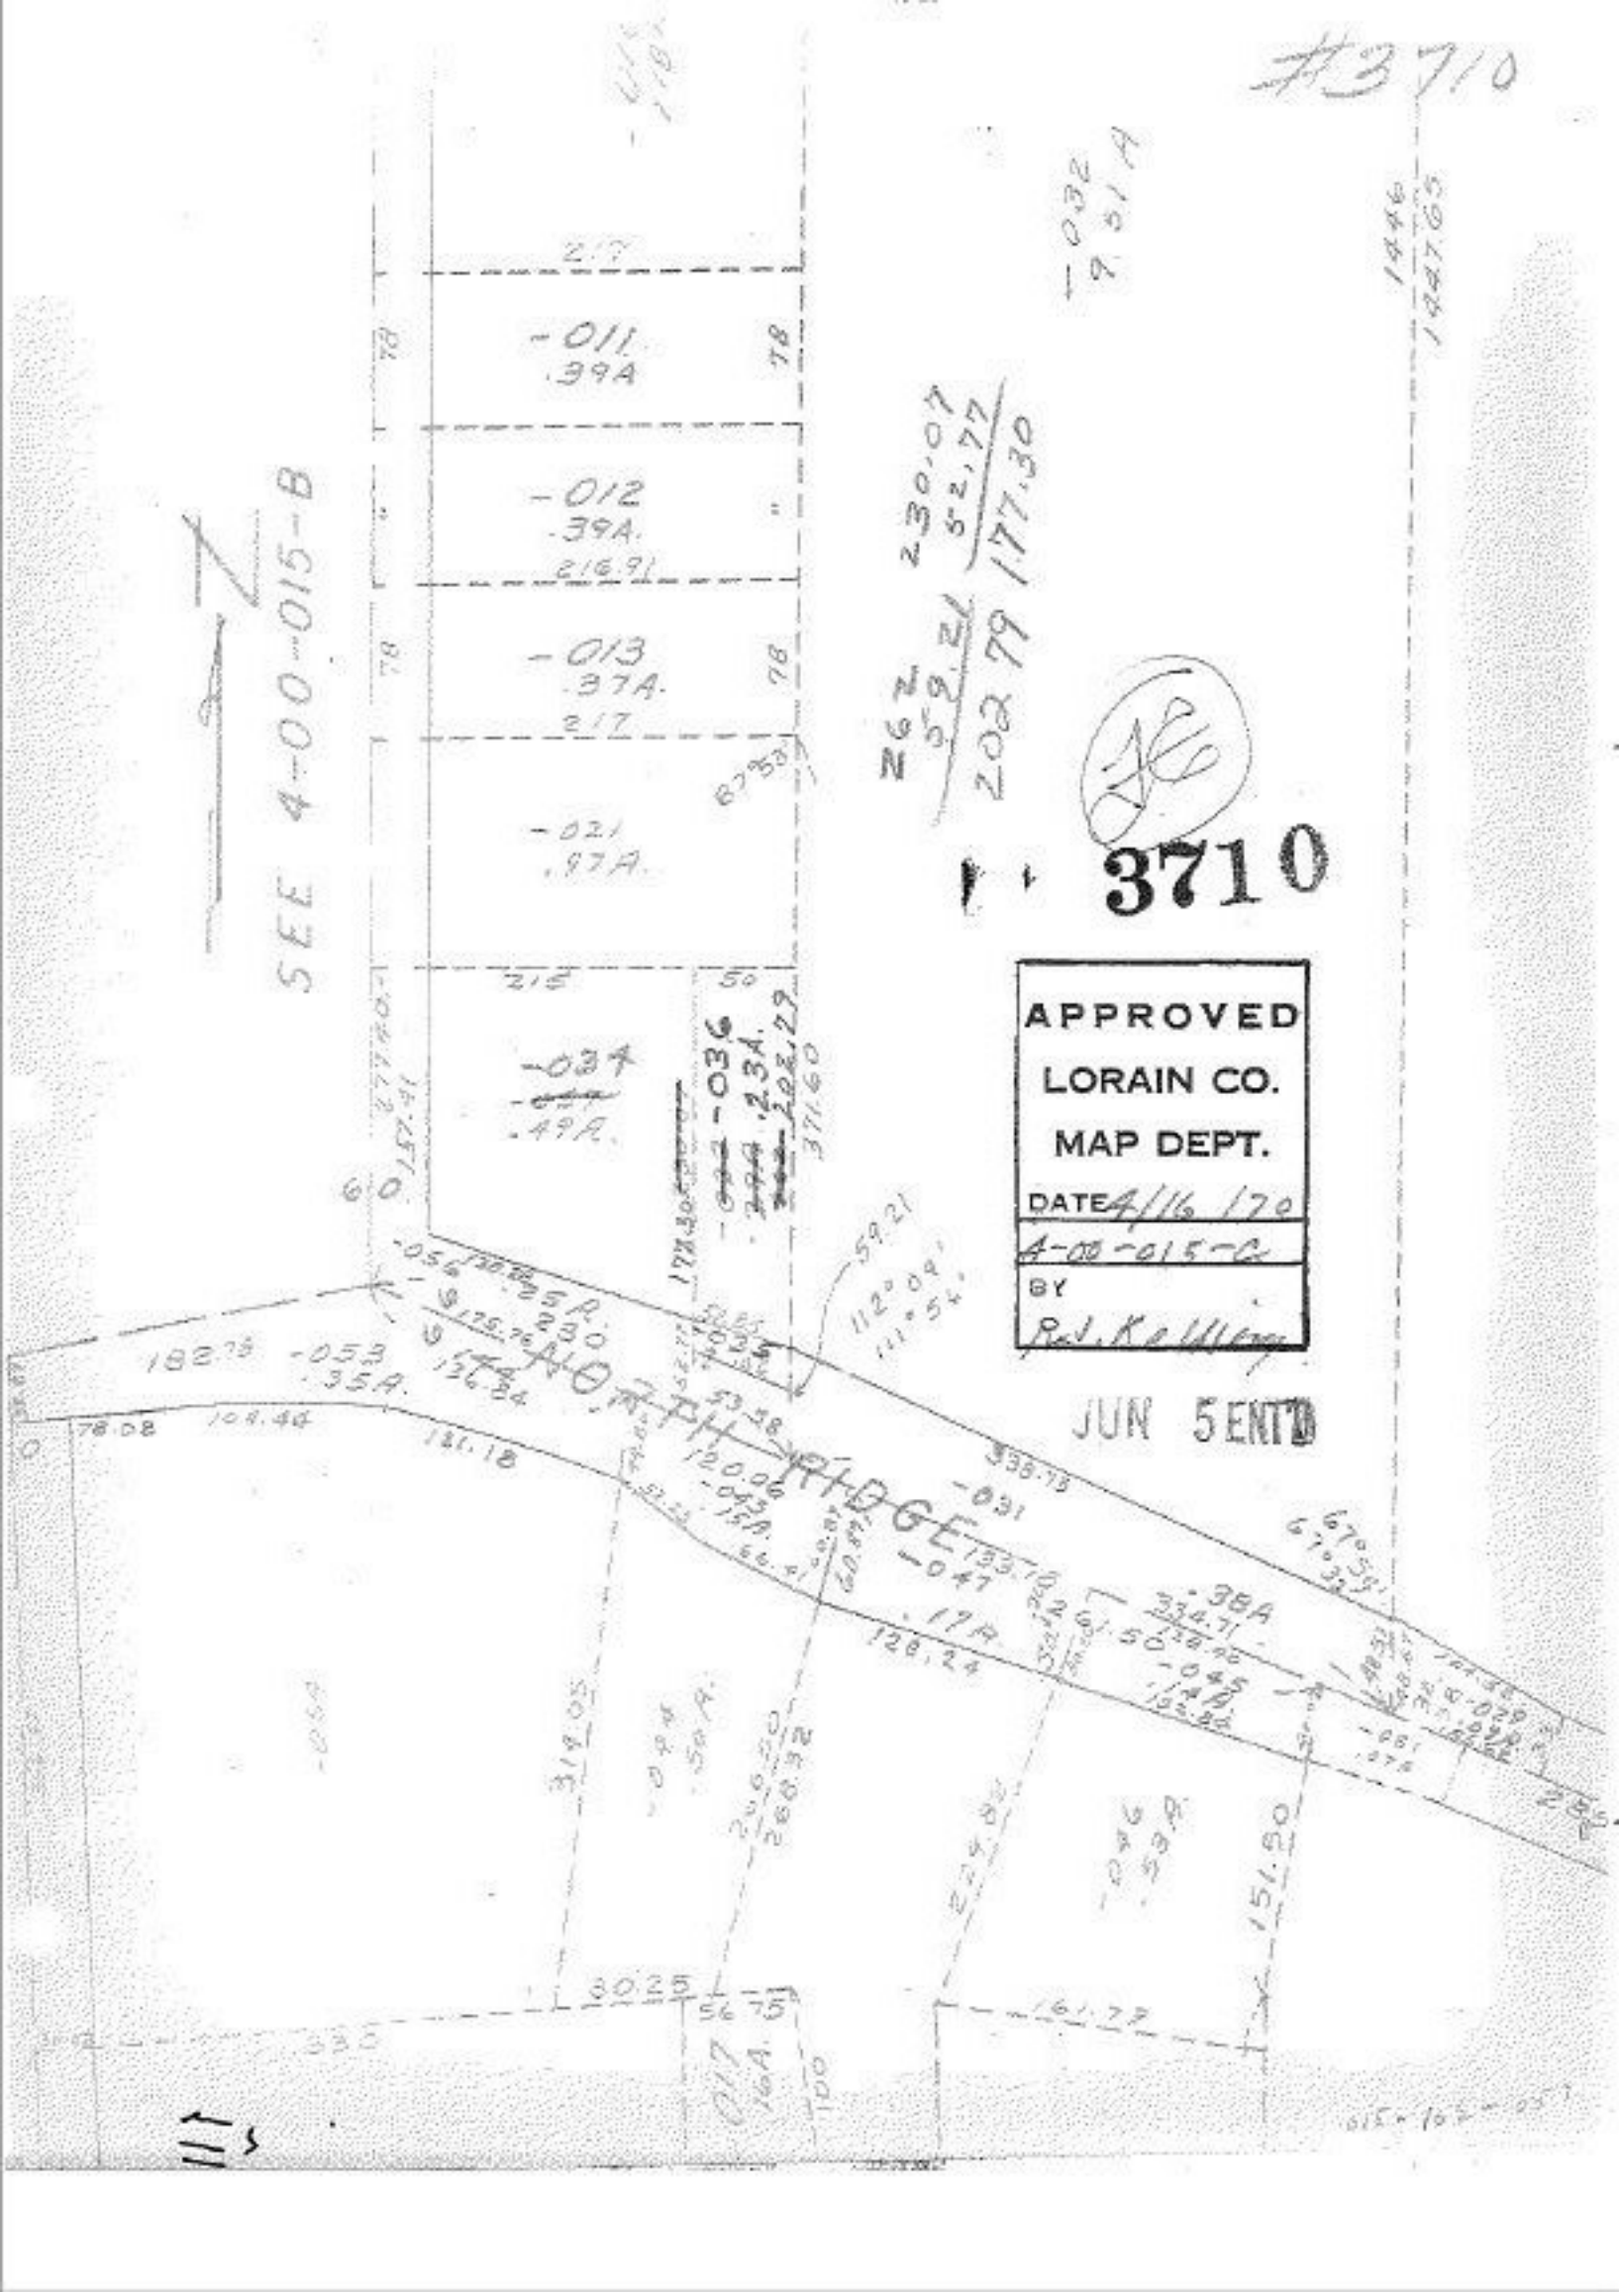
#3710
SEE 4-00-015-B
-011
.39A
-012
.39A.
216.91
-013
.37A.
217
-021
.97A.
-034
.49A.
-036
.234.
102.29
-056
.25A.
-053
.35A.
-031
-047
.17A.
-045
.38A
-044
.59A.
-017
.16A.
APPROVED
LORAIN CO.
MAP DEPT.
DATE 4/16/70
4-00-015-C
BY
Rod. Kellam
JUN 5 ENT'D
3710