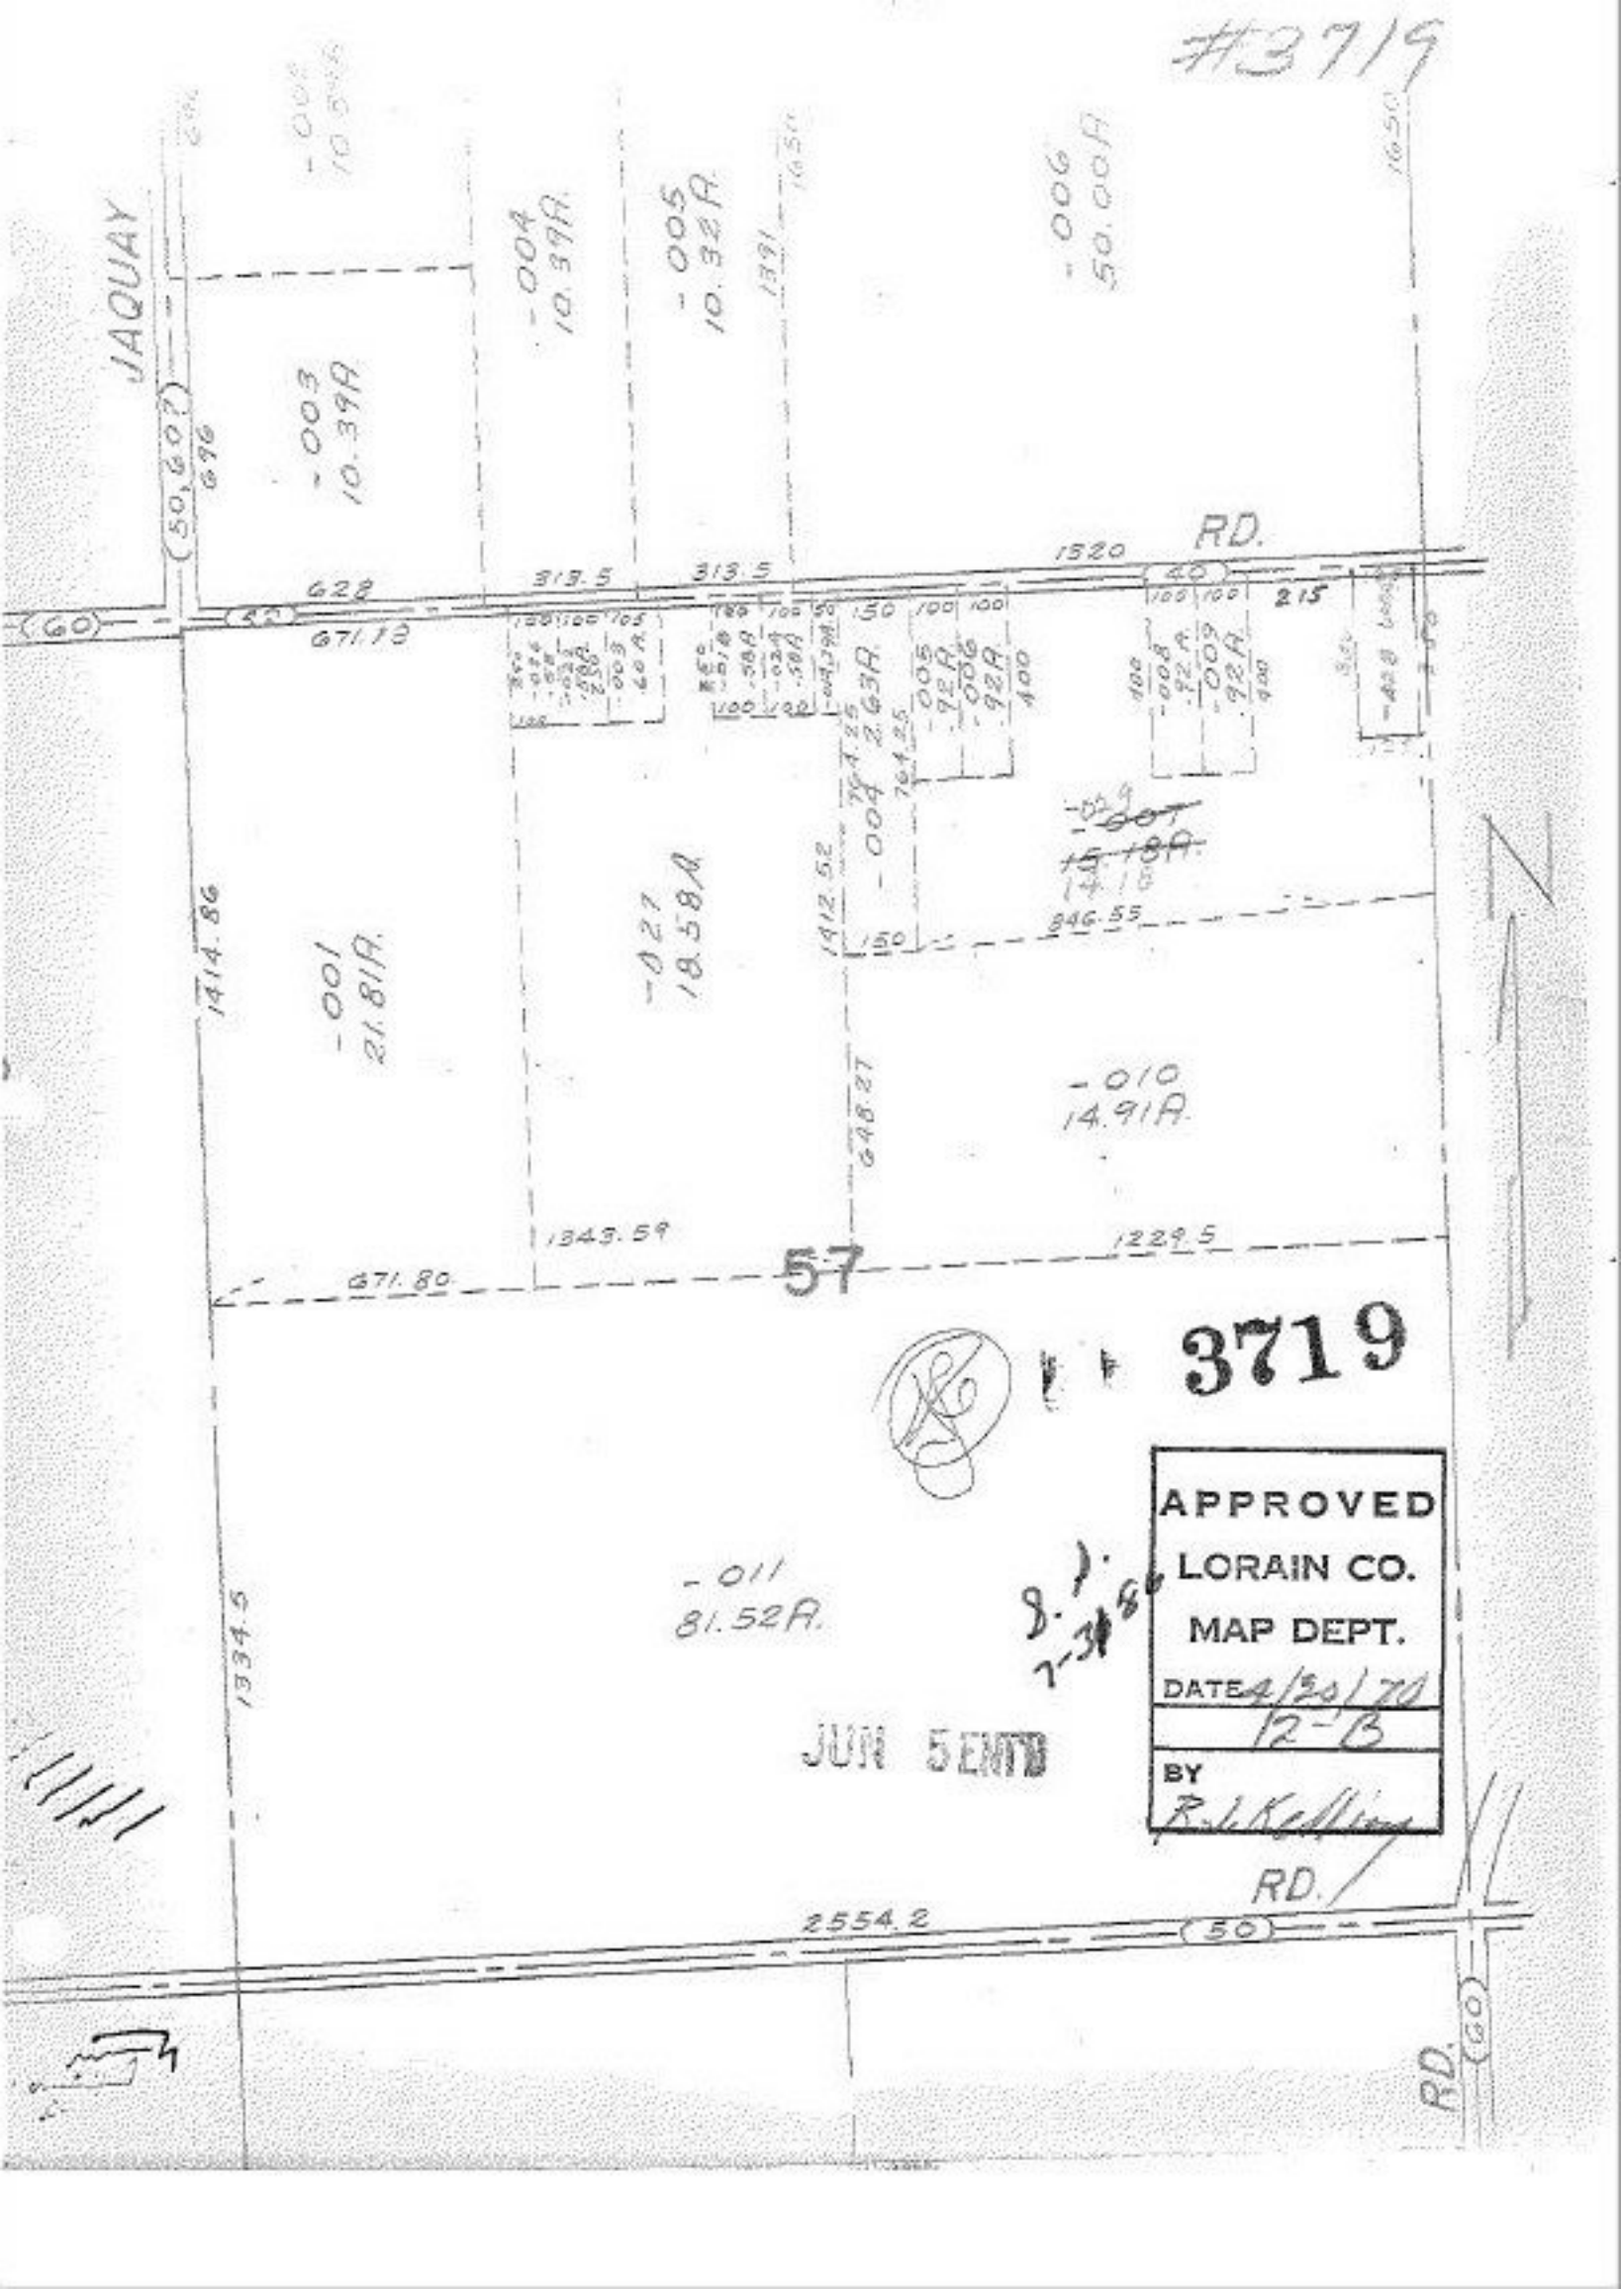
#3719
JAQUAY
RD.
-003
10.39A
-004
10.39A
-005
10.32A
-006
50.00A
-001
21.81A
-027
18.58A
-010
14.91A
-011
81.52A
57
3719
APPROVED
LORAIN CO.
MAP DEPT.
DATE 4/20/70
12-B
BY
JUN 5 EMTD
2554.2
RD.
RD.