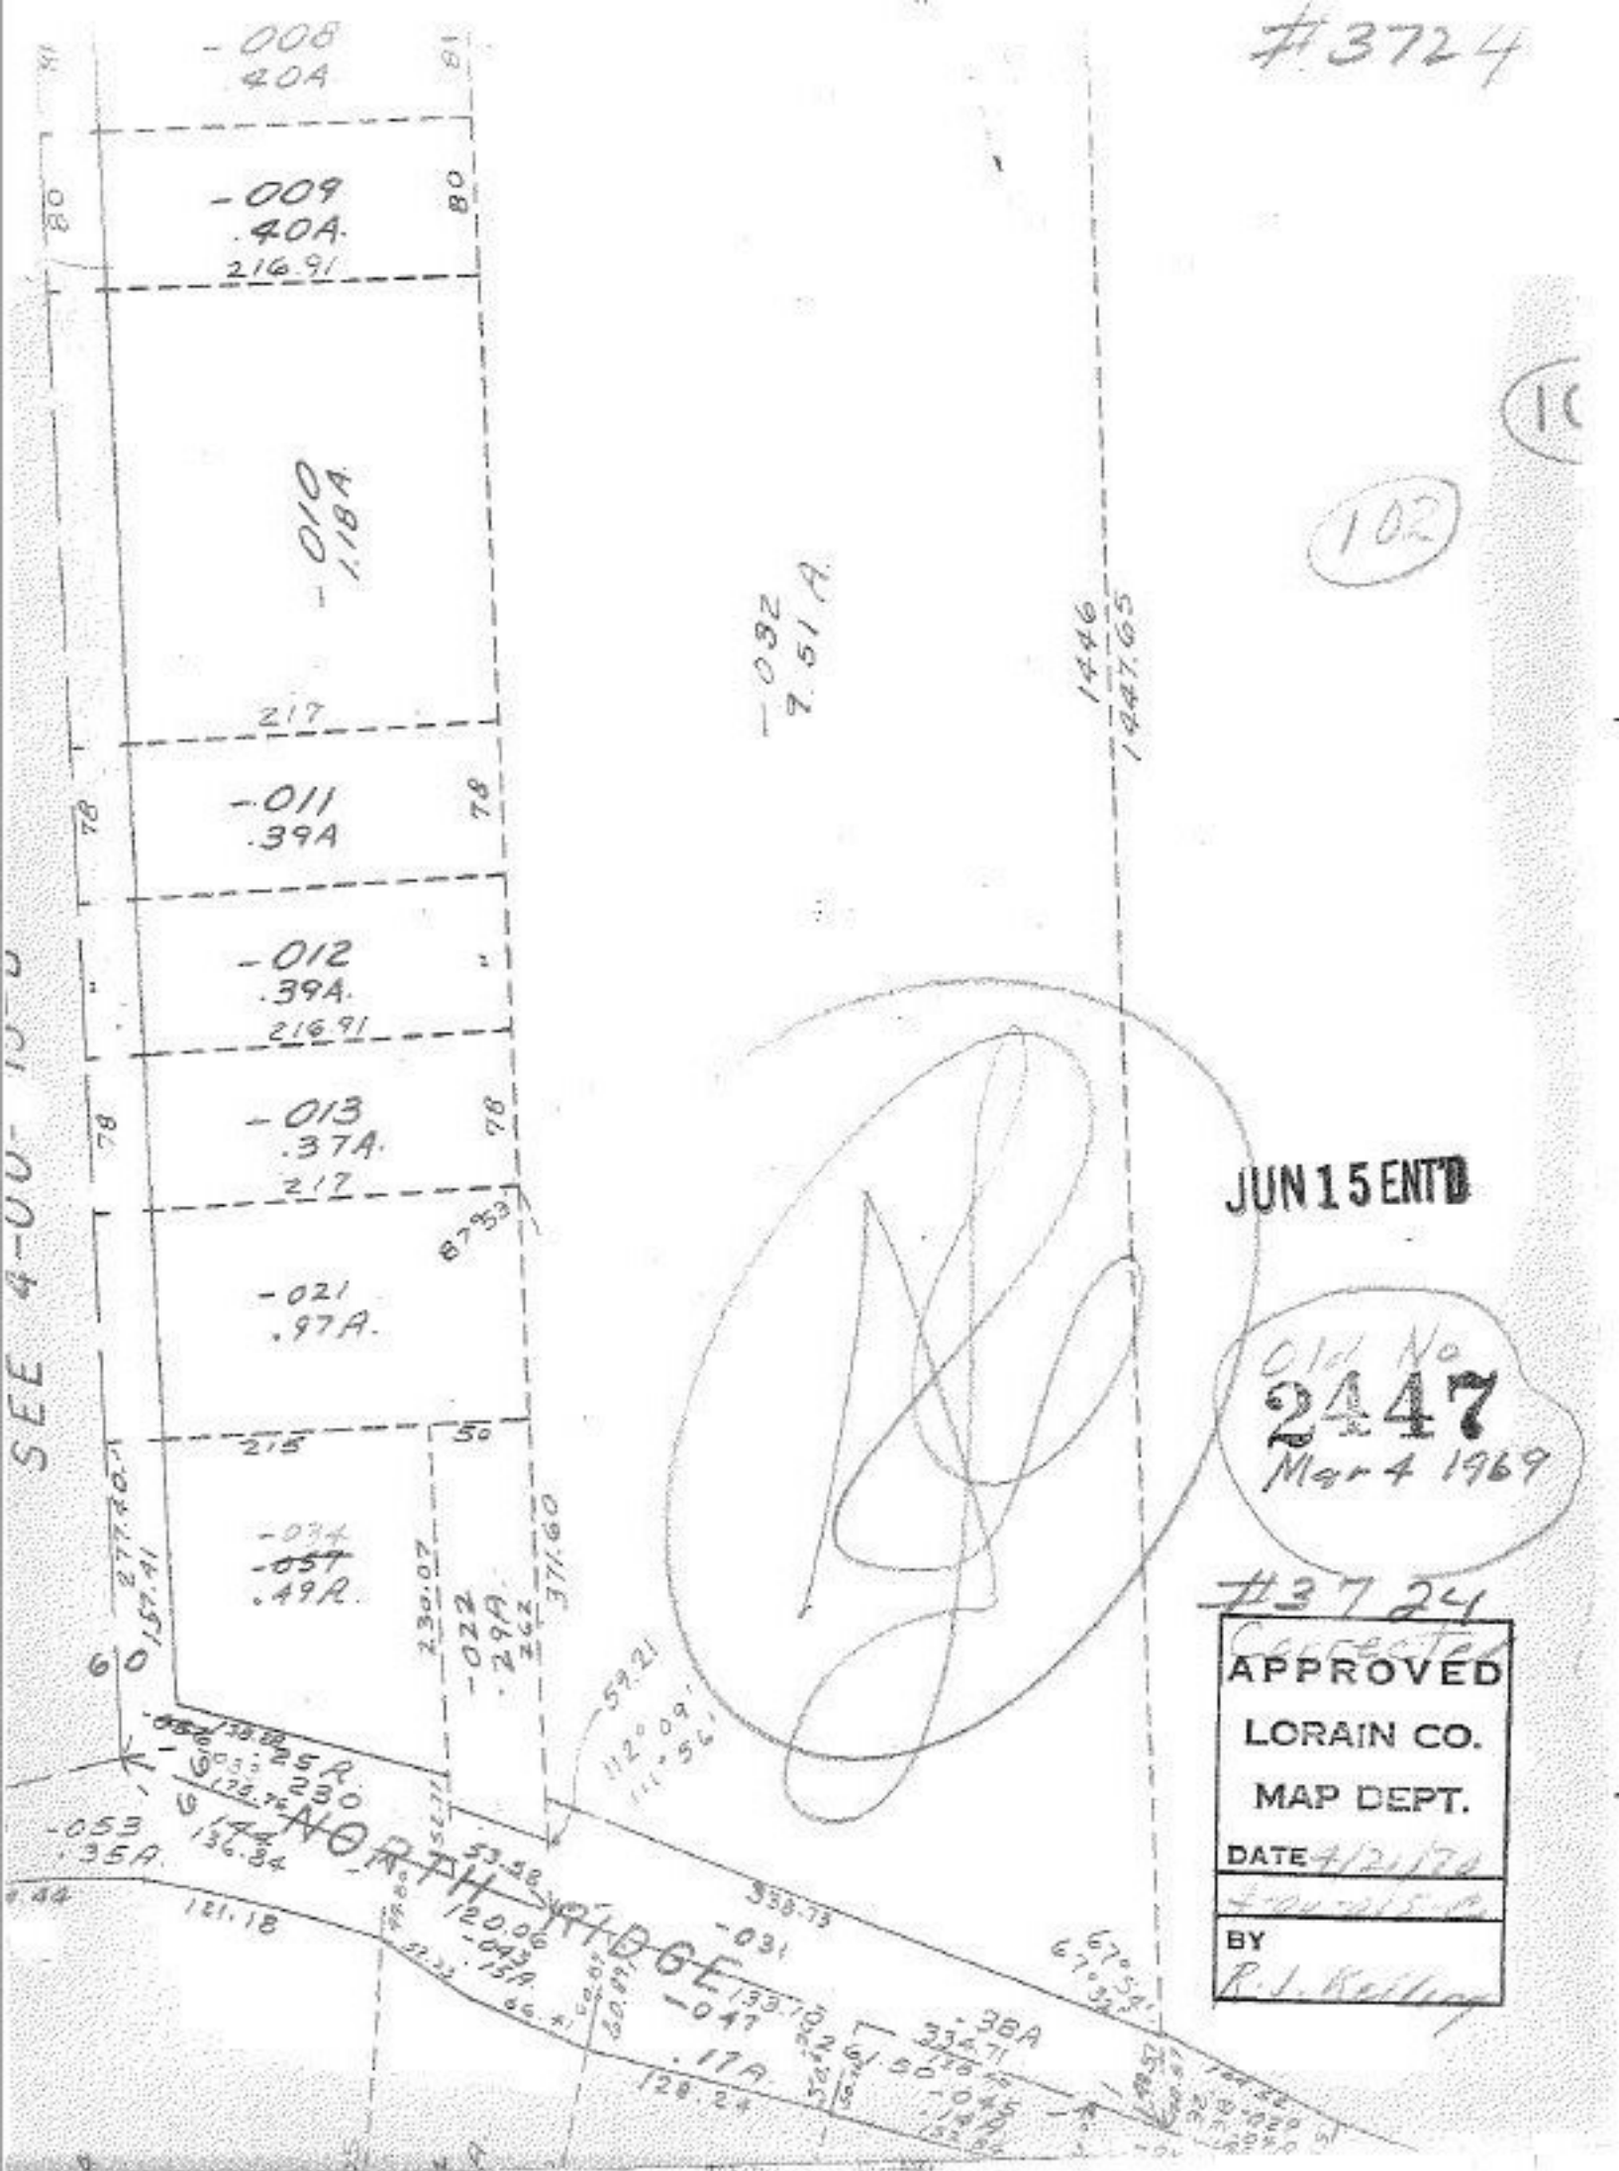
#3724
-008
40A
-009
.40A.
216.91
-010
1.18A.
217
-011
.39A
-012
.39A.
216.91
-013
.37A.
217
-021
.97A.
215
-057
.49R.
-022
.29A.
-031
.38A
-041
.17A.
-053
.35A.
-032
7.51 A.
1446
1447.65
SEE 4-00-10
JUN 15 ENT'D
Old No.
2447
Mar 4 1969
#3724
Corrected
APPROVED
LORAIN CO.
MAP DEPT.
DATE 4/21/72
BY
R. J. Kelley
NORTH
RIDGE