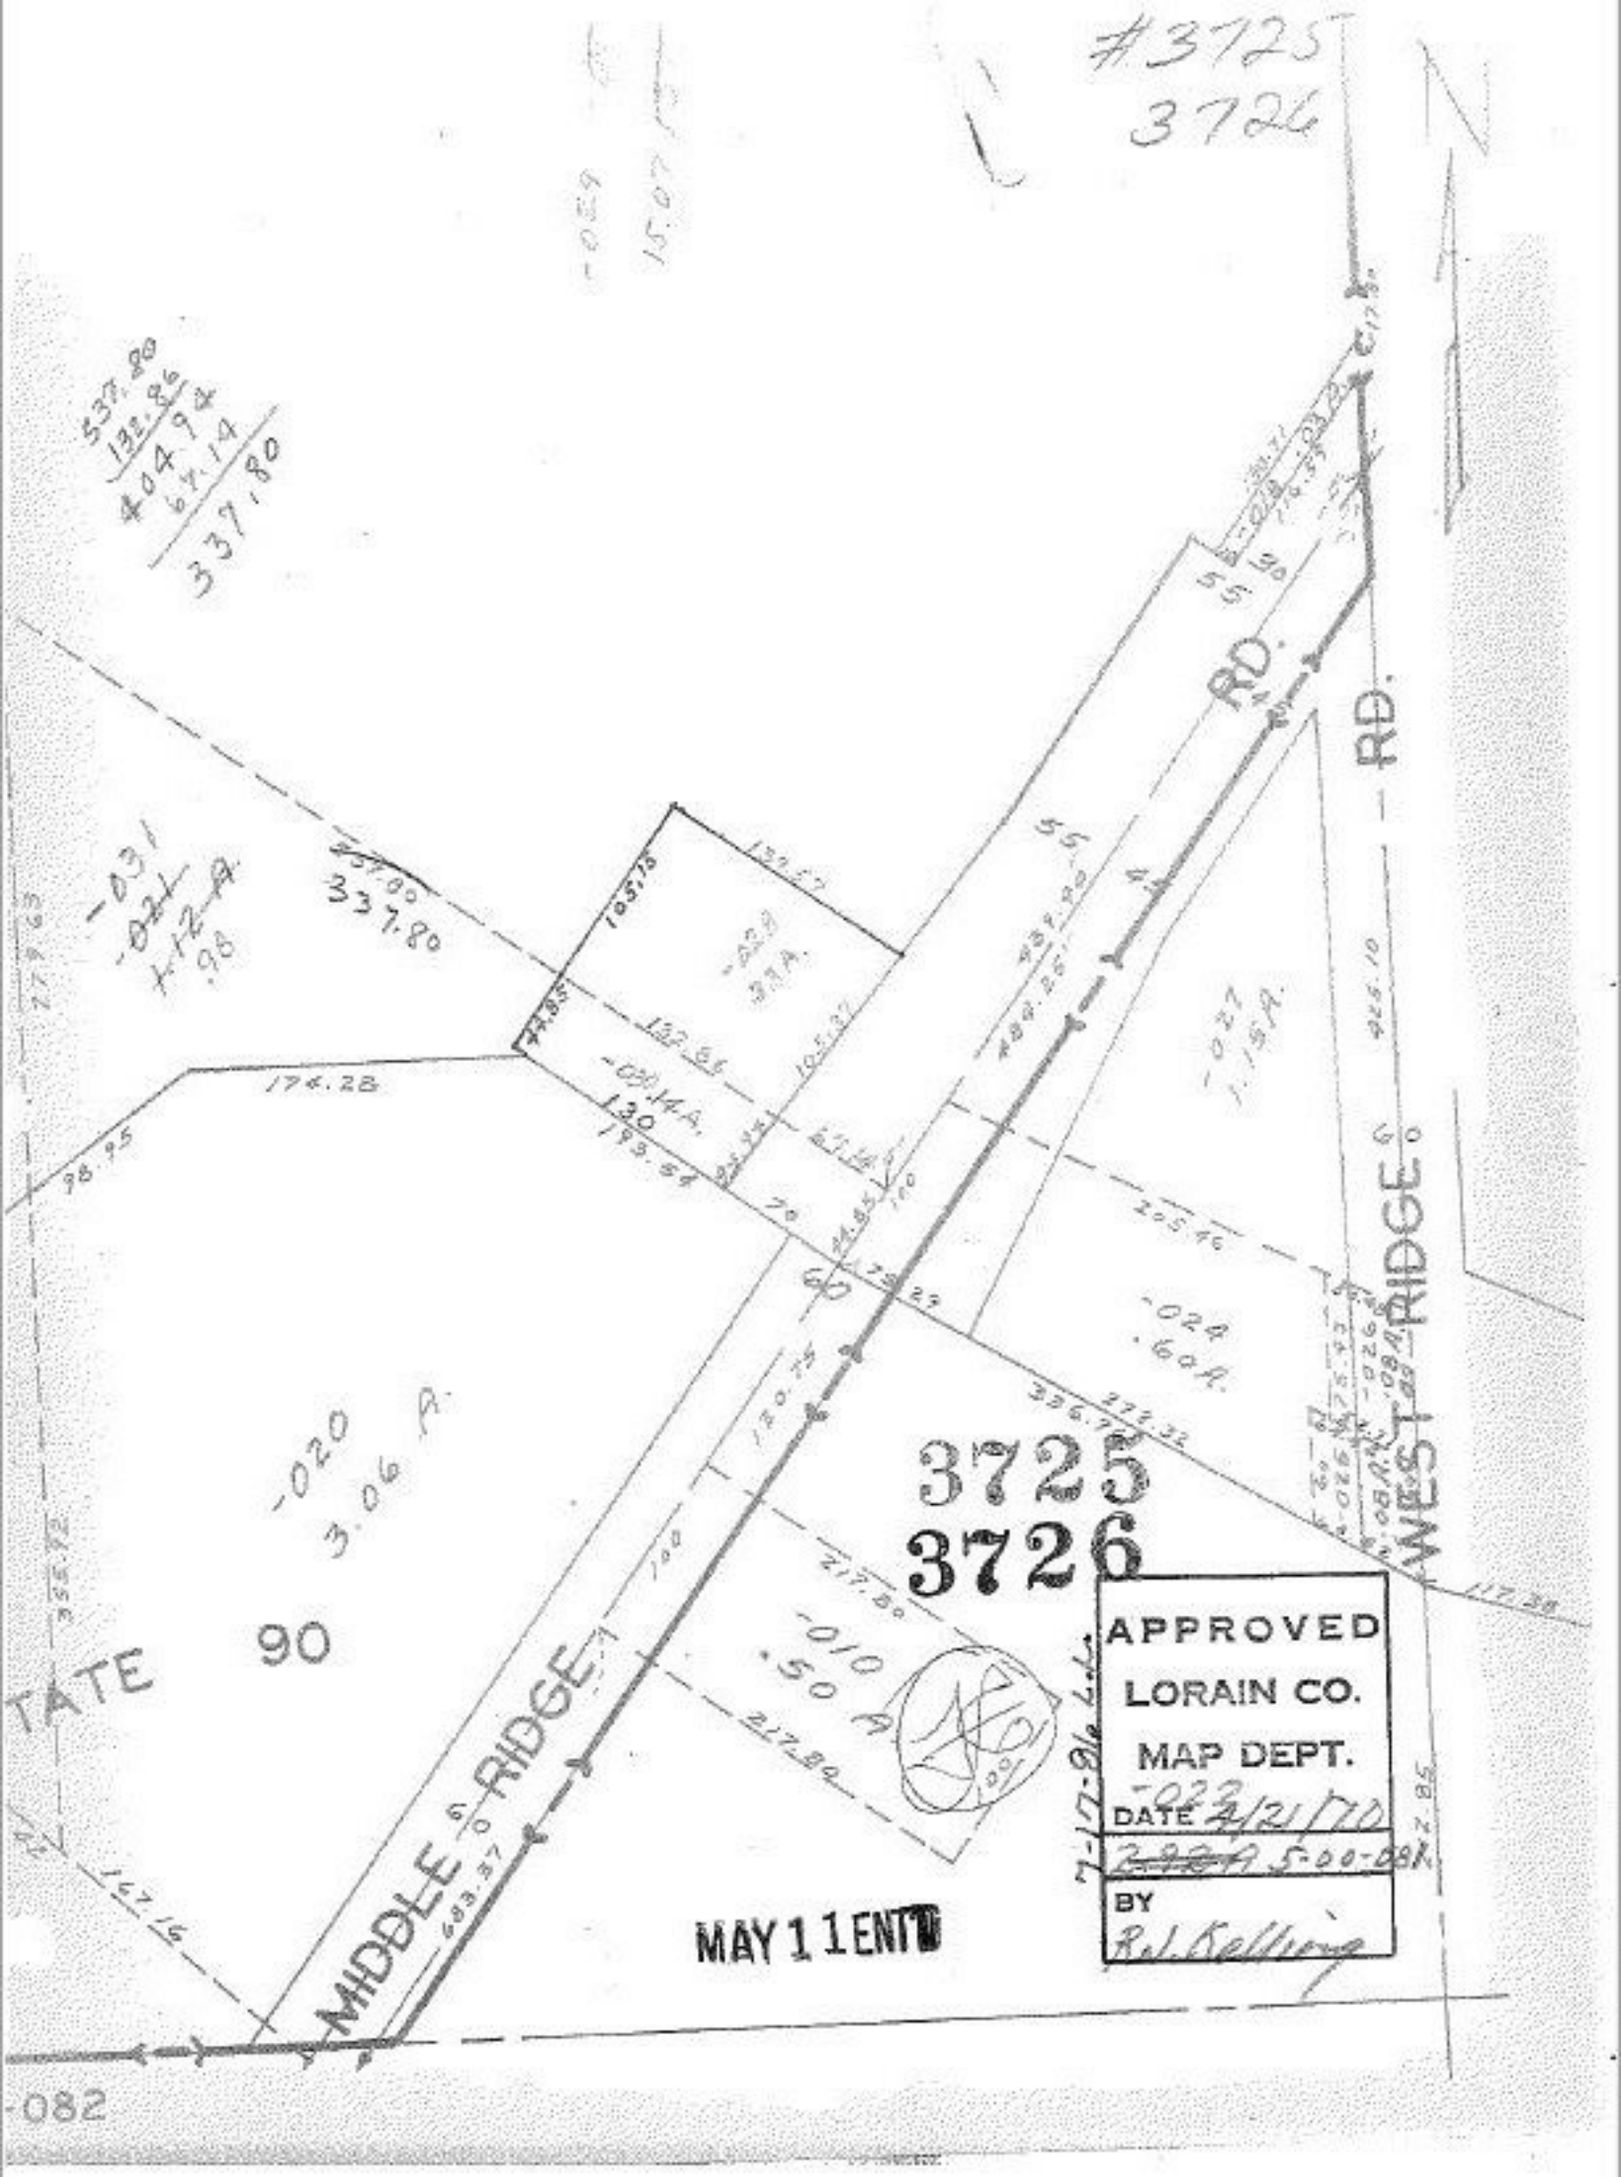
#3725
3726
N
537.80
132.86
404.94
67.14
337.80
-031
-021
1.12 A
.98
337.80
-028
3.3 A.
-030 14 A.
130
174.28
98.95
-027
1.15 A.
-024
.60 A.
-020
3.06 A.
3725
3726
-010
.50 A
TATE 90
MIDDLE RIDGE
WEST RIDGE
RD.
RD.
-082
APPROVED
LORAIN CO.
MAP DEPT.
DATE 4/21/70
BY
MAY 11 ENT'D