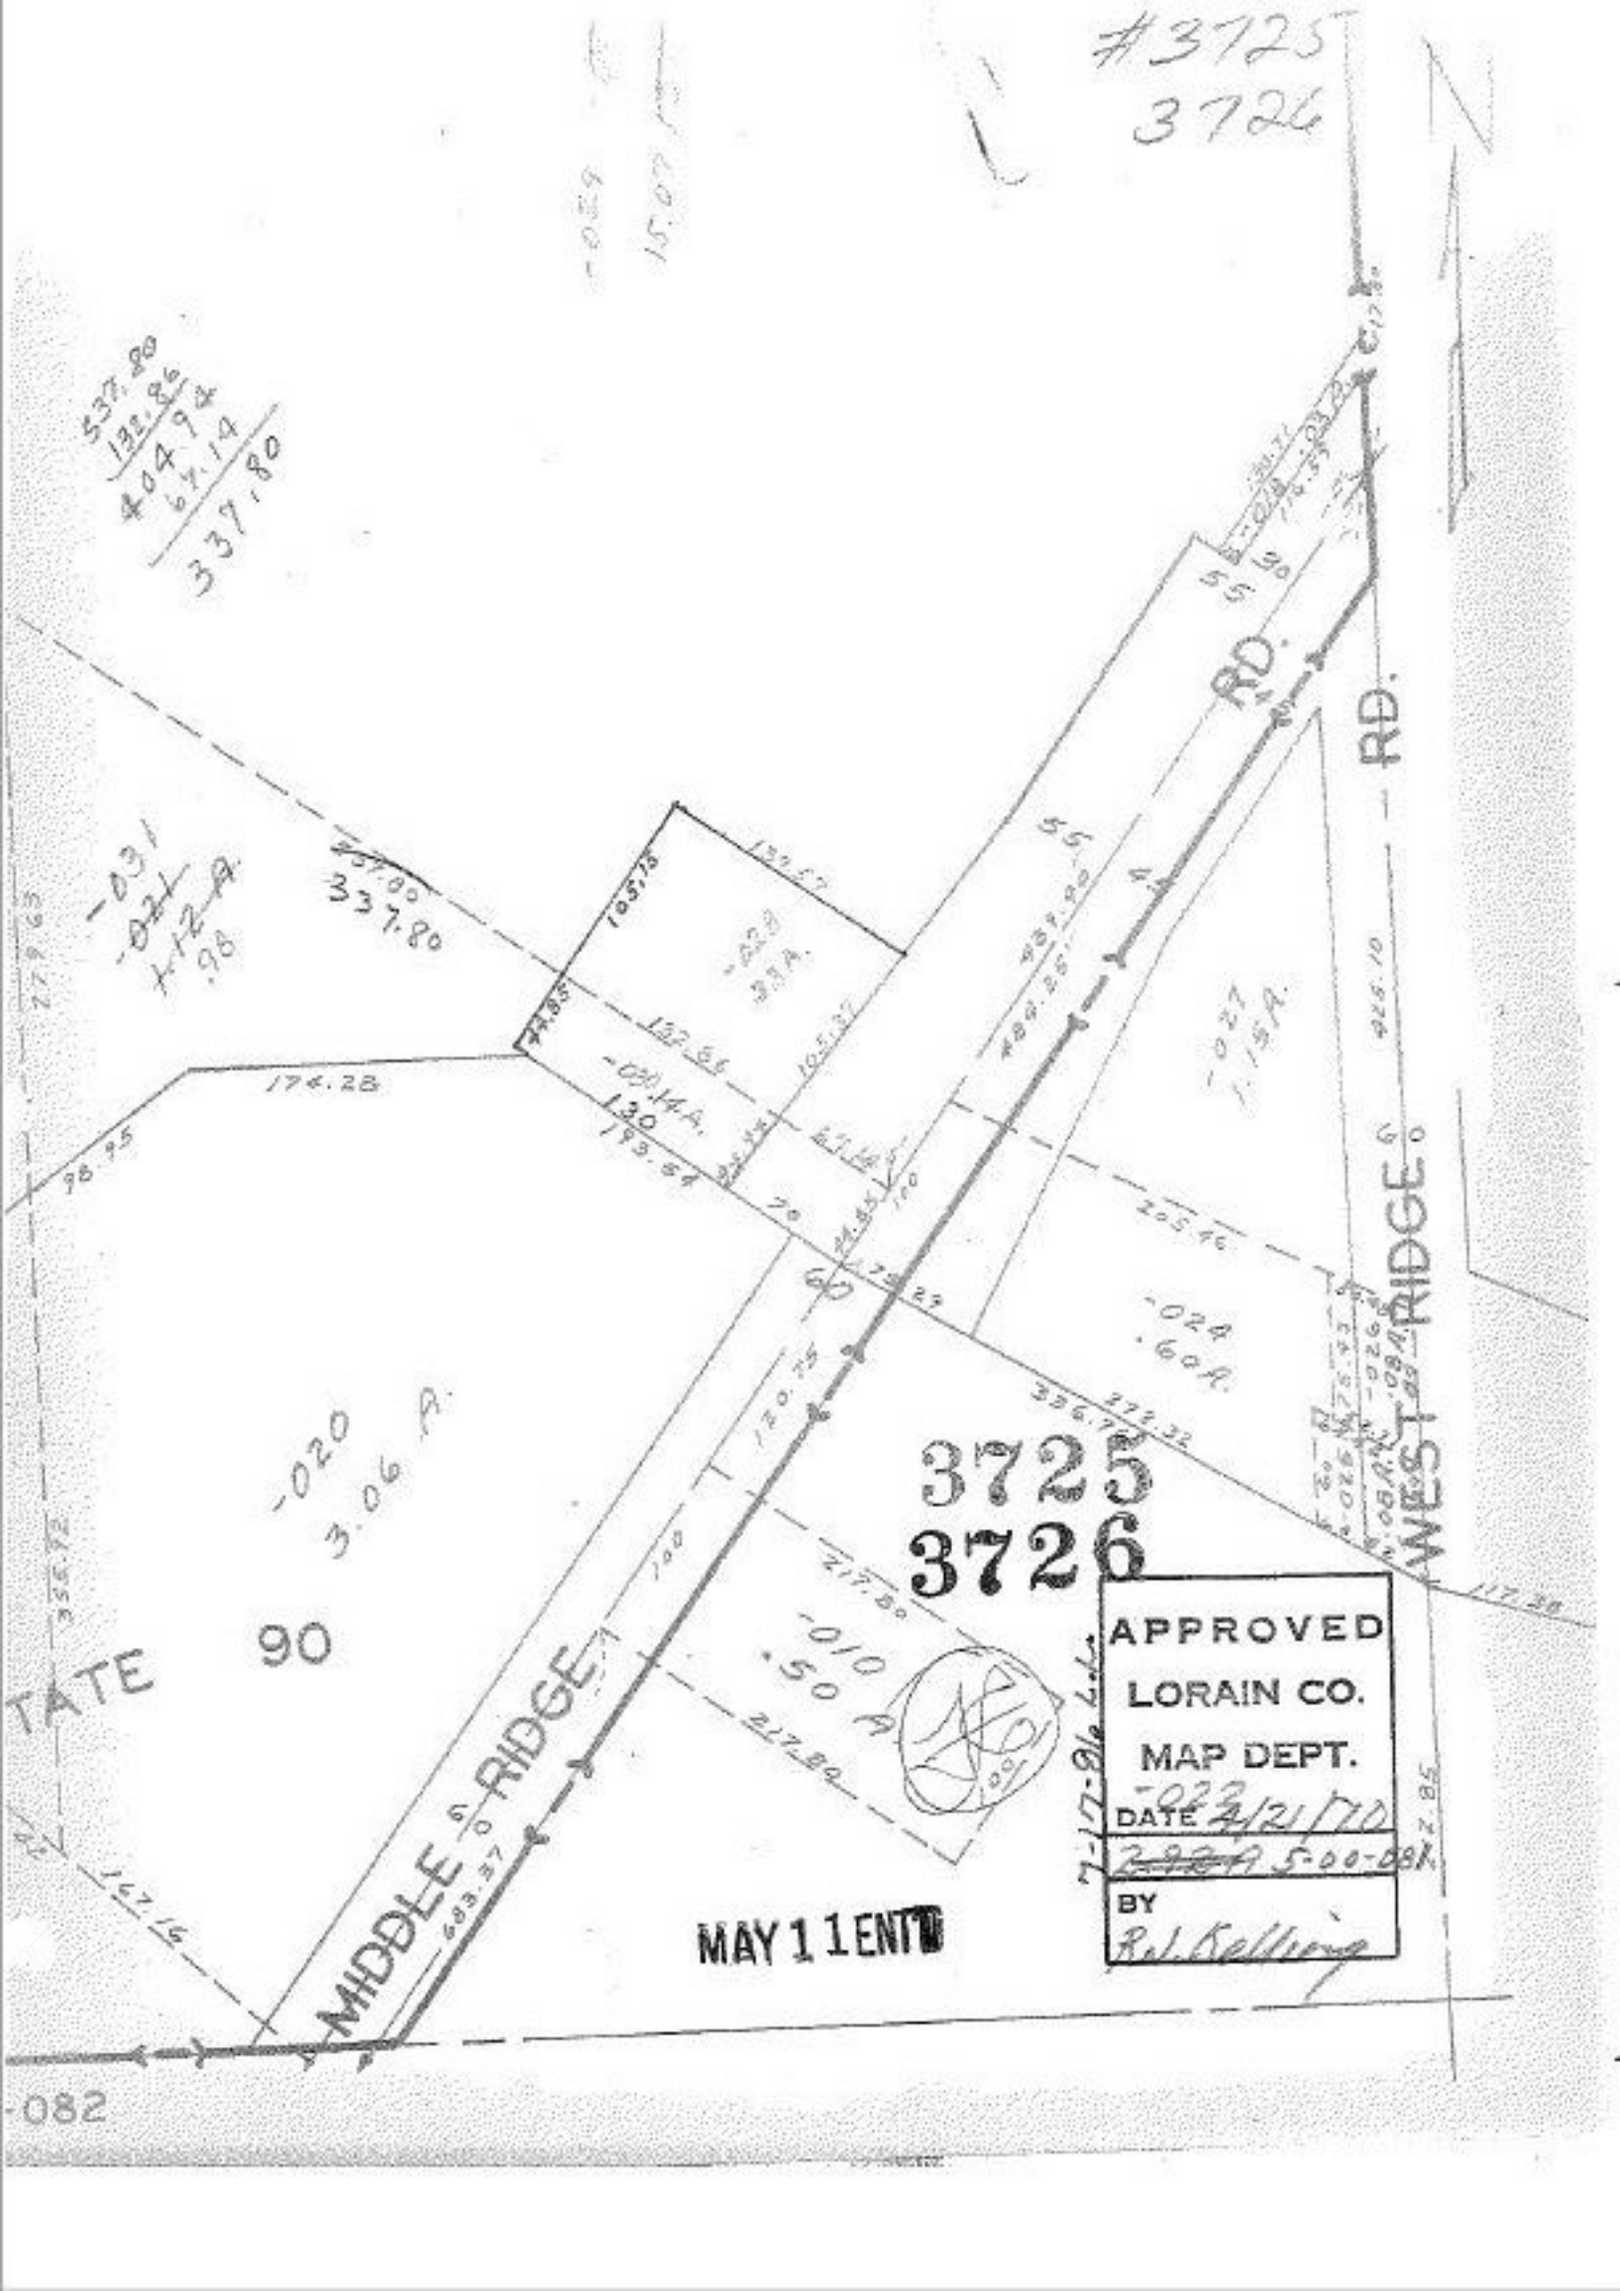
#3725
3726
537.80
132.86
404.94
67.14
337.80
-031
-021
1.12 A.
.98
337.80
-022
.38 A.
-023
.14 A.
130
174.28
98.95
-027
1.15 A.
-024
.60 A.
-020
3.06 A.
90
TATE
MIDDLE RIDGE RD.
WEST RIDGE RD.
3725
3726
-010
.50 A.
APPROVED
LORAIN CO.
MAP DEPT.
DATE 4/21/70
BY
MAY 11 ENT
-082