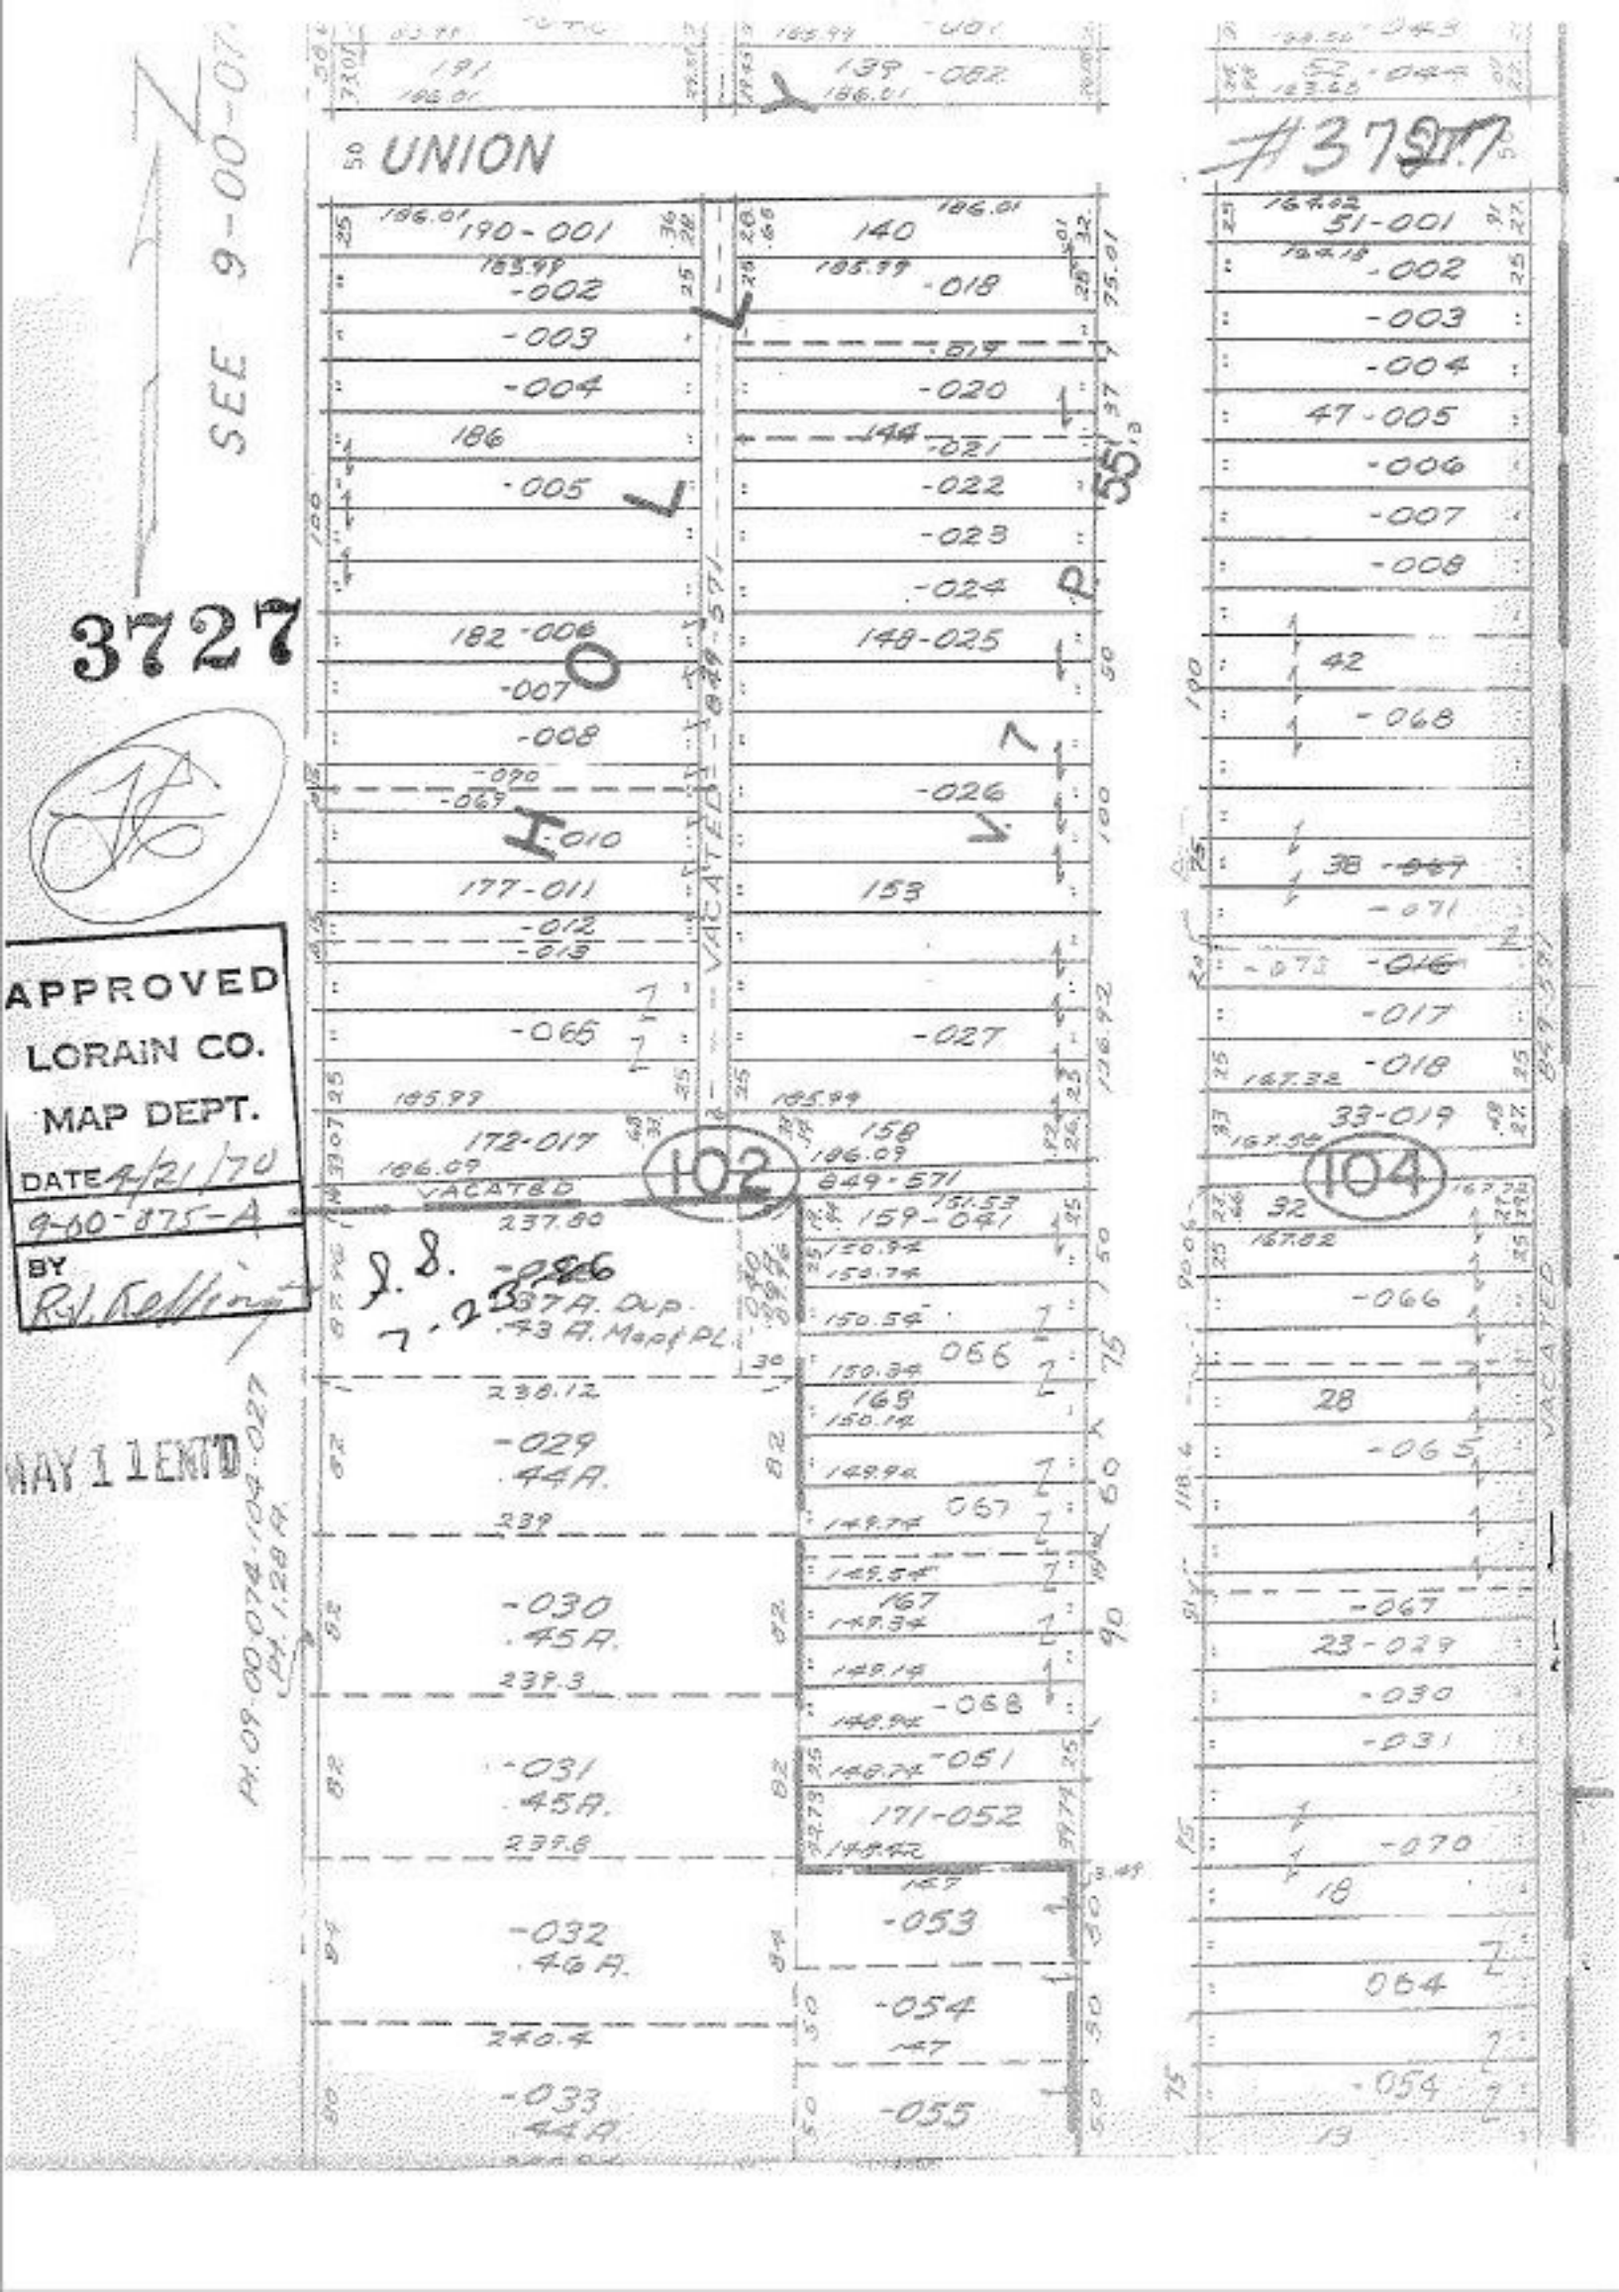
SEE 9-00-07
3727
APPROVED
LORAIN CO.
MAP DEPT.
DATE 4/21/70
9-00-875-A
BY
UNION
VACATED
102
104
MAY 11 ENT'D
#3727