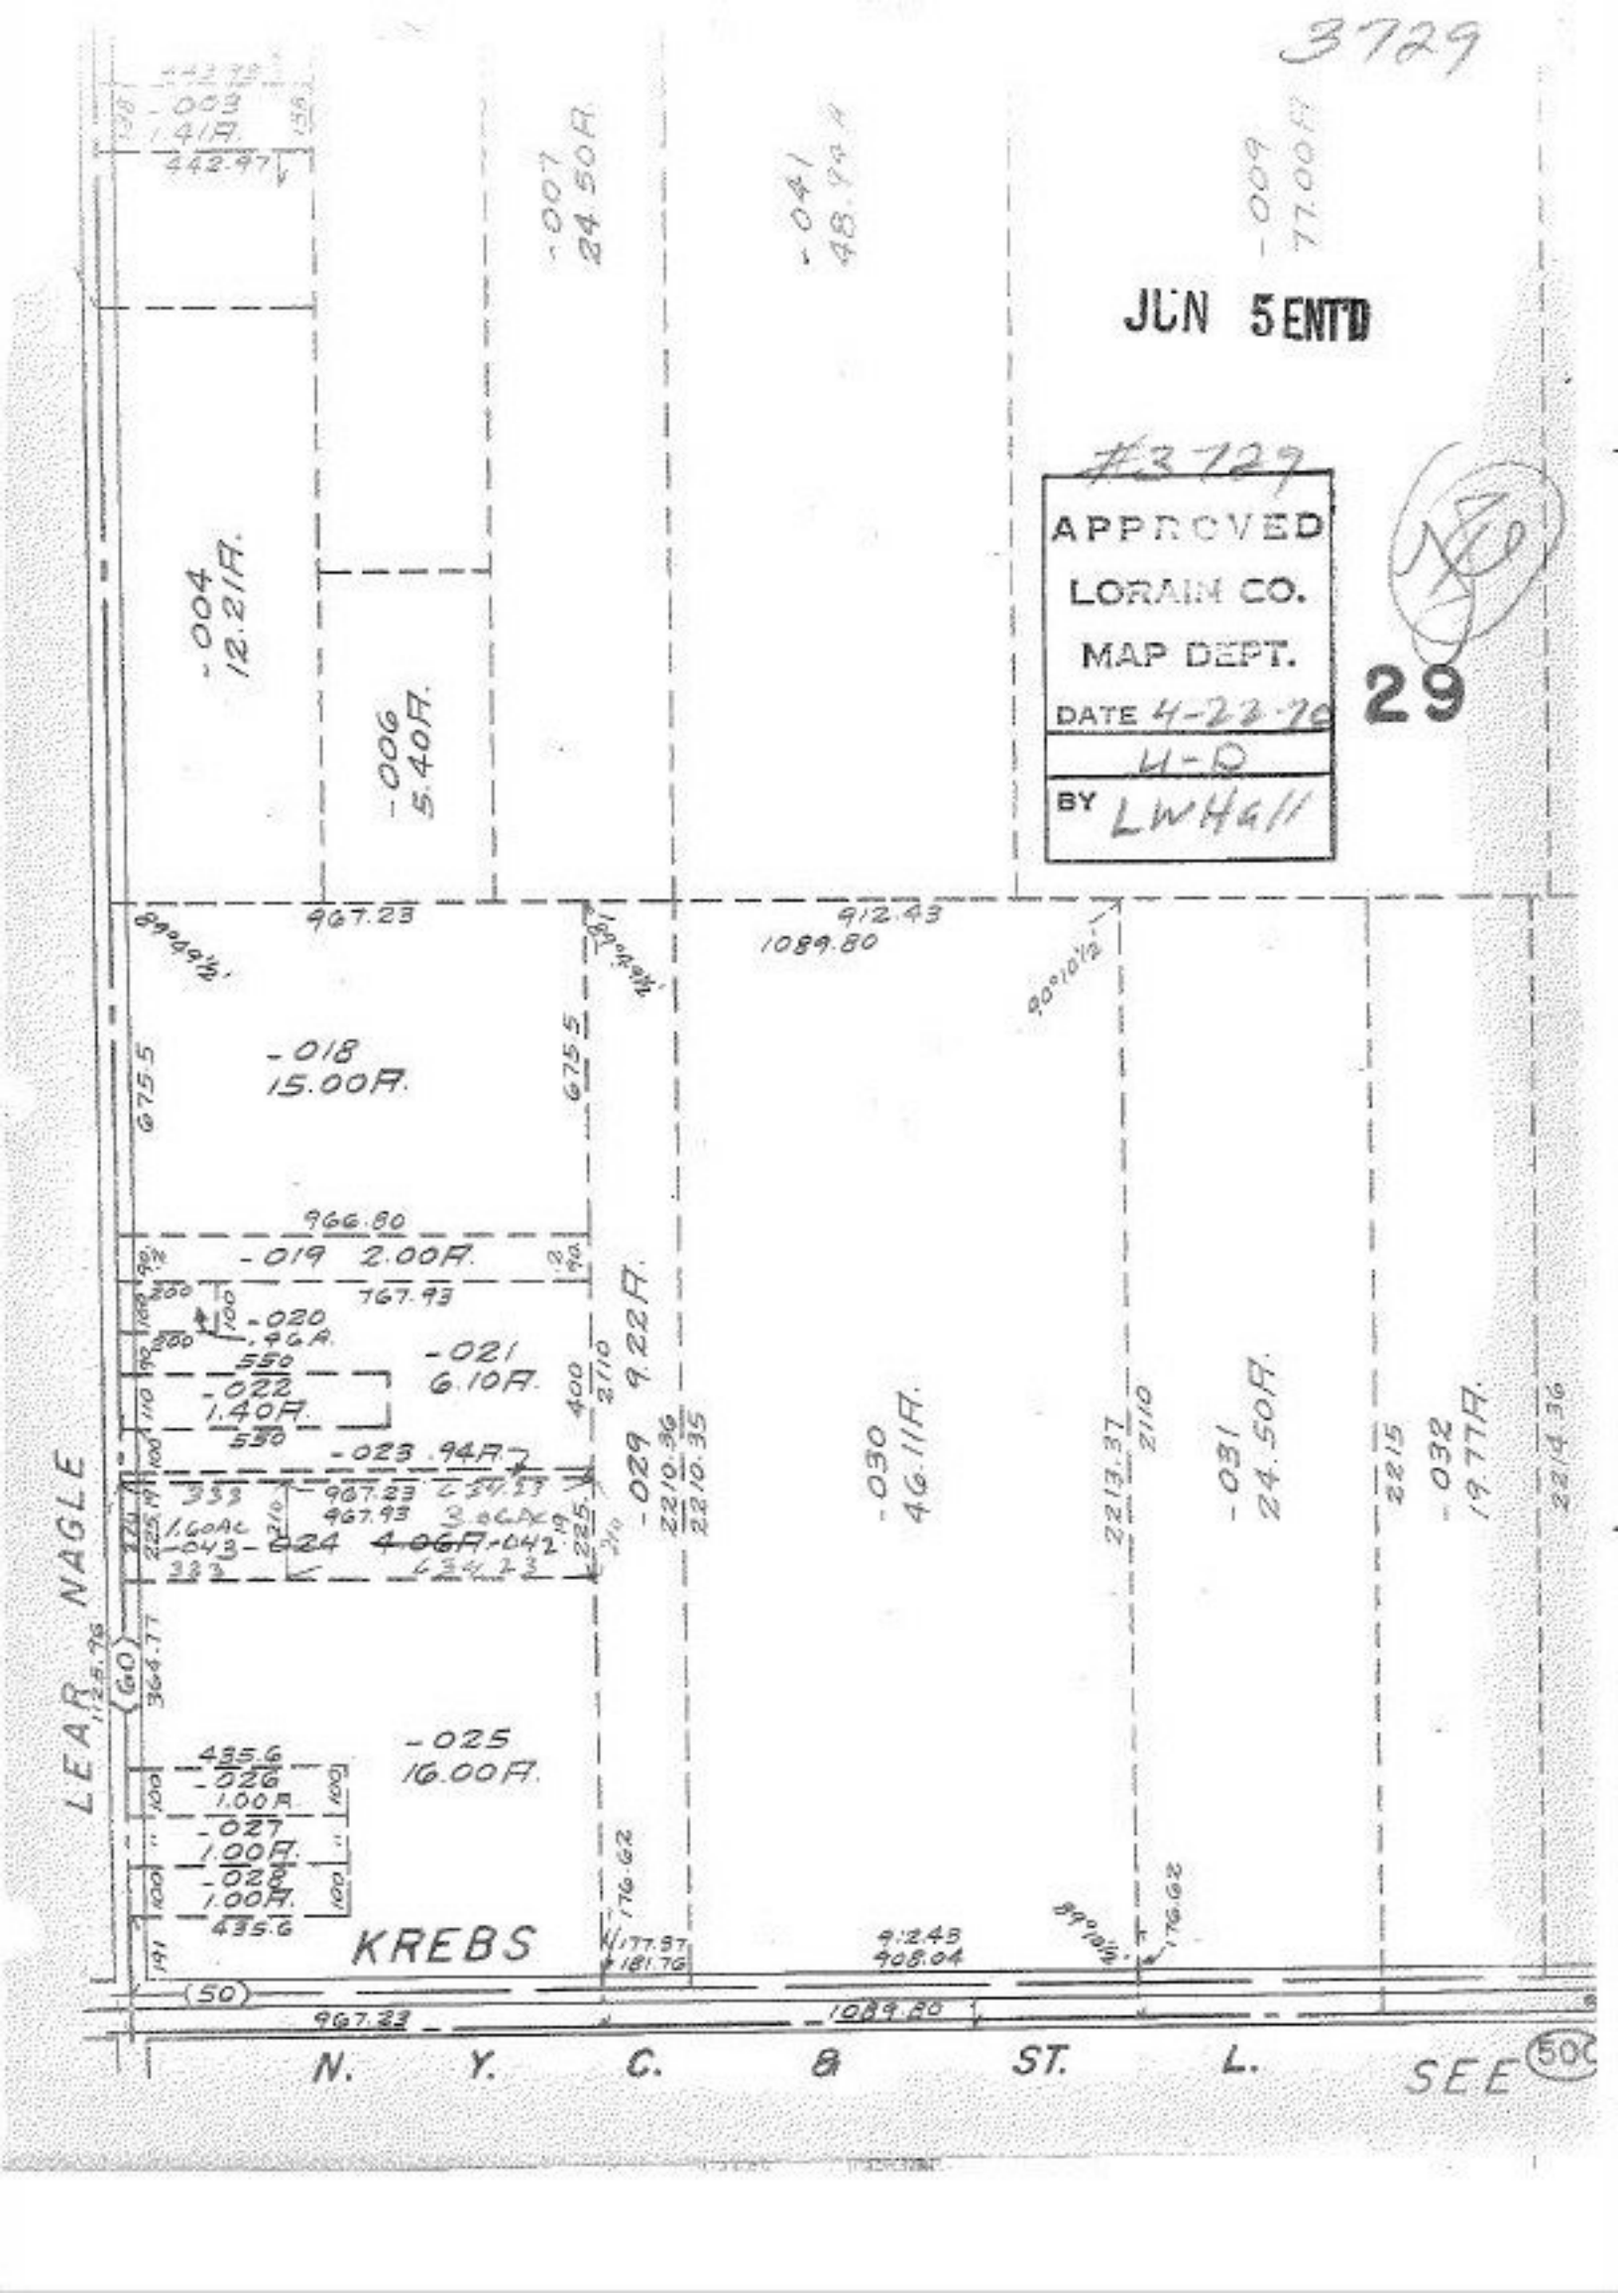
3729
JUN 5 ENTD
#3729
APPROVED
LORAIN CO.
MAP DEPT.
DATE 4-22-76
H-D
BY LWHall
29
-003 1.41A.
442.97
-007 24.50A.
-041 48.94A.
-009 77.00A.
-004 12.21A.
-006 5.40A.
967.23
912.43
1089.80
-018 15.00A.
675.5
966.80
-019 2.00A.
767.93
-020 .96A.
-021 6.10A.
-022 1.40A.
-023 .94A.
-024 4.06A.
-042 3.84A.
-043 1.60Ac.
-029 9.22A.
2210.36
2210.35
-030 46.11A.
2213.37
-031 24.50A.
2215
-032 19.77A.
2214.36
LEAR NAGLE
1125.76
364.77
-025 16.00A.
435.6
-026 1.00A.
-027 1.00A.
-028 1.00A.
KREBS
176.62
177.97
181.76
912.43
908.04
N. Y. C. & ST. L.
SEE 50