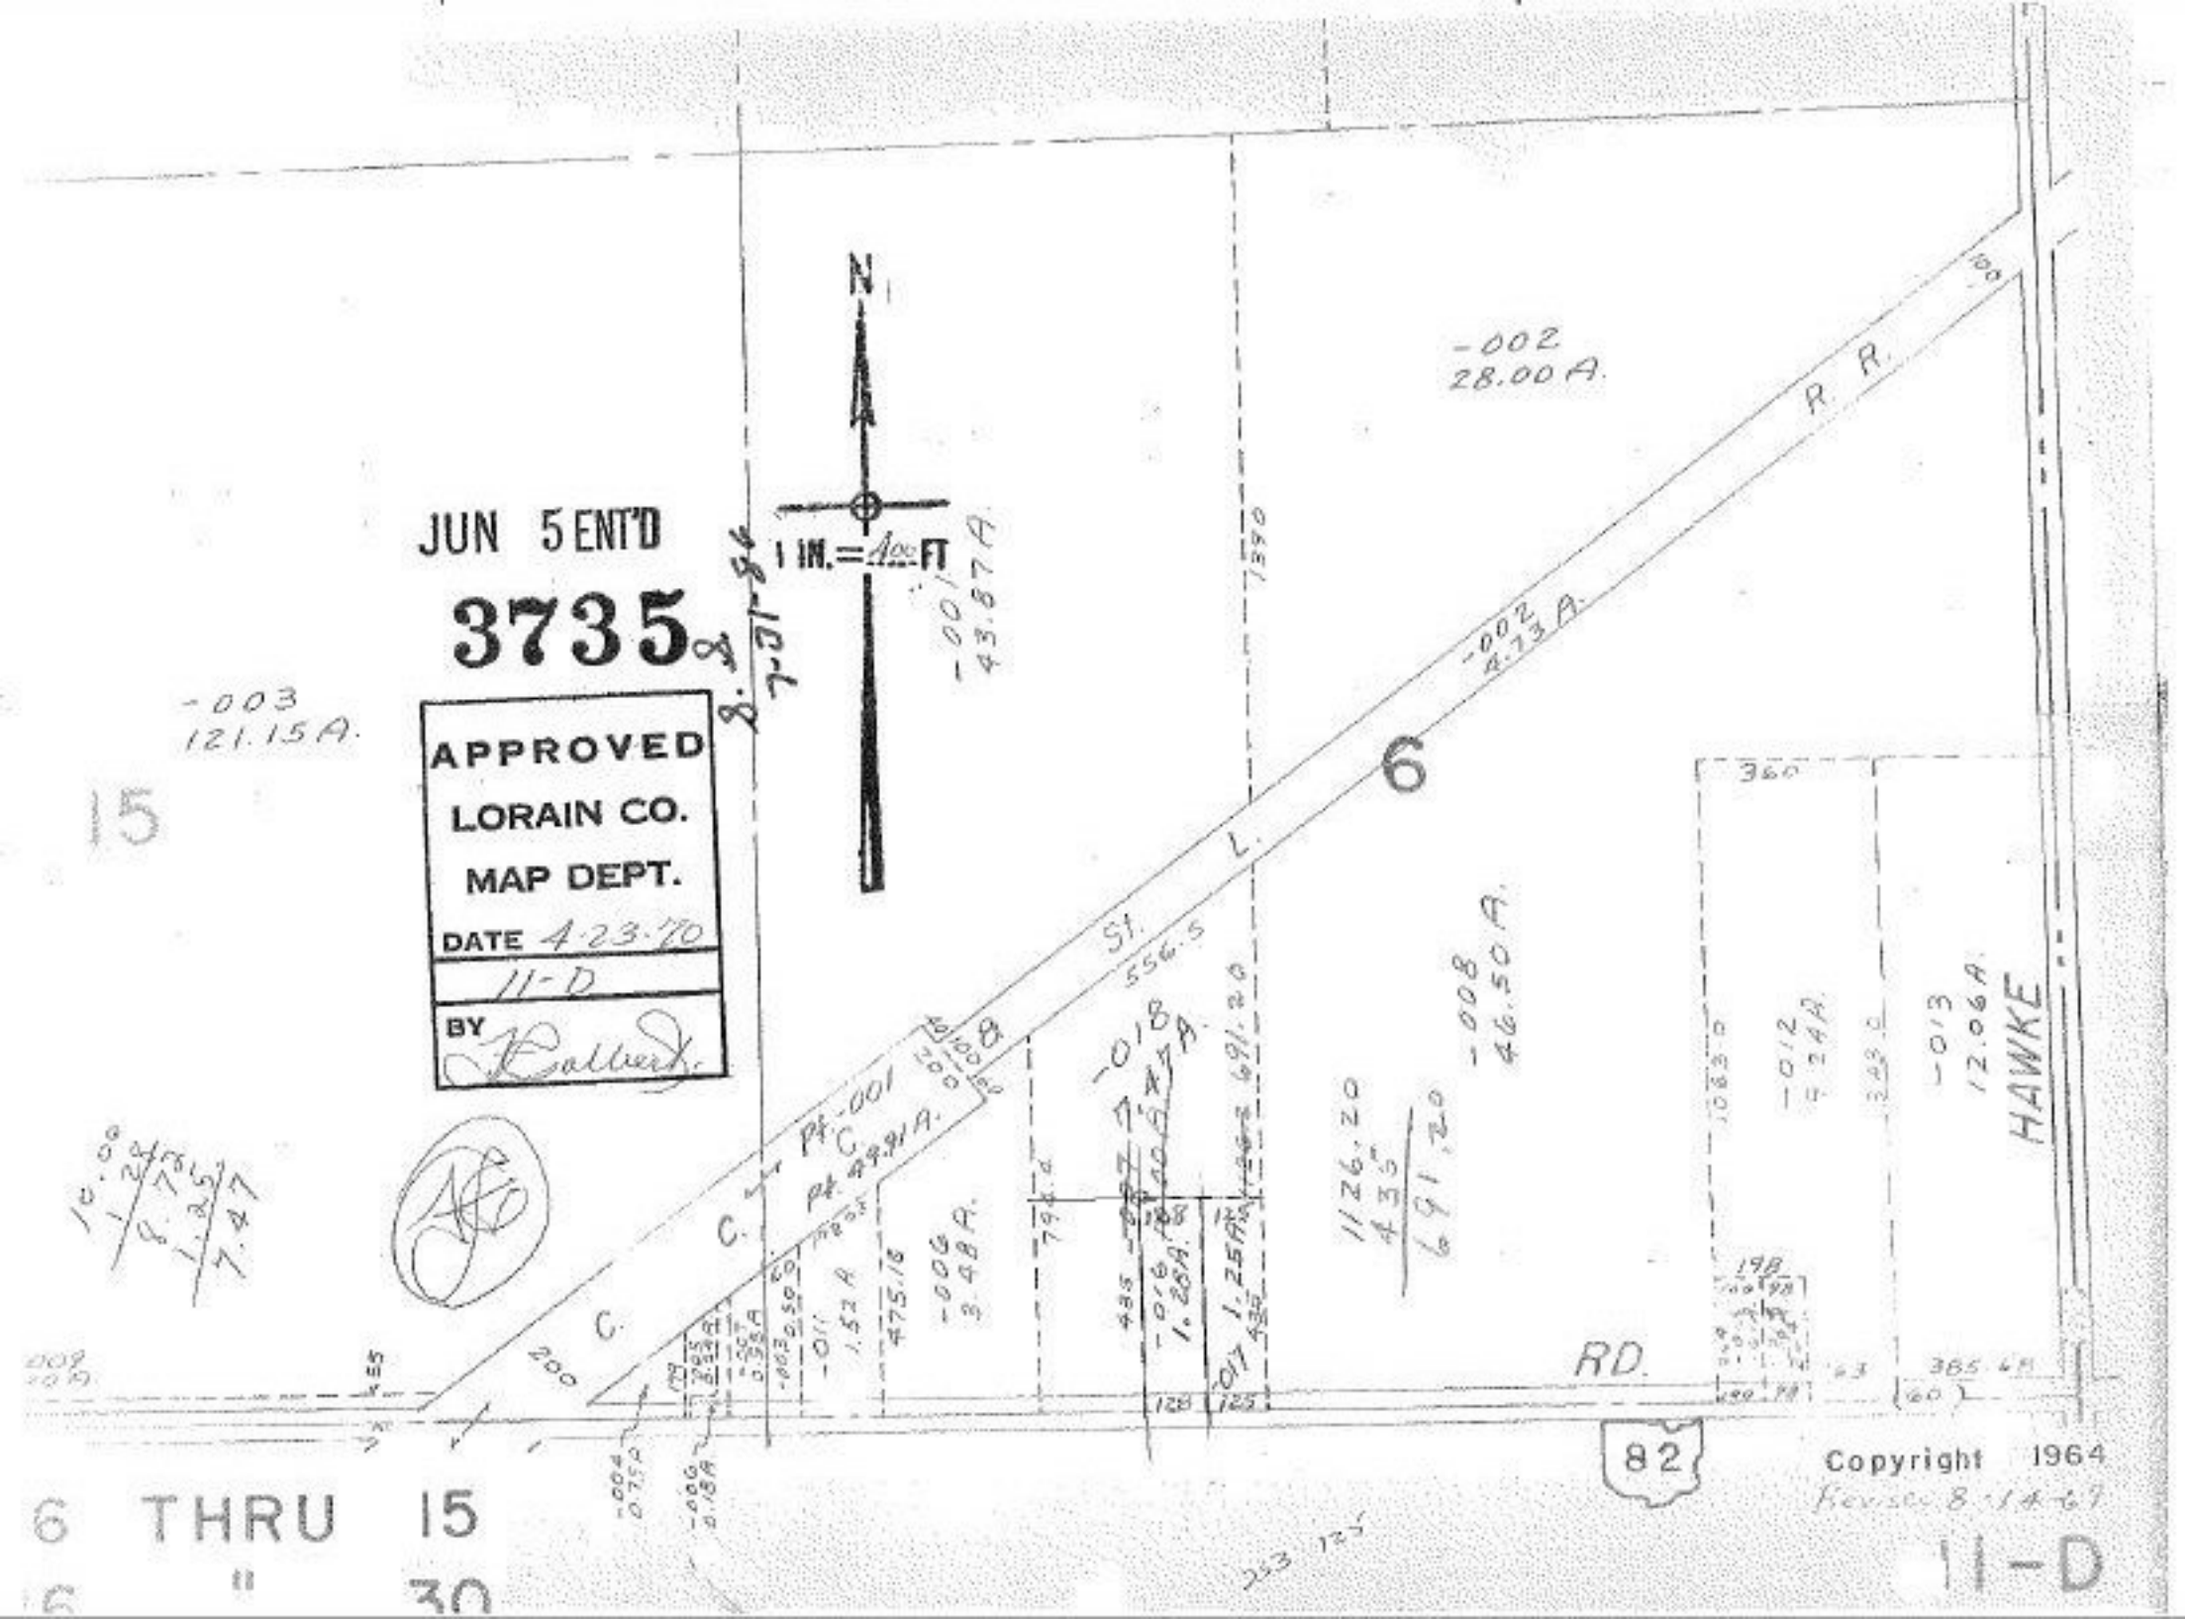

JUN 5 ENT'D
3735
APPROVED
LORAIN CO.
MAP DEPT.
DATE 4-23-70
11-D
BY
N
1 IN. = 400 FT
-002
28.00 A.
-001
43.87 A.
-003
121.15 A.
15
6
R. R.
St. L.
C. C.
Pt. -001
Pt. 49.91 A.
-002
4.73 A.
-008
46.50 A.
-013
12.06 A.
HAWKE
RD.
82
Copyright 1964
Revised 8-14-67
11-D
6 THRU 15
6 " 30