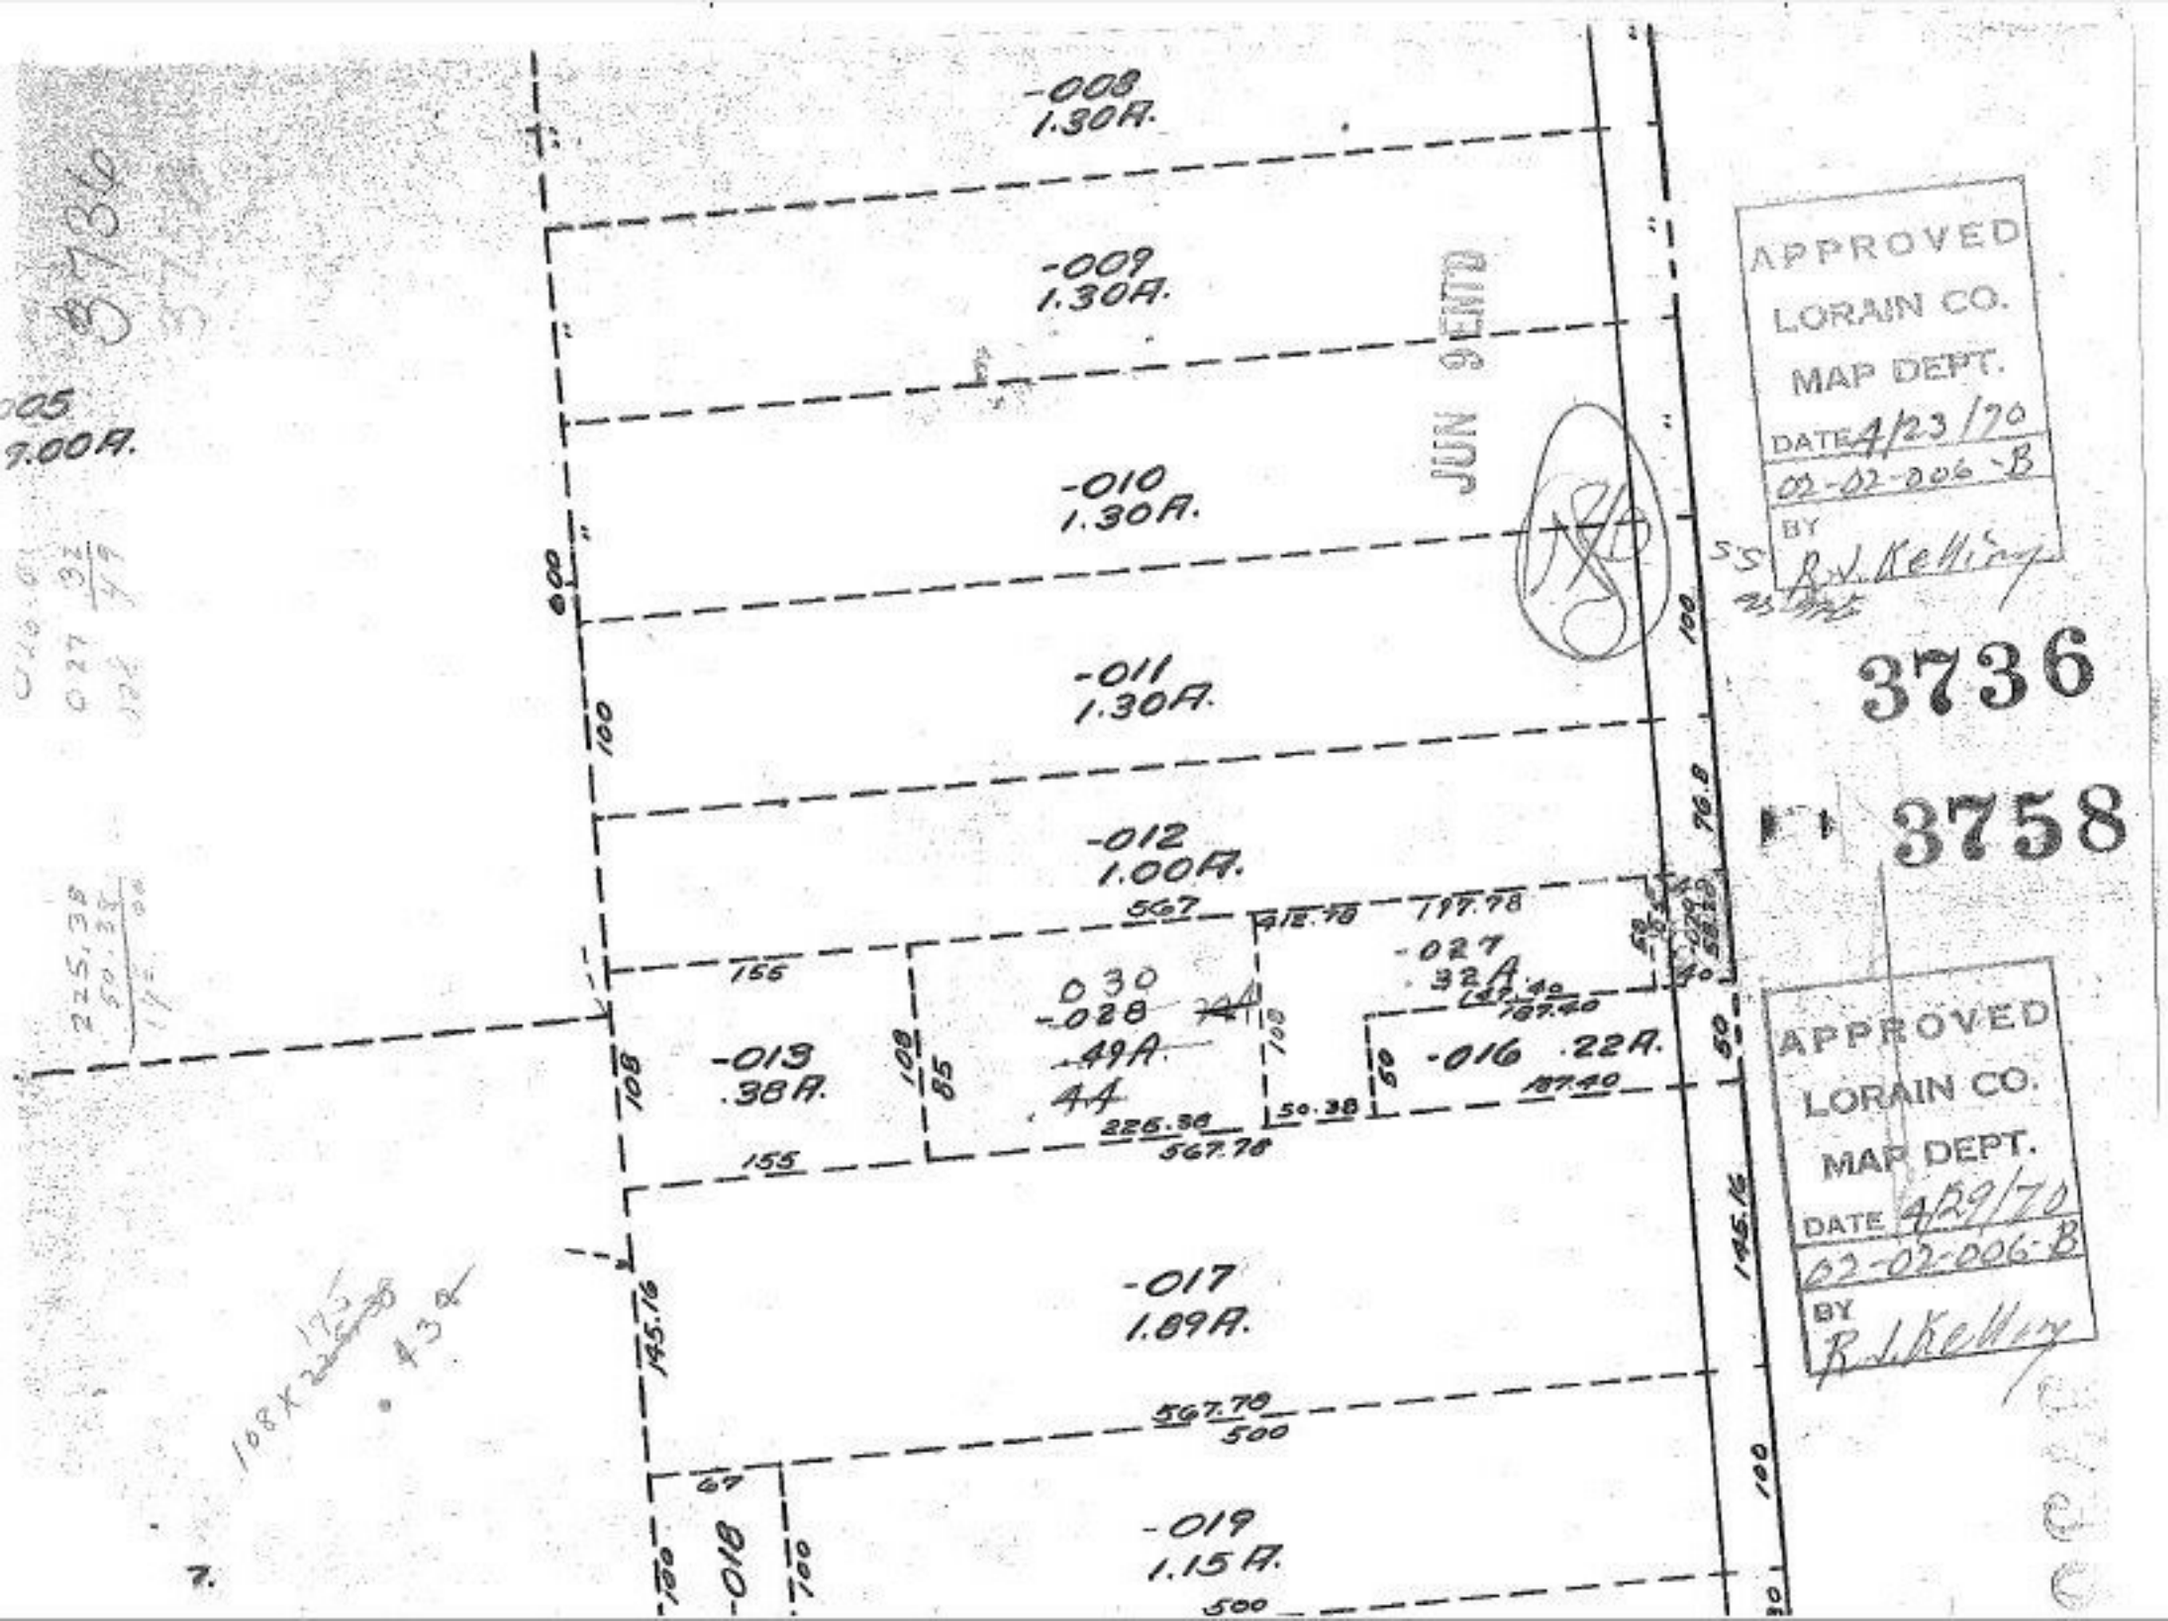

-008
1.30A.
-009
1.30A.
-010
1.30A.
-011
1.30A.
-012
1.00A.
-013
.38A.
-016
.22A.
-017
1.89A.
-018
-019
1.15A.
-027
.32A.
-028
.49A.
.44
.030
JUN 9 ENT'D
APPROVED
LORAIN CO.
MAP DEPT.
DATE 4/23/70
02-02-006-B
BY R.J. Kelling
3736
3758
APPROVED
LORAIN CO.
MAP DEPT.
DATE 4/29/70
02-02-006-B
BY R.J. Kelling