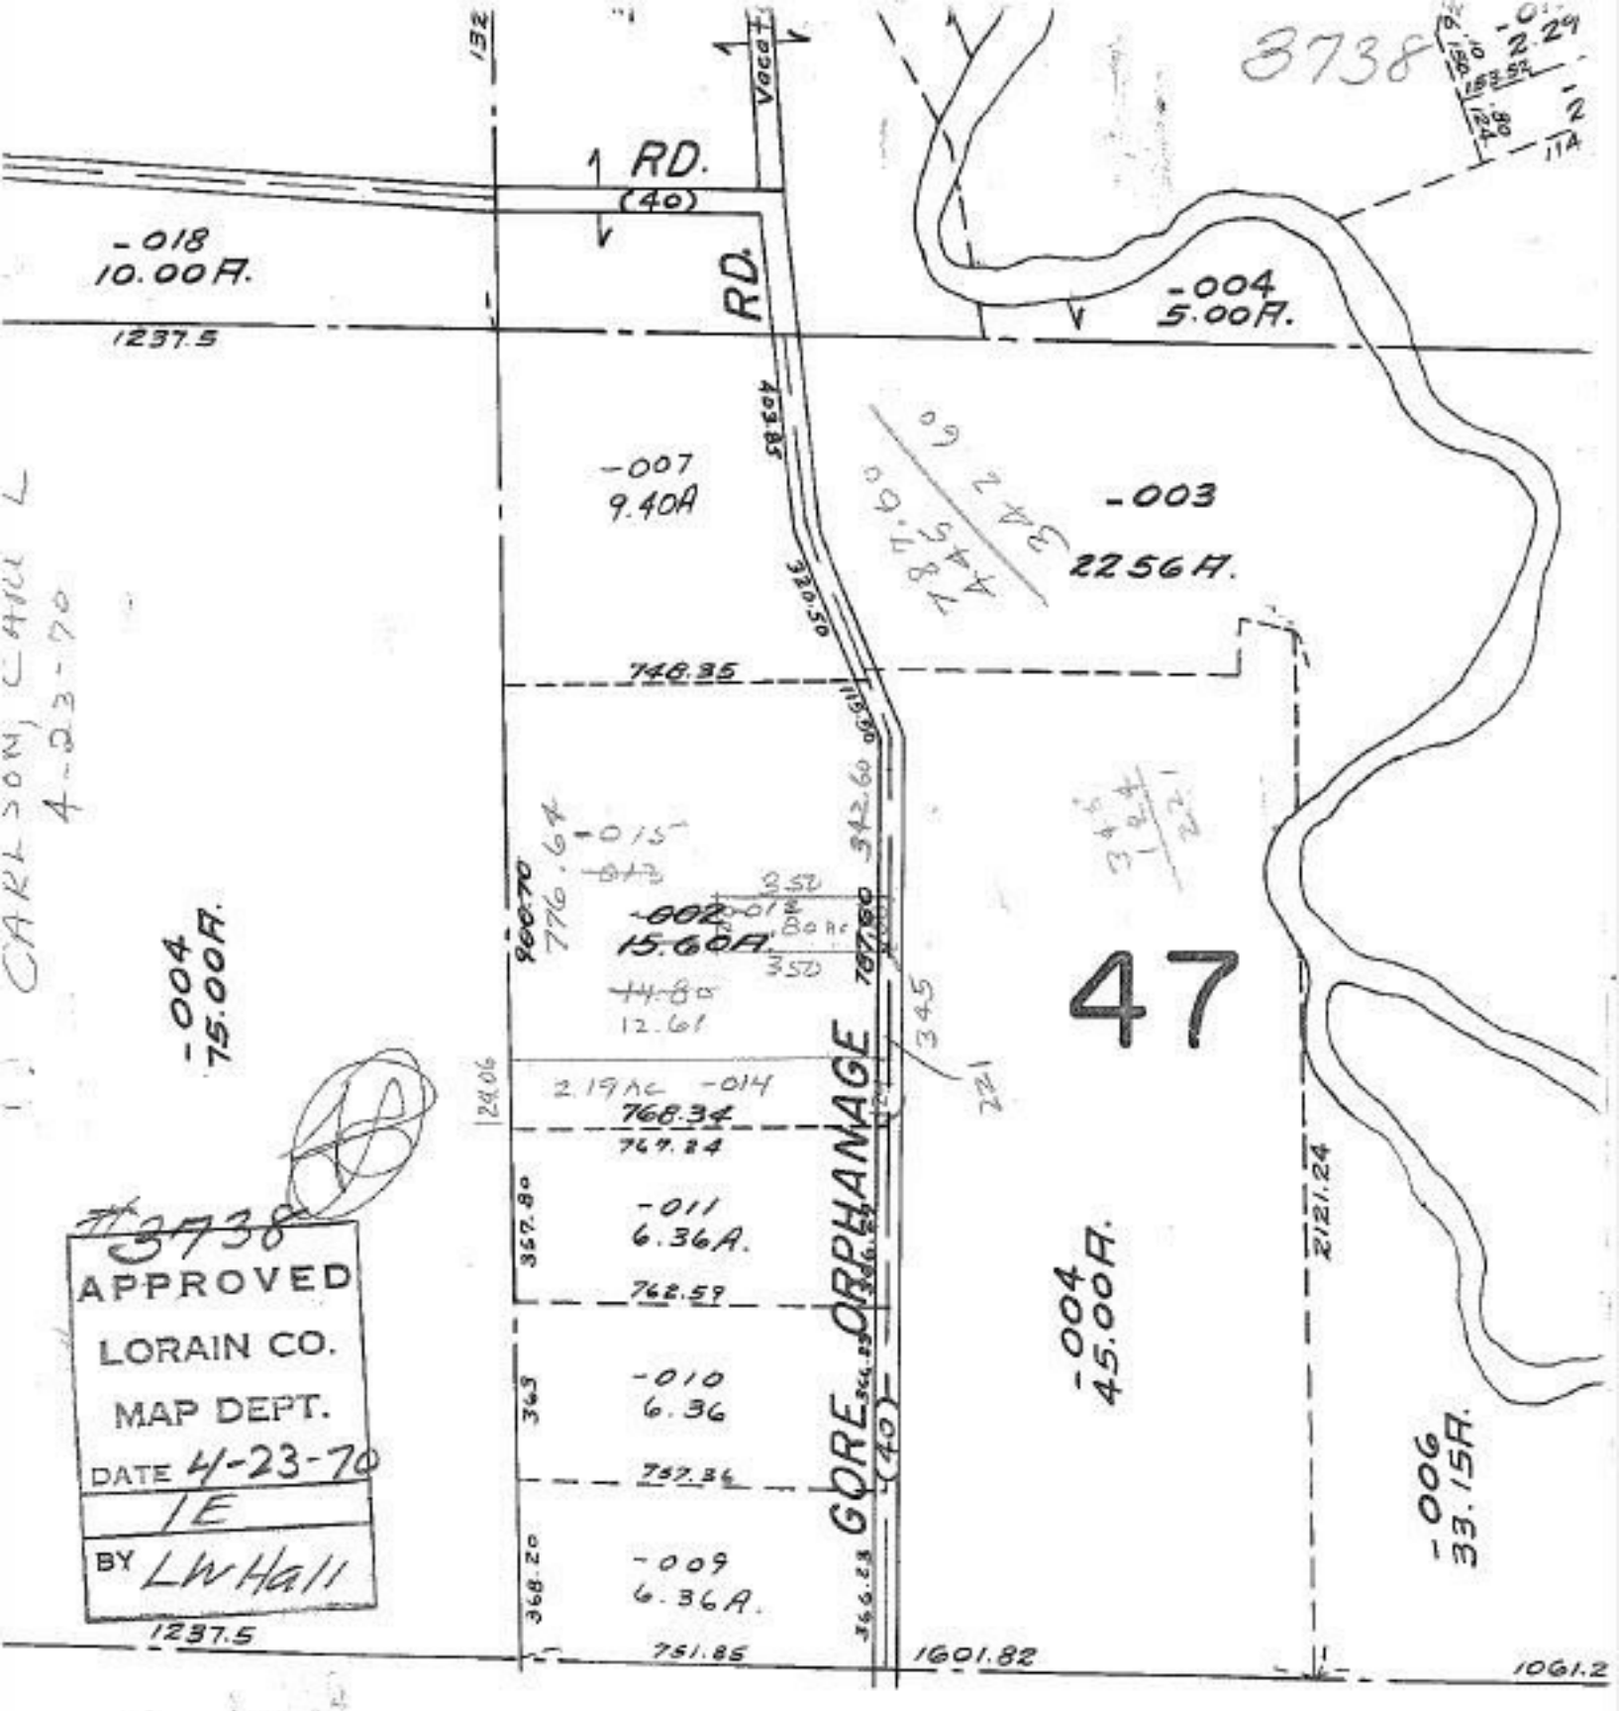

LOTS 17, 18, 31 THRU 34, 47,
GORE STRIP PT. LOT 27