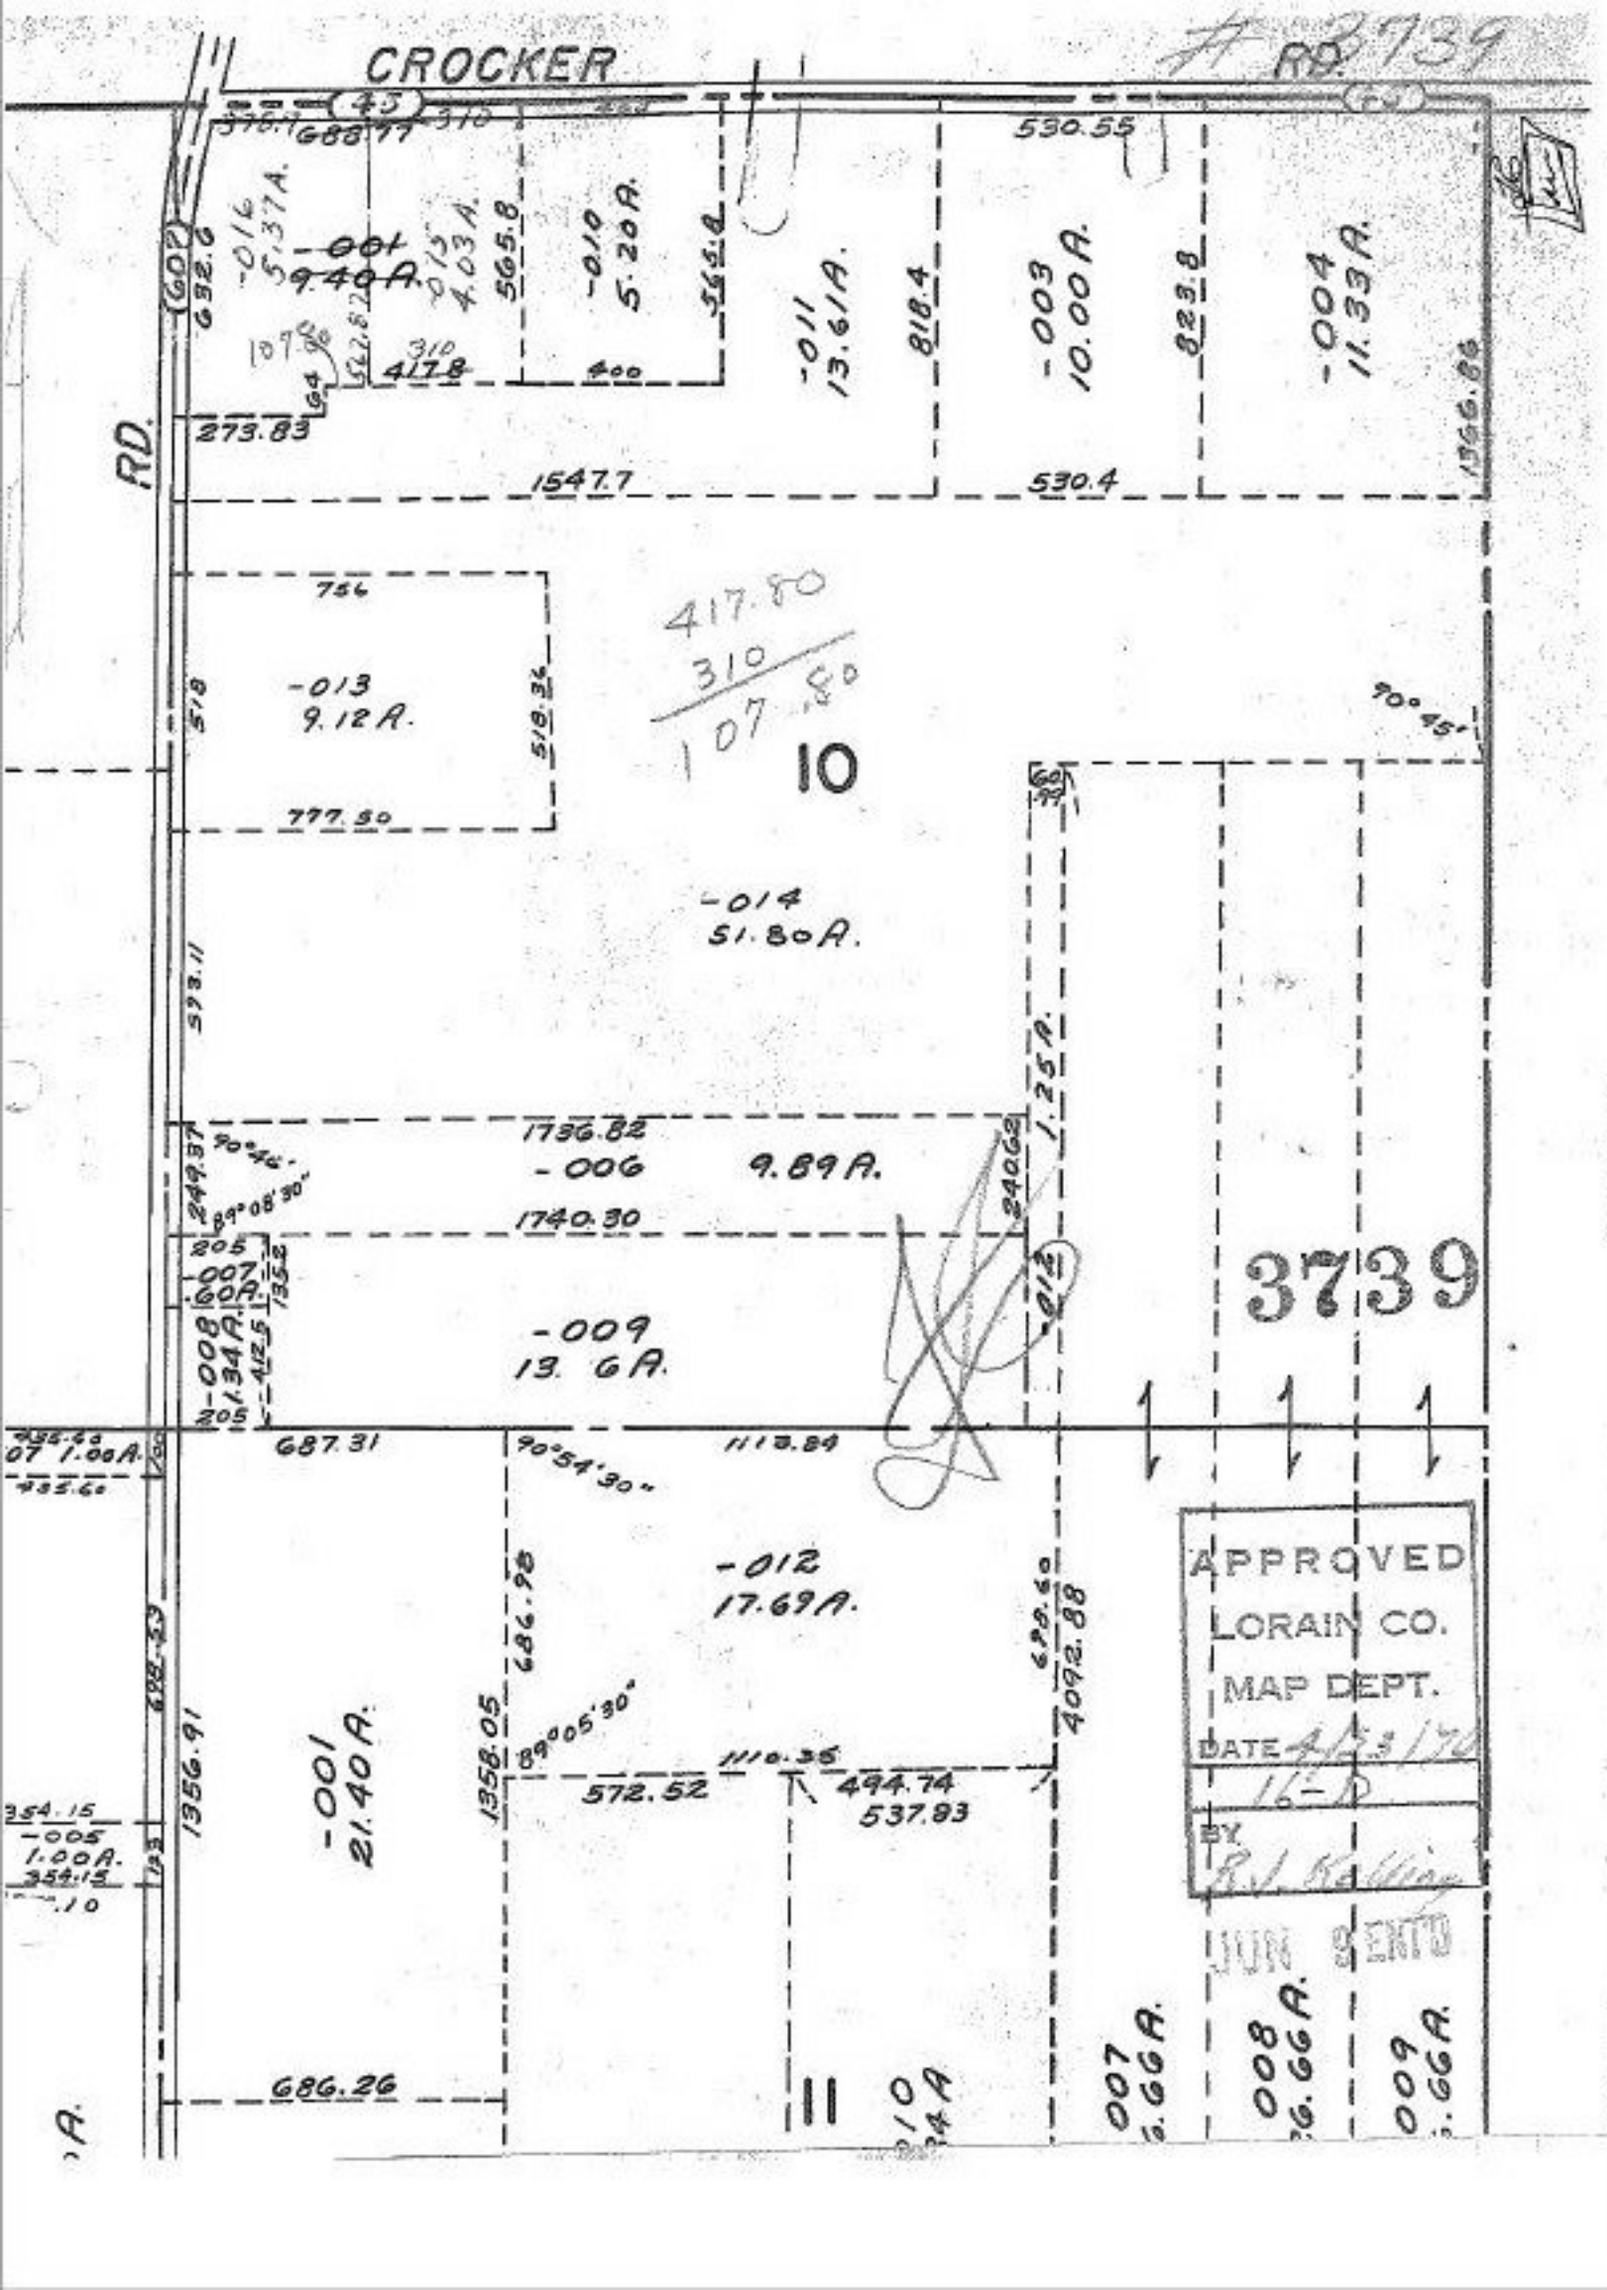
CROCKER
RD.
3739
APPROVED
LORAIN CO.
MAP DEPT.
DATE 4/23/70
BY R.V. Kellin
JUN SENTO
10
-001 9.40A.
-003 10.00A.
-004 11.33A.
-005 1.00A.
-006 9.89A.
-007 1.00A.
-009 13.6A.
-010 5.20A.
-011 13.61A.
-012 17.69A.
-013 9.12A.
-014 51.80A.
1.25A.
2.34A.
417.80
310
107.50
1547.7
530.4
1740.30
1736.82
1358.05
1356.91
1110.36
1113.84
687.31
686.26
572.52
494.74
537.83
818.4
565.8
523.8
692.6
273.83
777.50
518.34
523.11
249.87
240.62
1366.86
4092.88
686.98
682.33