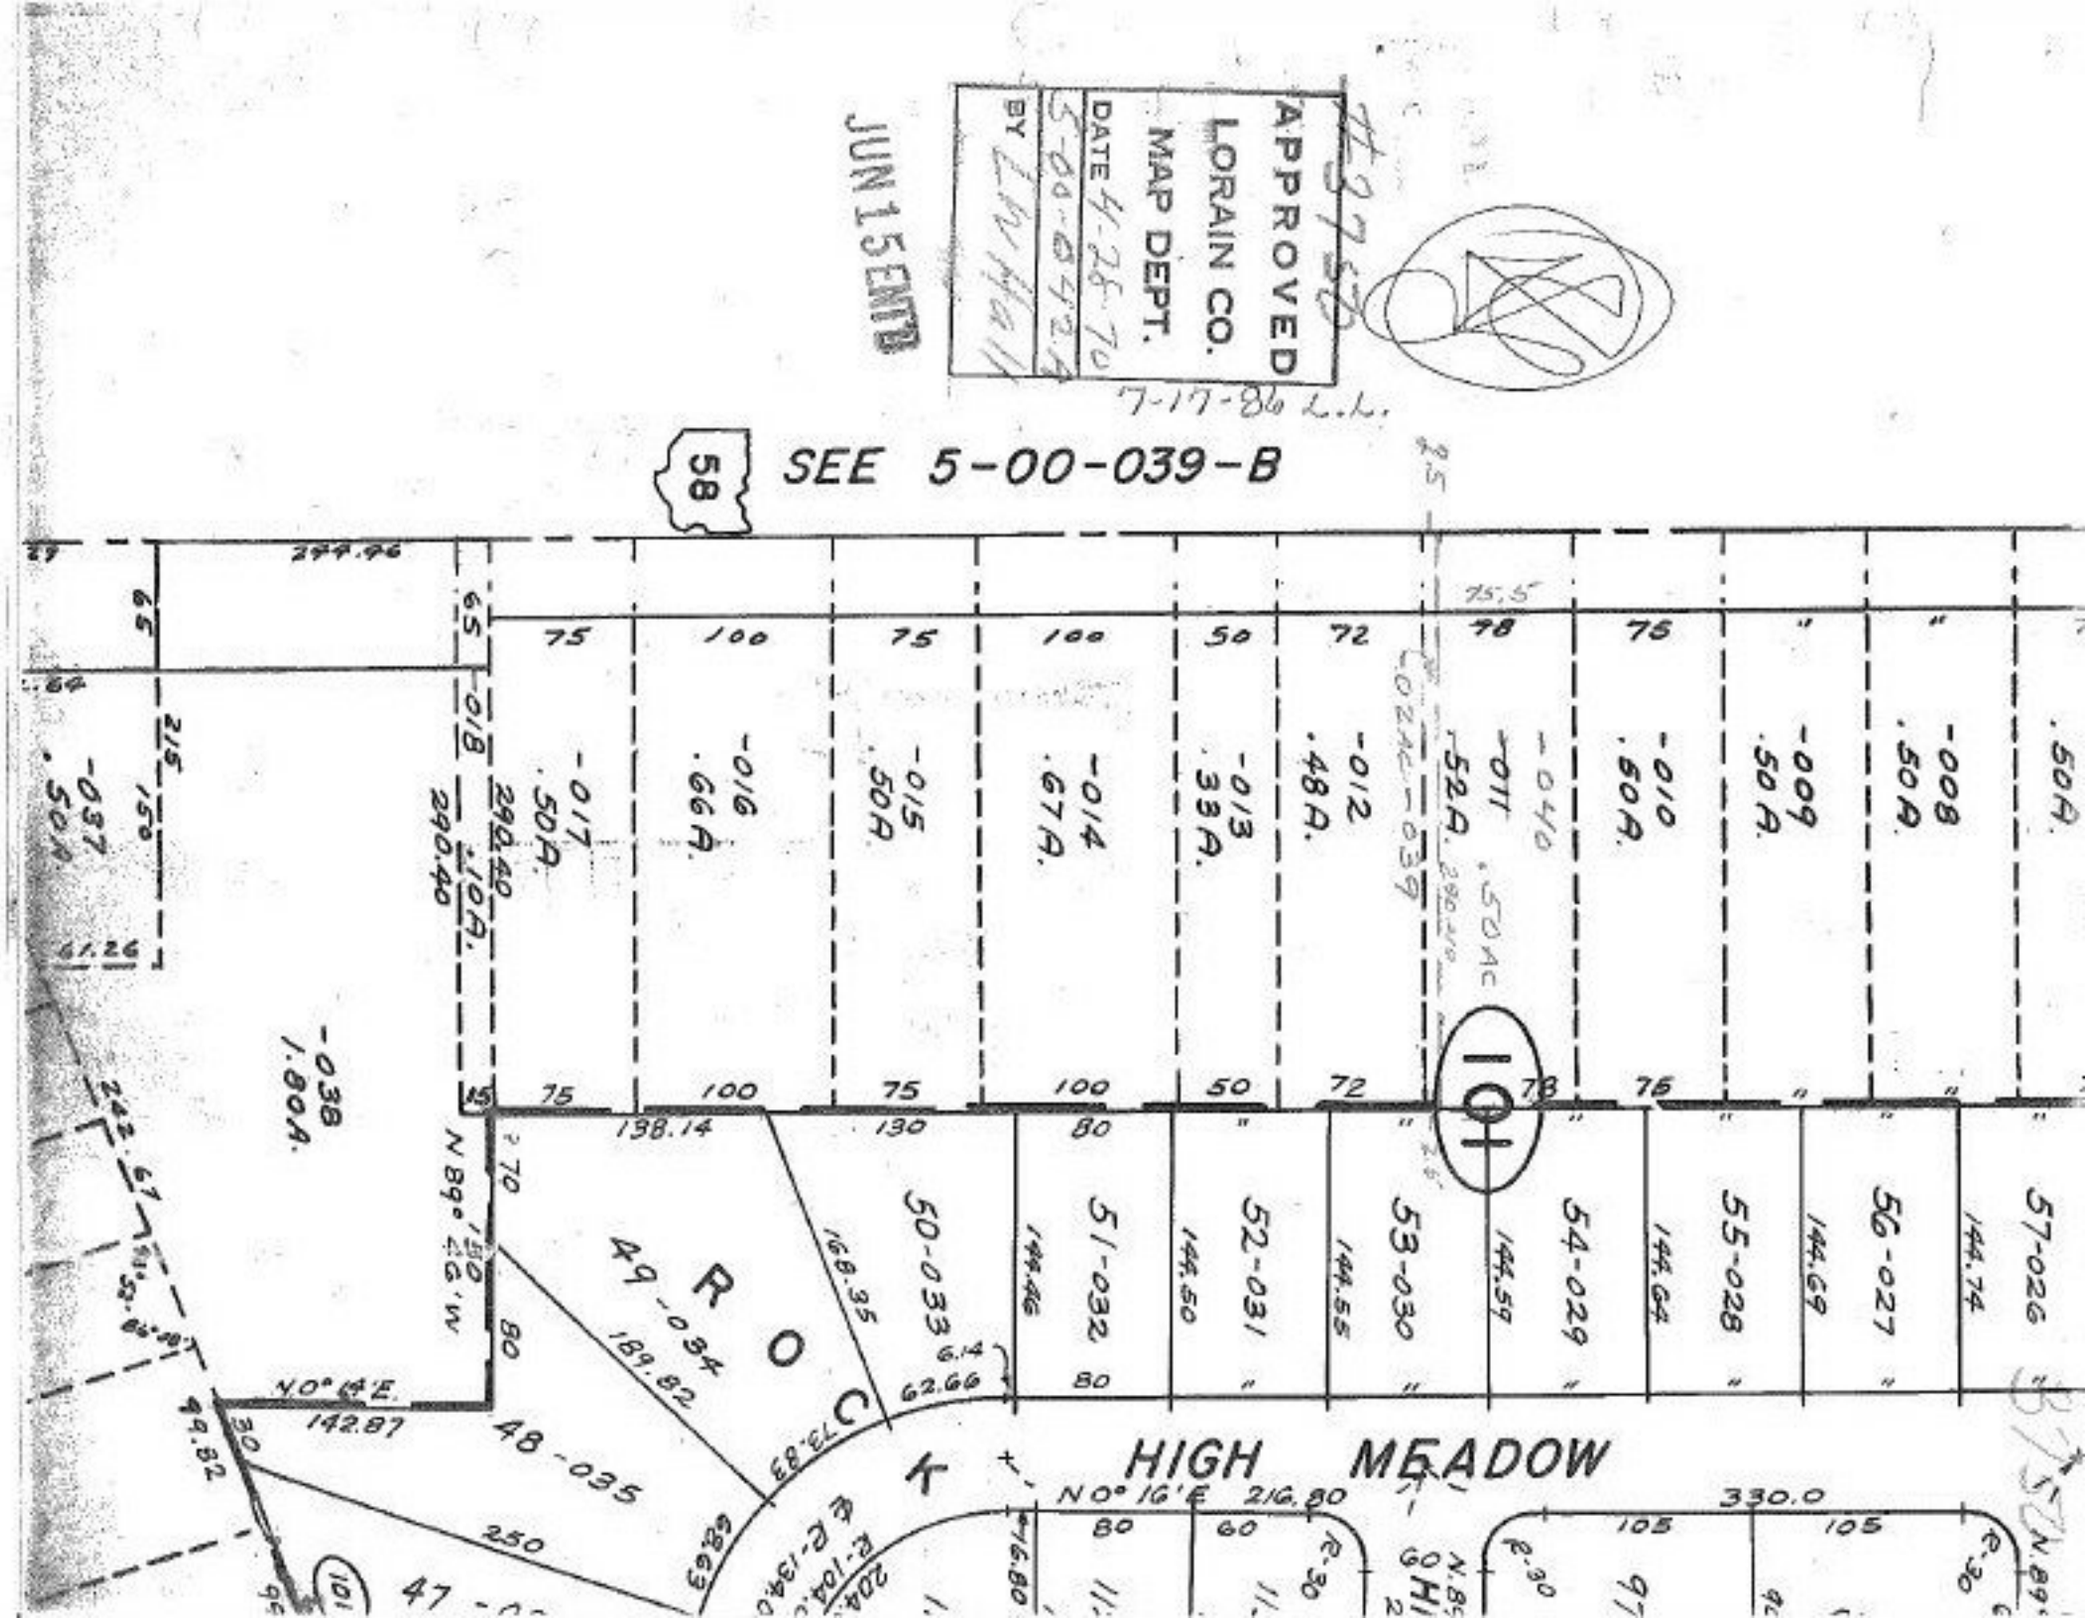
APPROVED
LORAIN CO.
MAP DEPT.
DATE 4-28-70
5-00-042A
BY
JUN 15 ENTD
7-17-86 L.L.
58
SEE 5-00-039-B
-017 .50A.
-016 .66A.
-015 .50A.
-014 .67A.
-013 .33A.
-012 .48A.
-011 .52A.
-010 .50A.
-009 .50A.
-008 .50A.
.50A.
-037 .50A.
-038 1.80A.
-040 .50AC
101
ROCK
HIGH MEADOW
49-034
48-035
50-033
51-032
52-031
53-030
54-029
55-028
56-027
57-026
N 89° 46' W
N 0° 14' E
N 0° 16' E 216.80
330.0
142.87
138.14
168.35
189.82
62.66
73.83
99.82
244.96
61.26
290.40
R-104.0
R-134.0
R-30