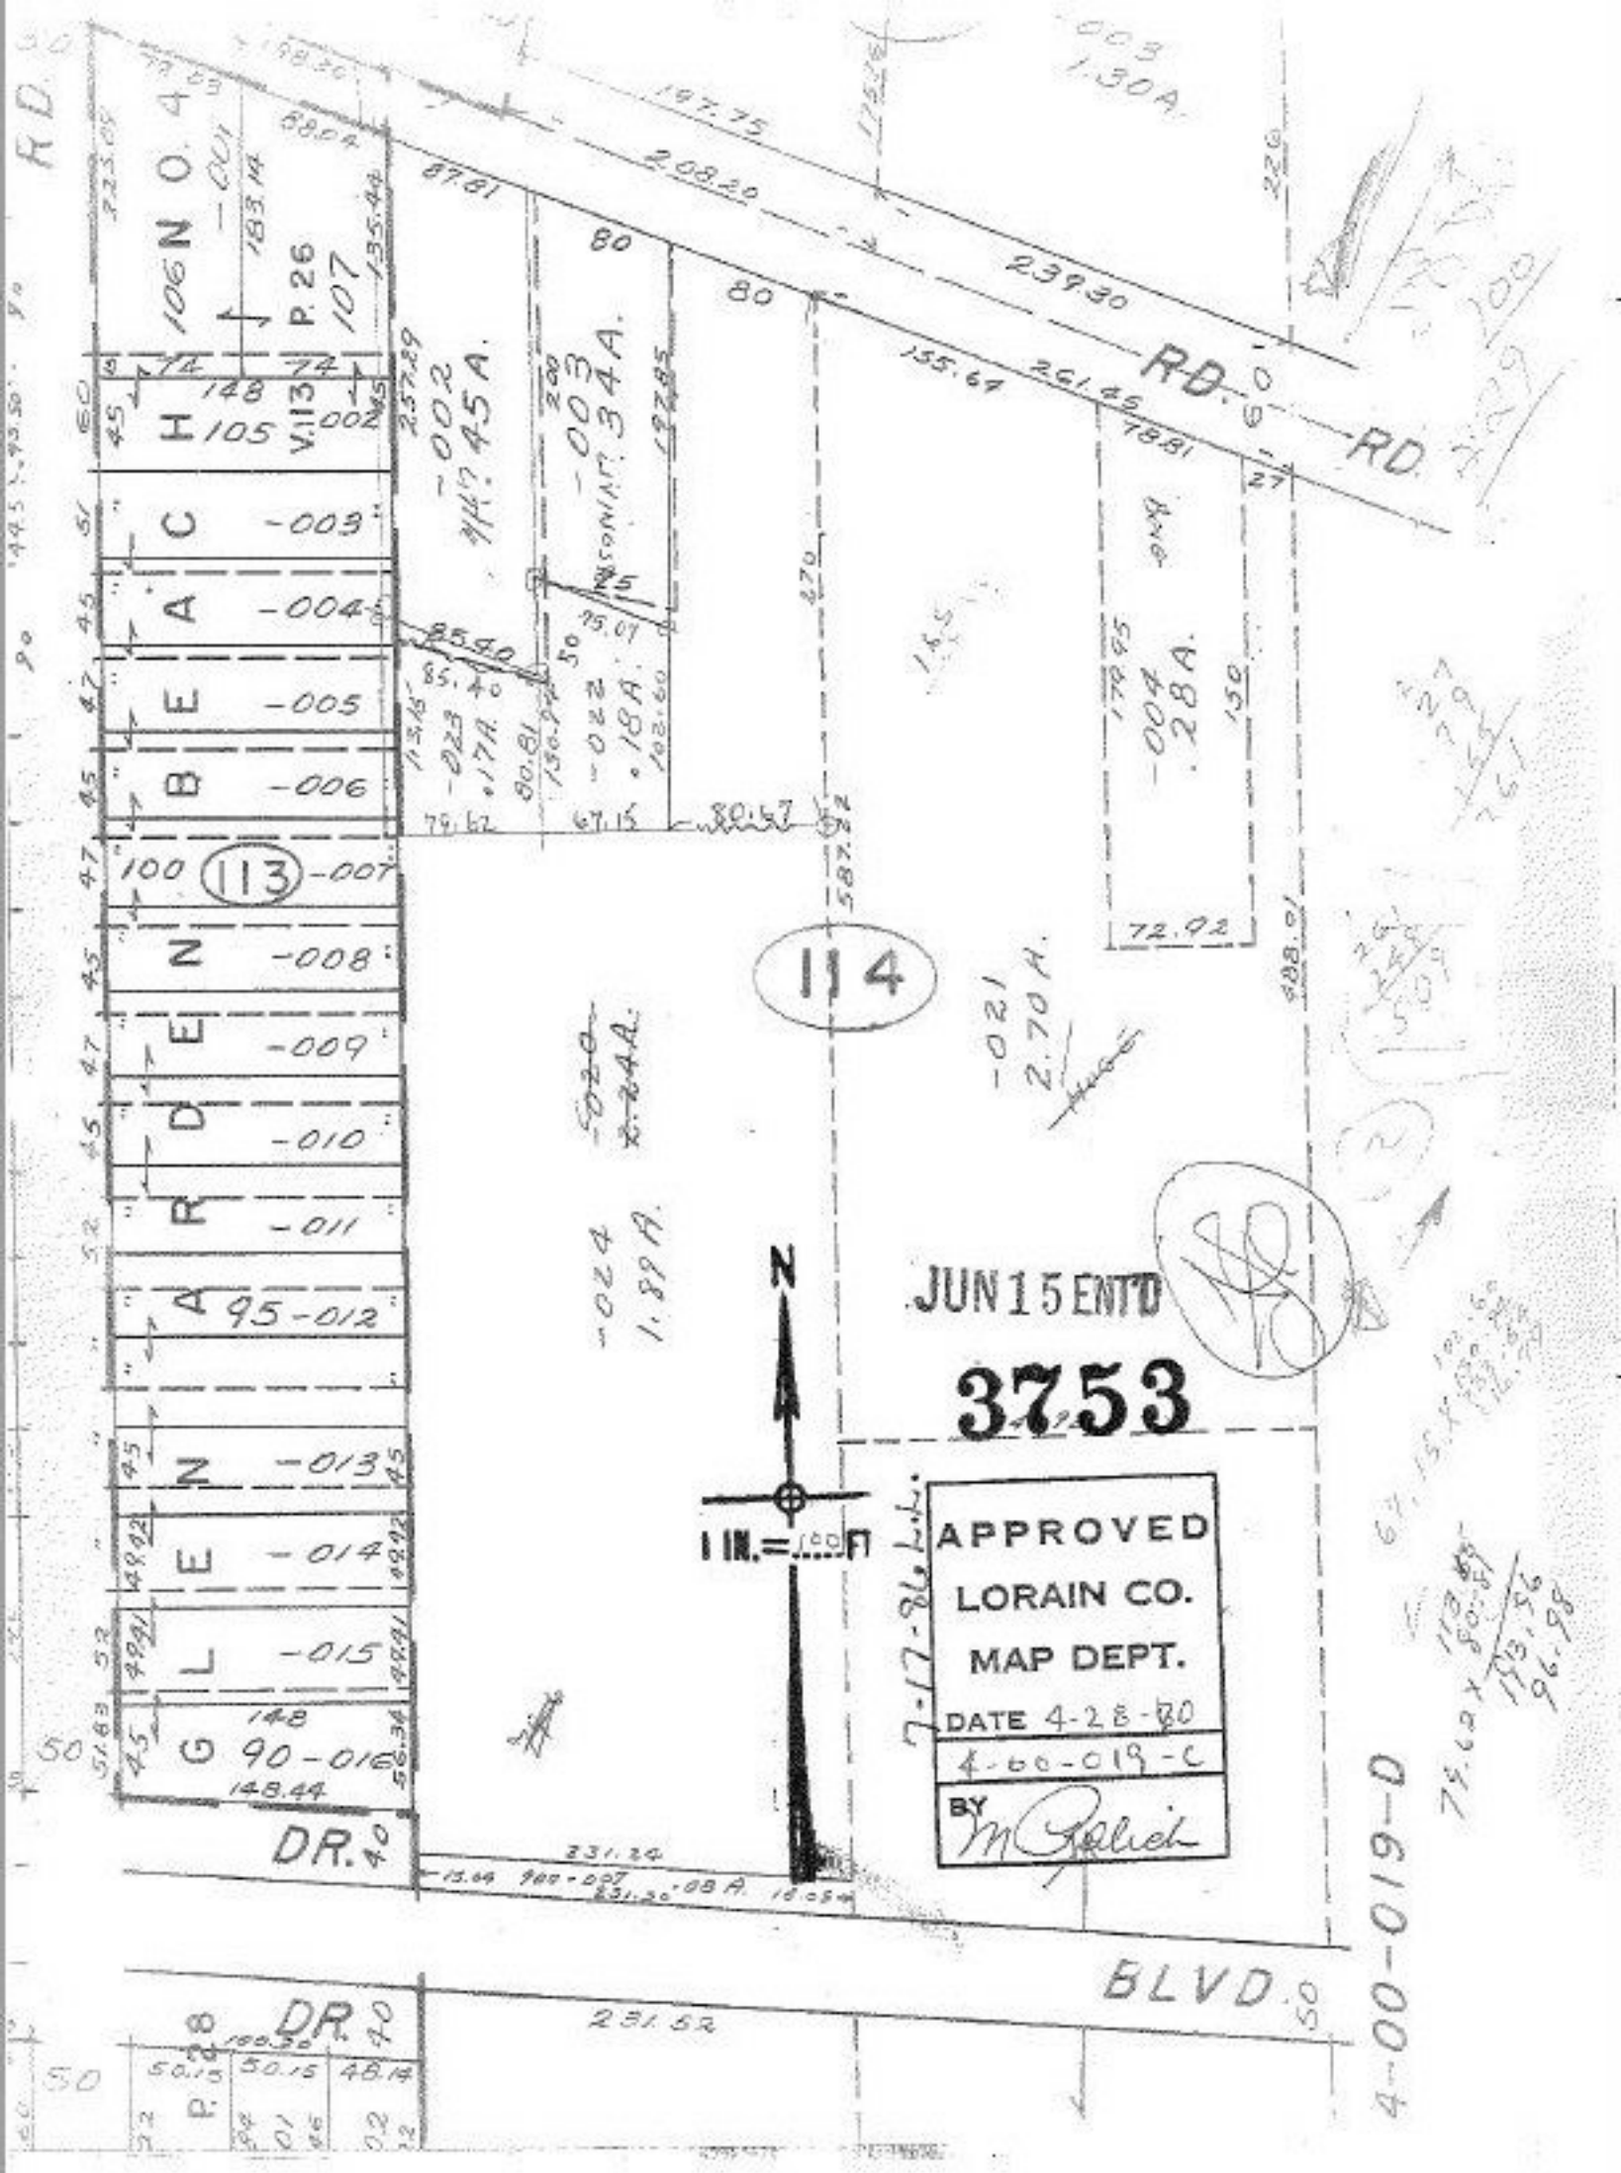

JUN 15 ENT'D
3753
APPROVED
LORAIN CO.
MAP DEPT.
DATE 4-28-80
4-00-019-C
BY
N
1 IN. = 100 FT
RD.
DR.
BLVD.
113
114
4-00-019-D