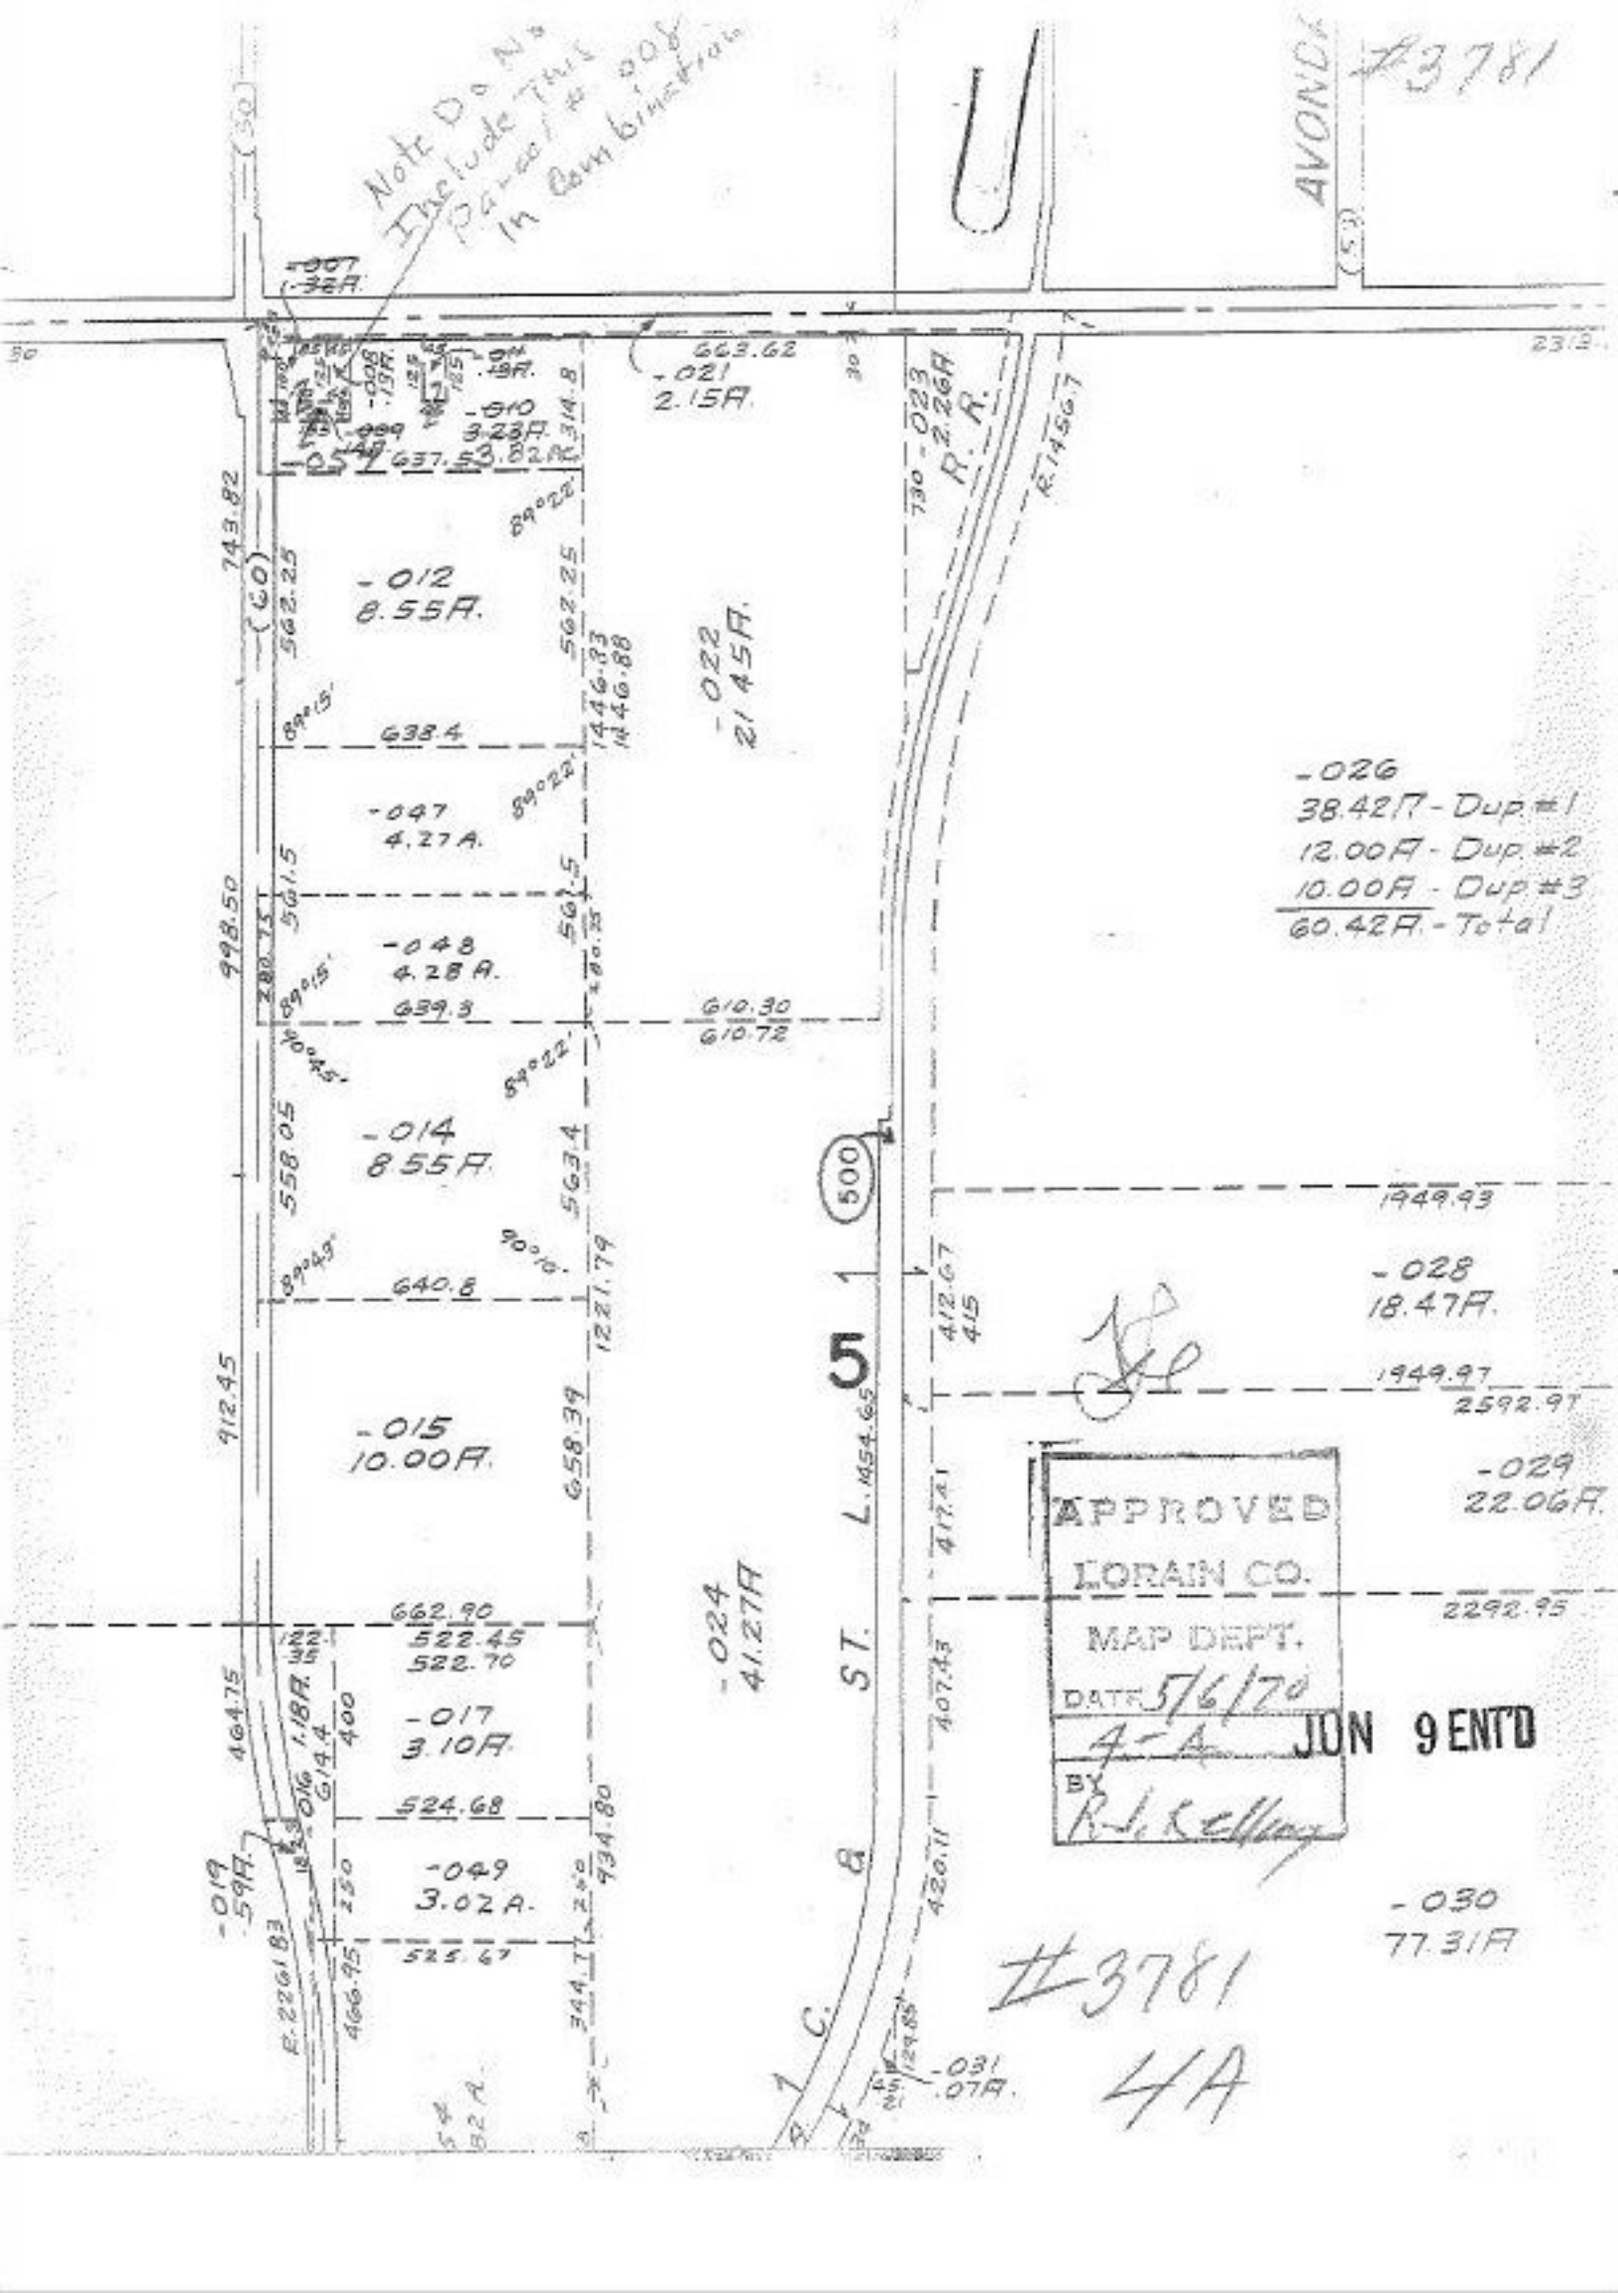
#3781
AVONDALE
-007 1.32A.
-008 .19A.
-009 .19A.
-010 3.23A.
-011 3.82A.
-012 8.55A.
-021 2.15A.
-022 21.45A.
-023 2.26A R.R.
-024 41.27A
-026 38.42A - Dup #1
12.00A - Dup #2
10.00A - Dup #3
60.42A - Total
-028 18.47A.
-029 22.06A.
-030 77.31A
-031 .07A.
-047 4.27A.
-048 4.28A.
-014 8.55A.
-015 10.00A.
-017 3.10A.
-049 3.02A.
-019 .59A.
1.18A.
5.82A.
L.1454.65
L.1457
S.R. 1 & S.R. 58
APPROVED
LORAIN CO.
MAP DEPT.
DATE 5/6/70
4-A
BY R. L. Kelley
JON 9 ENT'D
#3781
4A