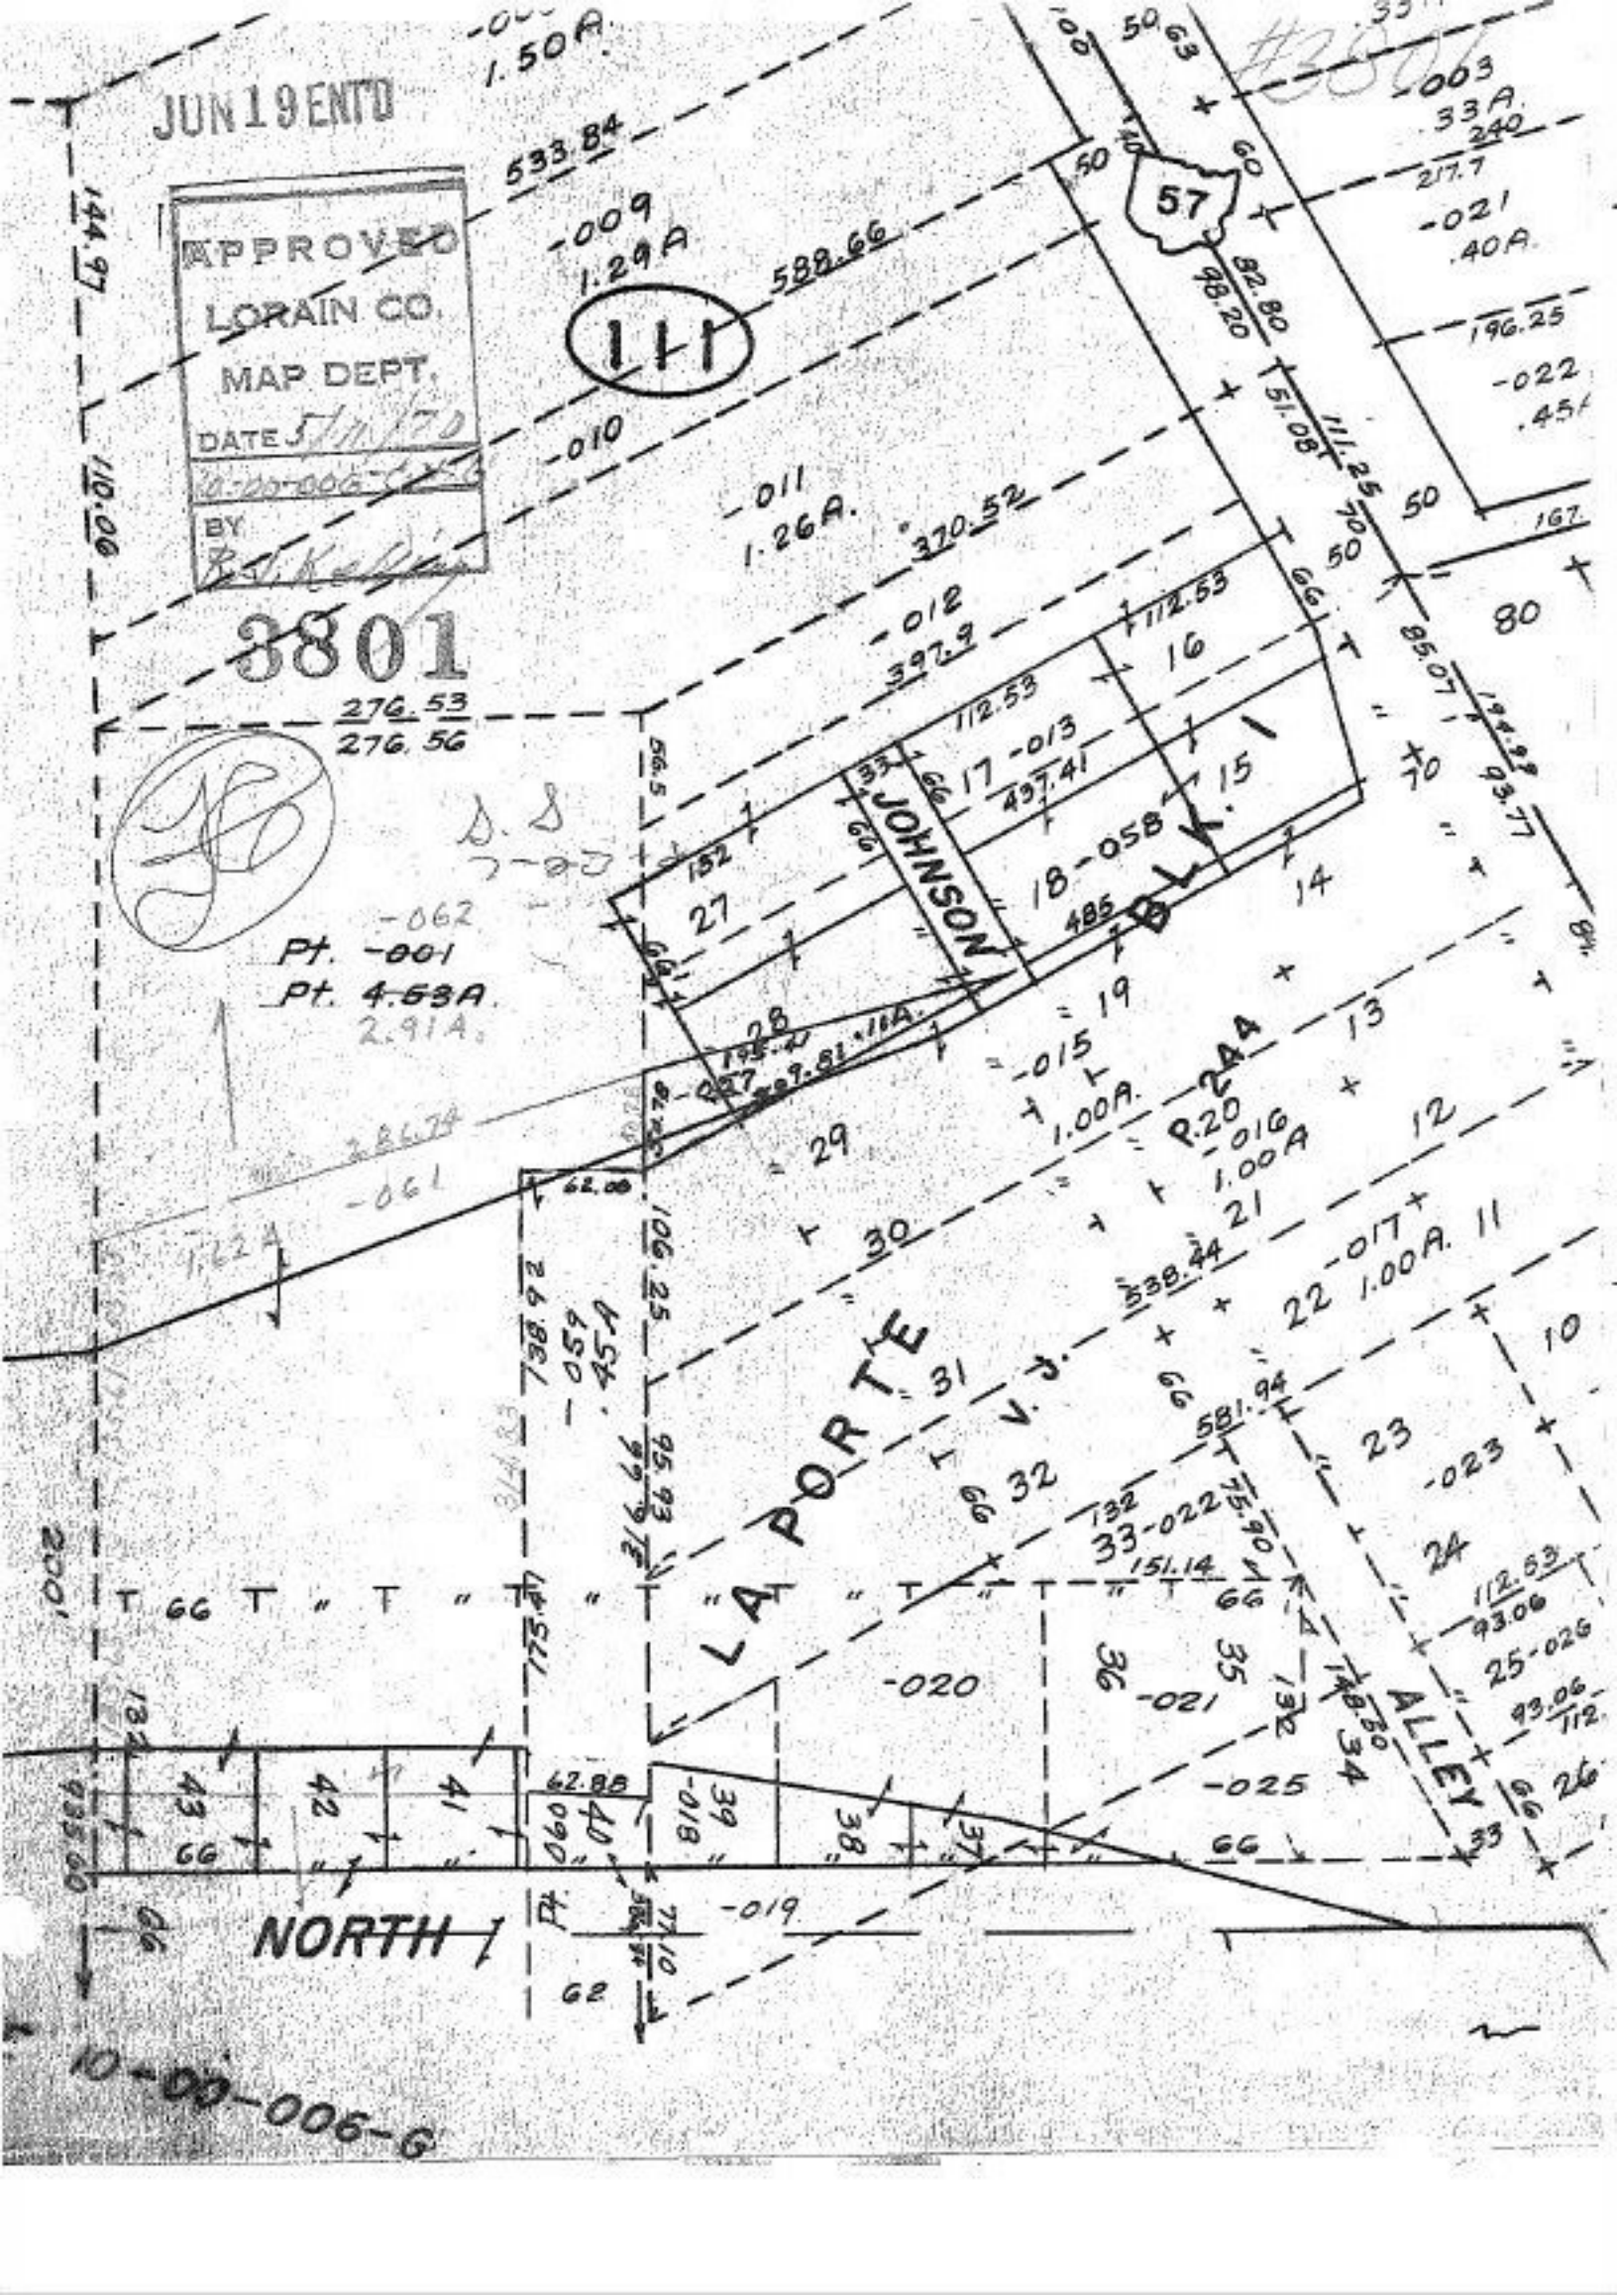
JUN 19 ENT'D
APPROVED
LORAIN CO.
MAP DEPT.
DATE 5/11/70
BY
3801
111
57
JOHNSON
LA PORTE
ALLEY
NORTH
10-00-006-G