See 3707

JUL 24 ENTD

APPROVED
LORAIN CO.
MAP DEPT.
DATE 5/12/70
02-02-025-A
BY R.J. Kelly
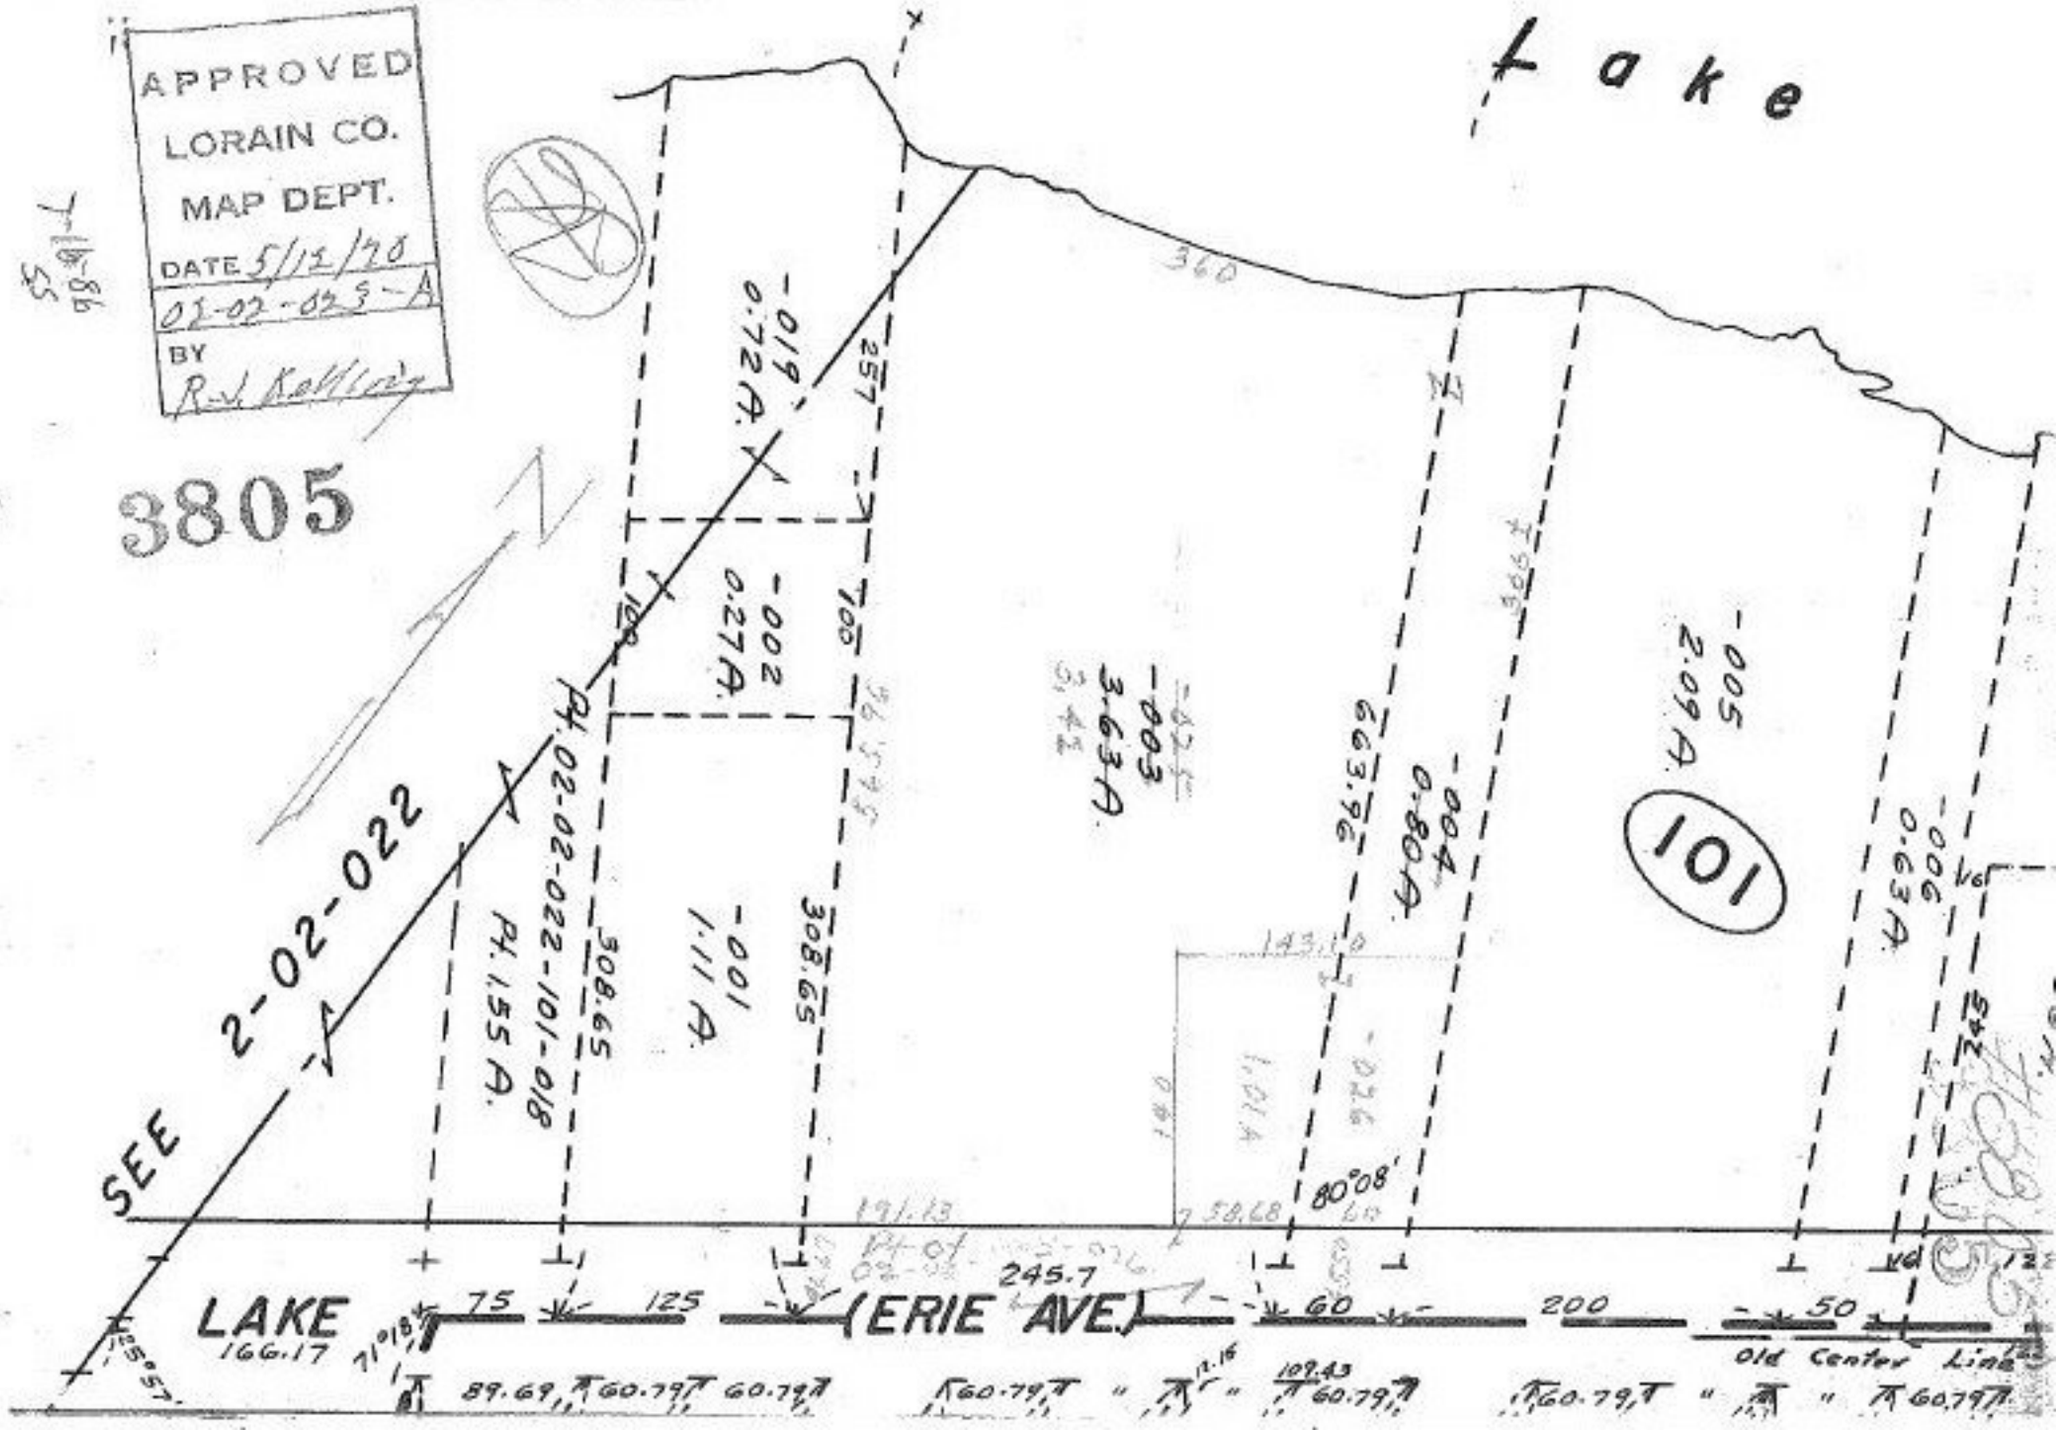
3805