#3808

3808
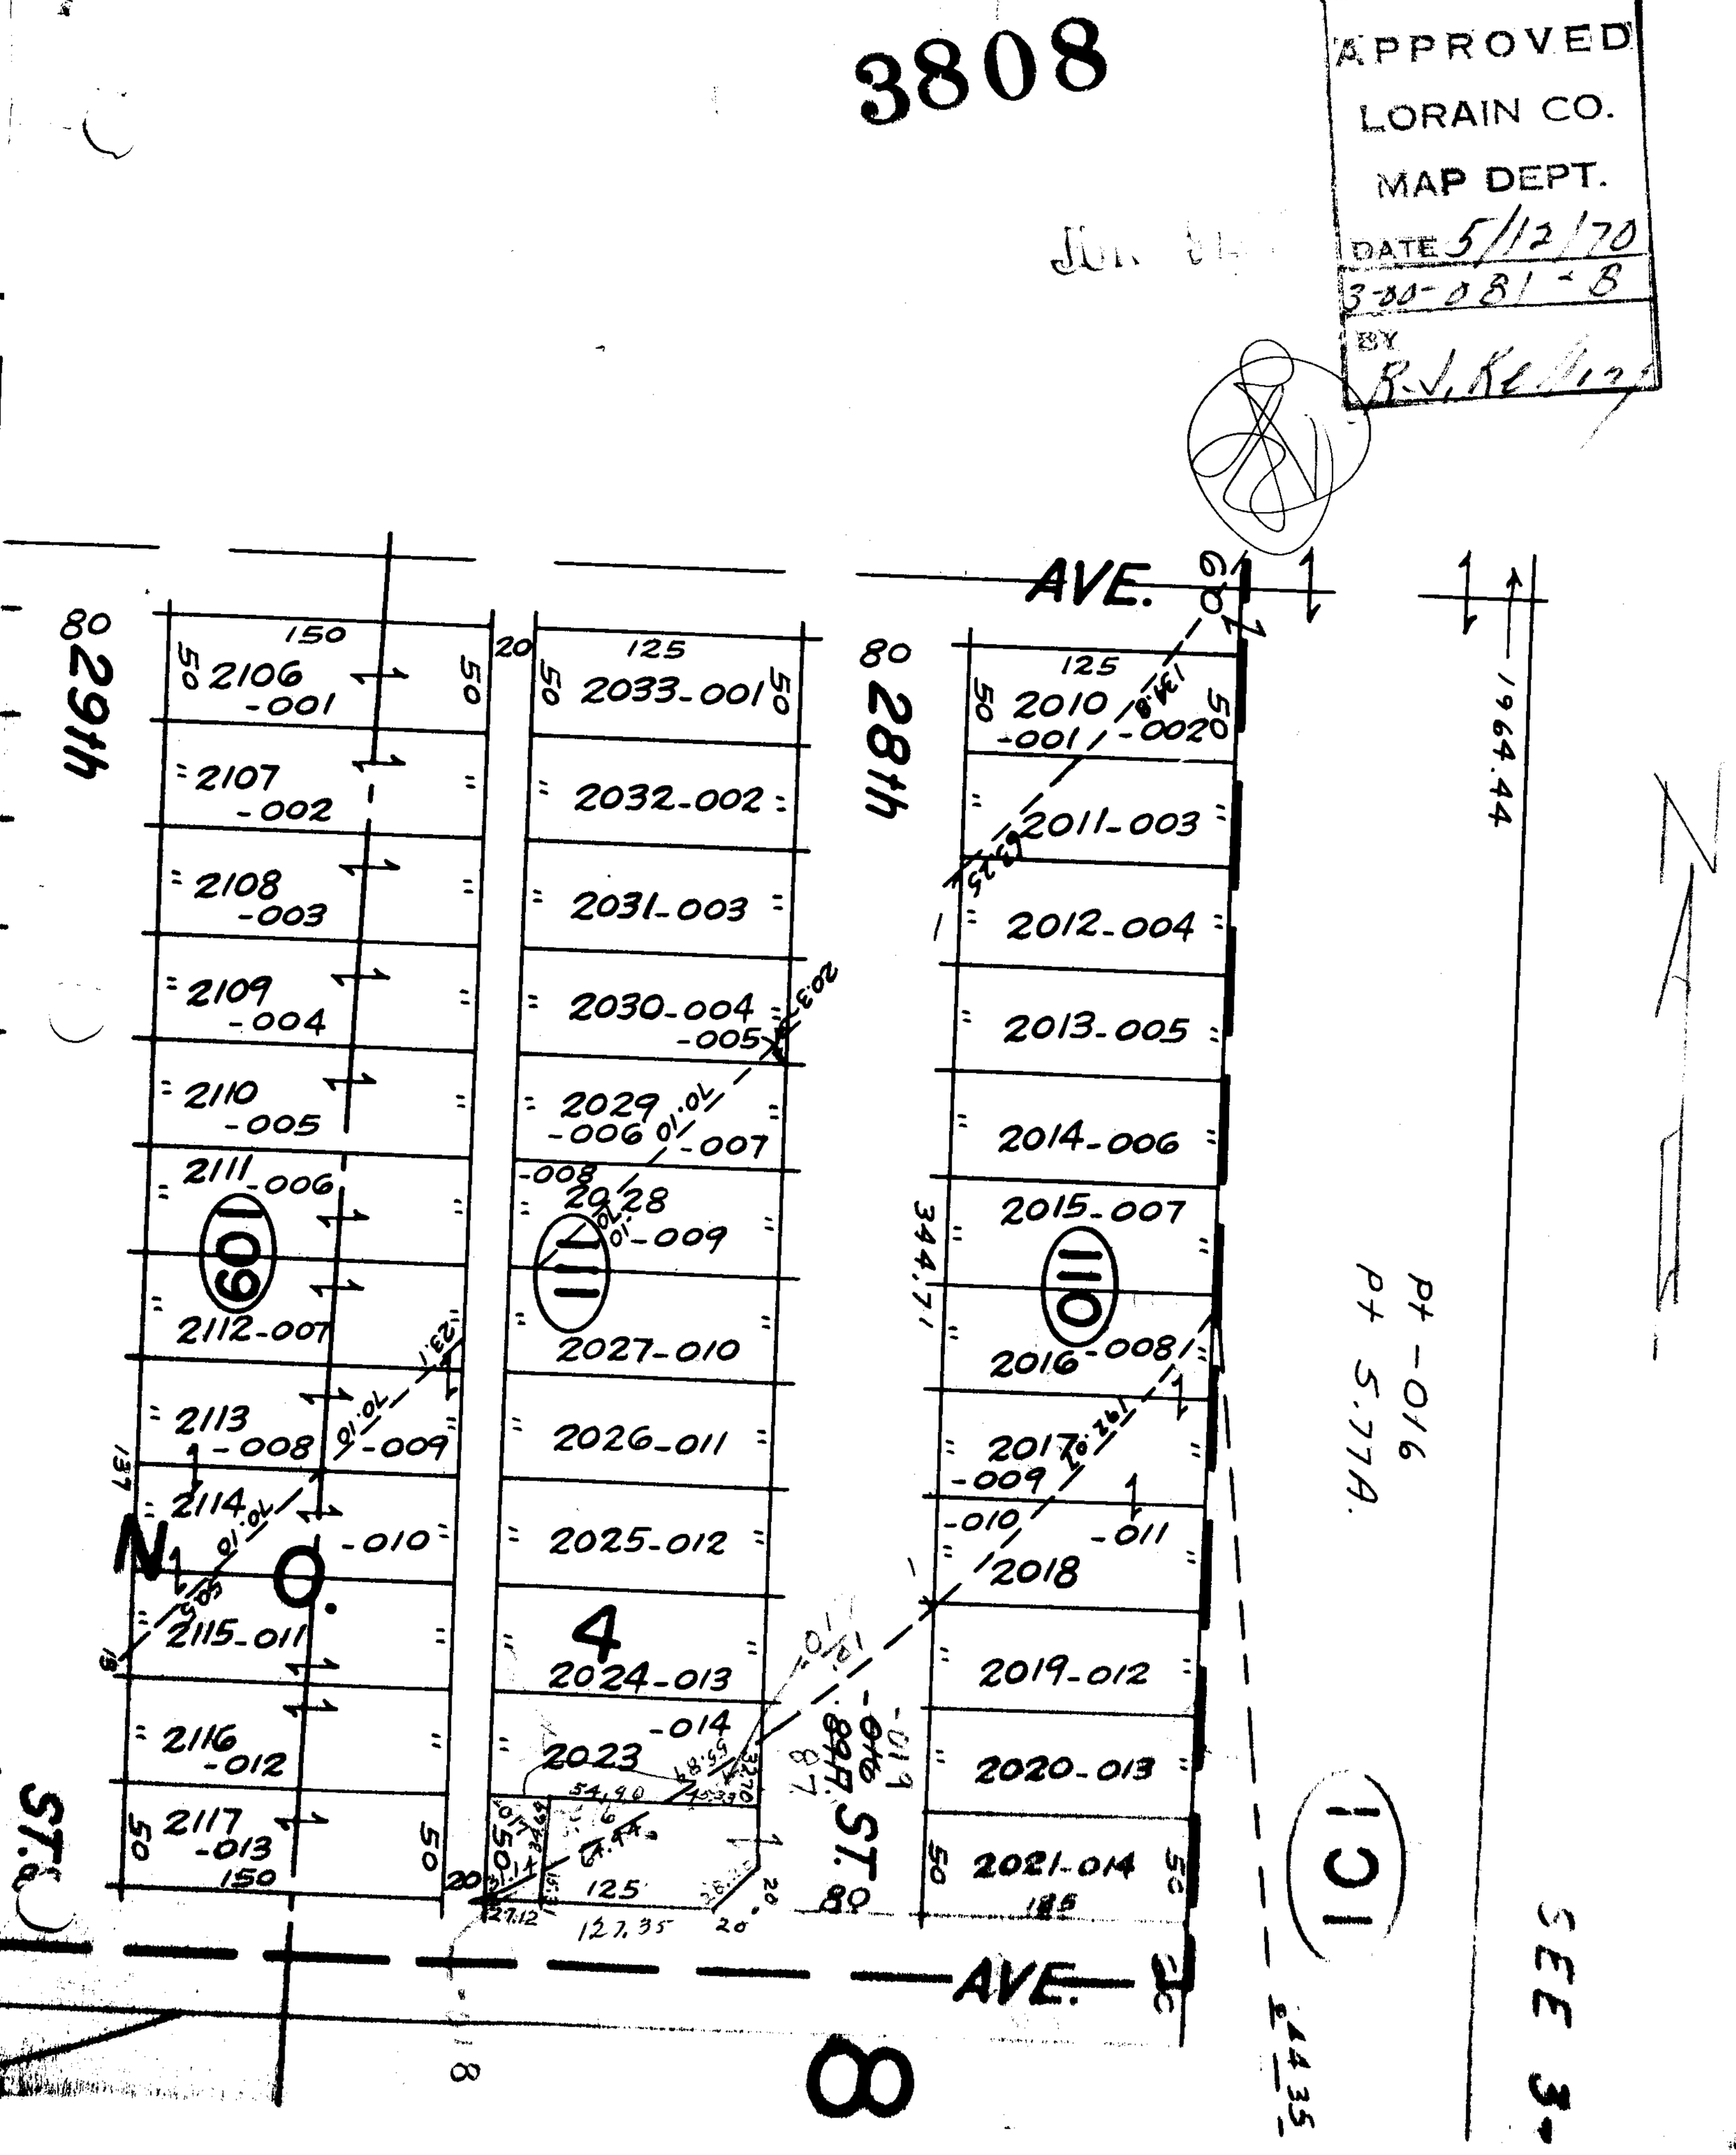
APPROVED
LORAIN CO.
MAP DEPT.
DATE 5/12/70
3-20-081-8
BY R.V.K.