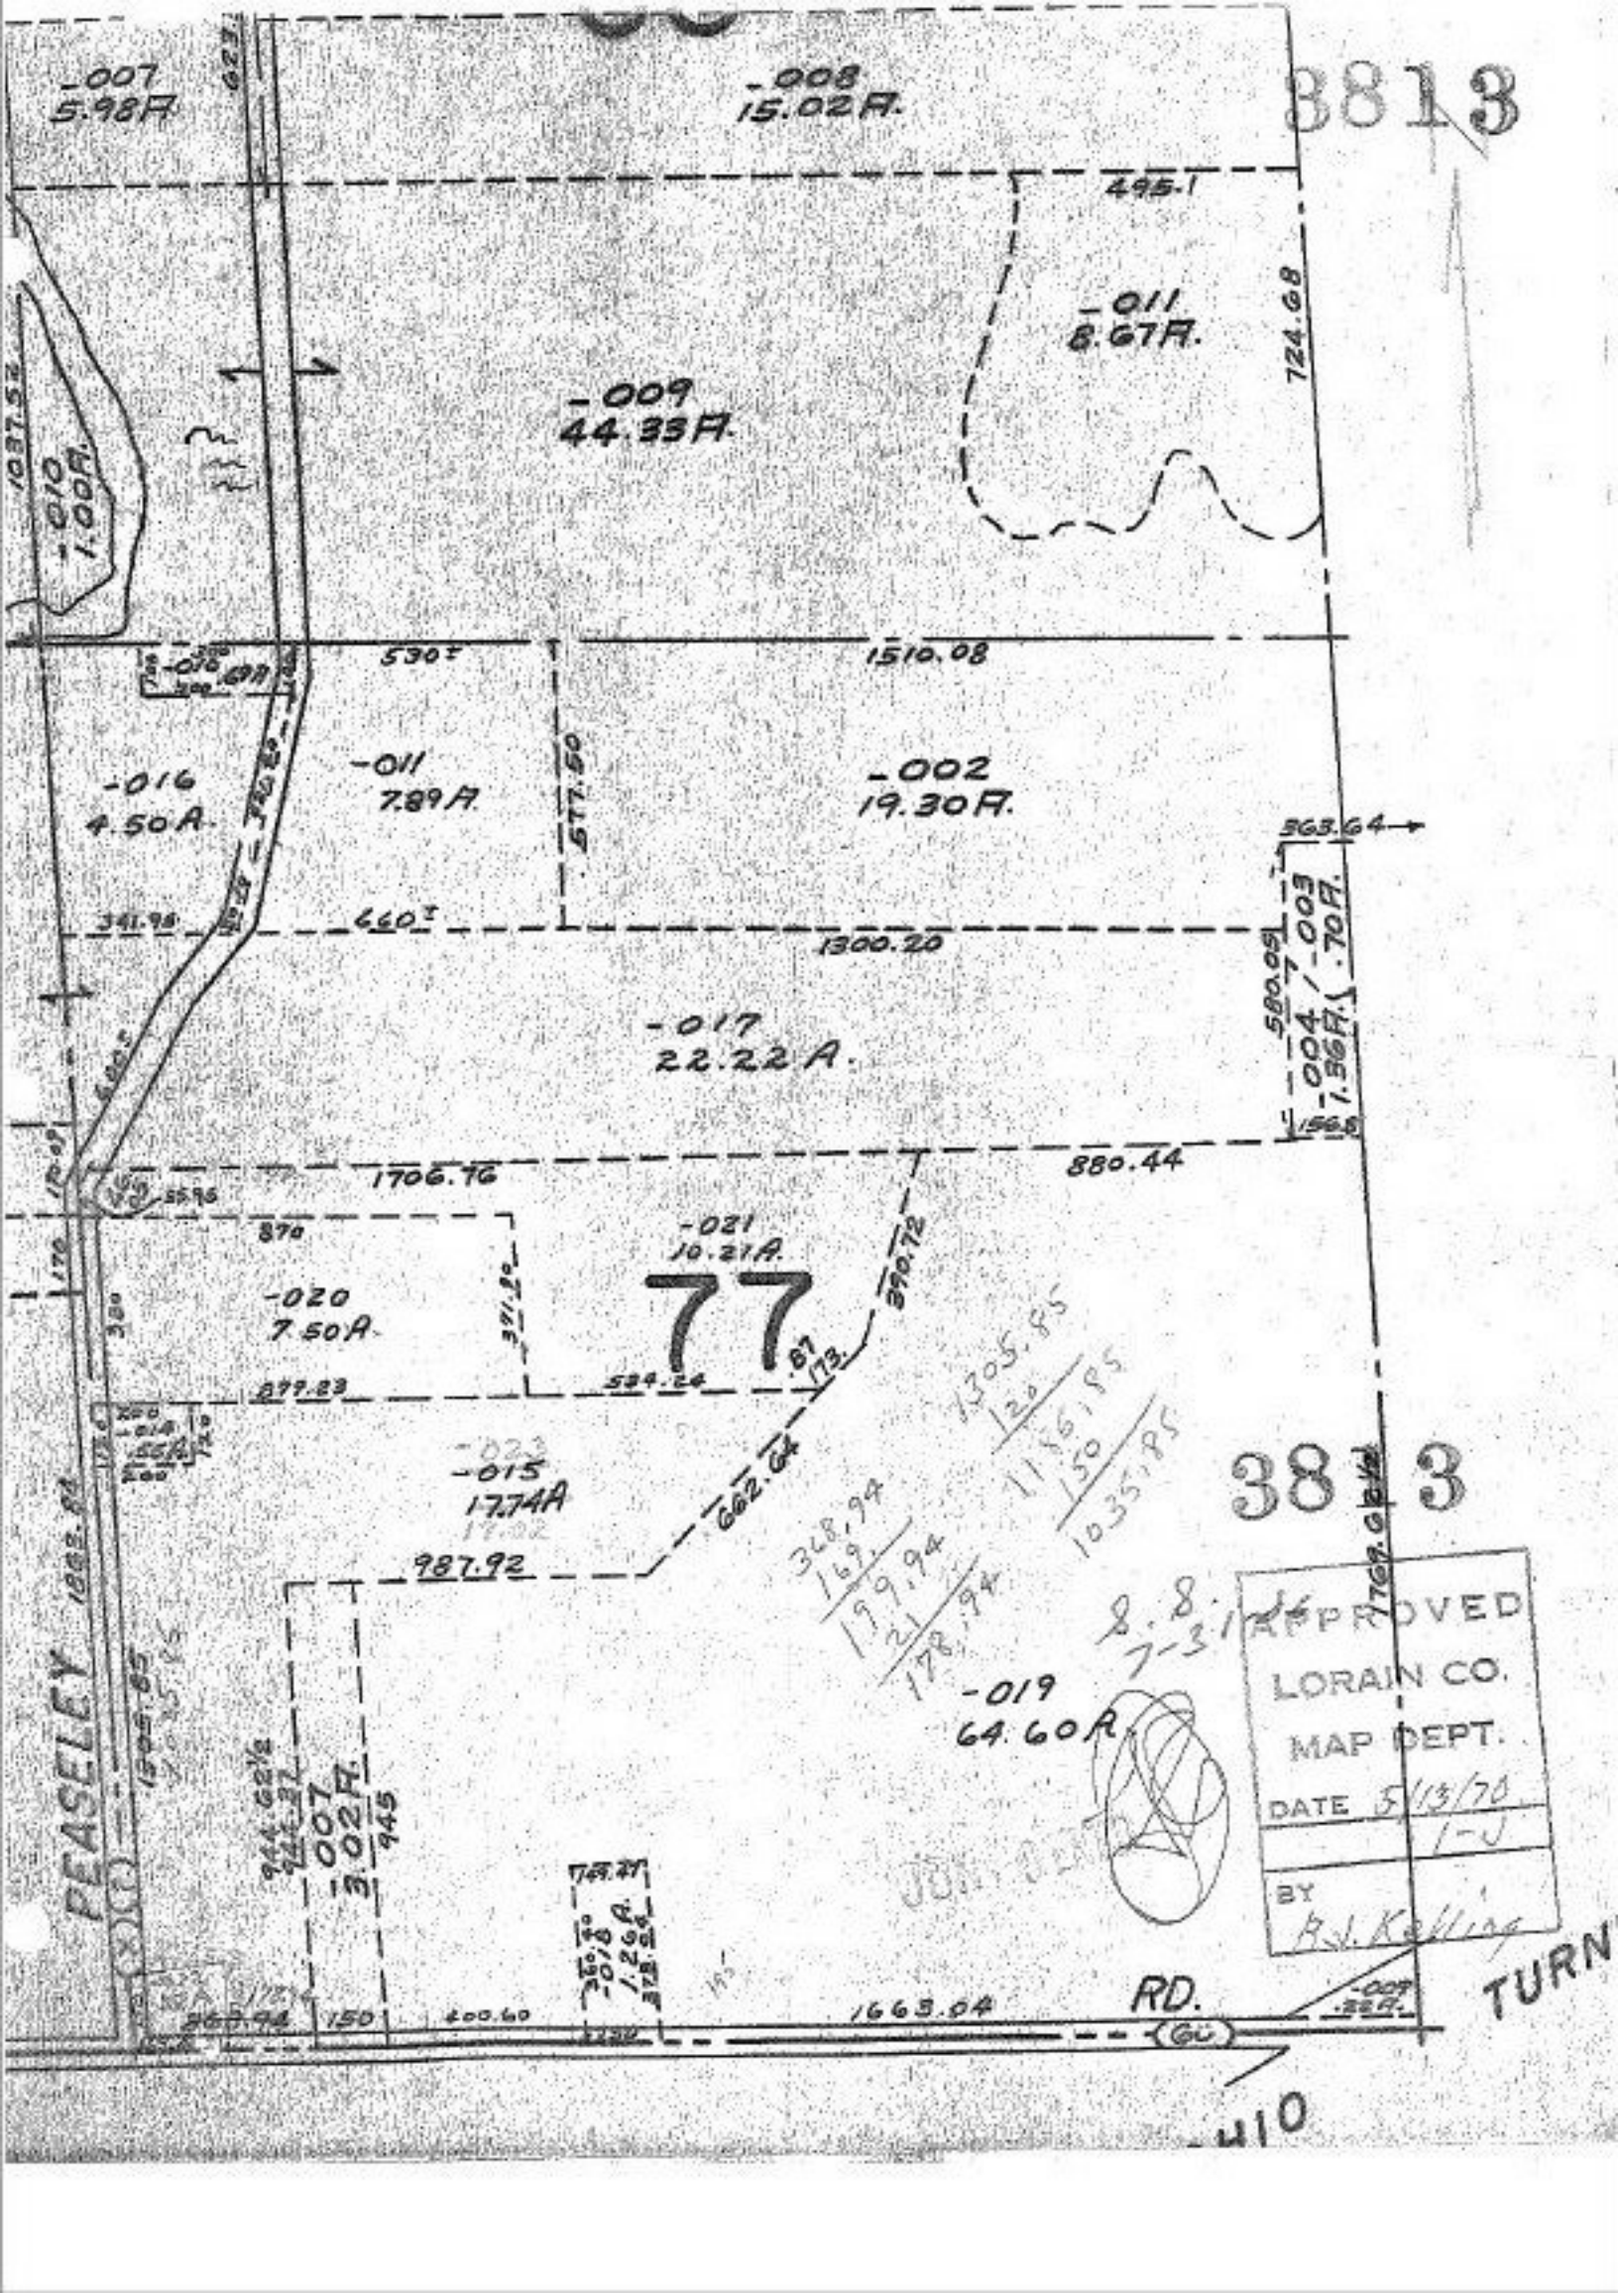
3813
-007
5.98A.
-008
15.02A.
495.1
-011
8.67A.
724.68
-009
44.33A.
-010
1.00A.
1087.52
530'
1510.08
-016
4.50A.
-011
7.89A.
577.50
-002
19.30A.
363.64
341.98
660'
1300.20
580.05'
-004
1.56A.
-003
.70A.
-017
22.22A.
1706.76
880.44
870
-021
10.21A.
77
890.72
-020
7.50A.
371.10
379.23
524.64
87
73
-023
-015
17.74A
662.64
1305.85
20
1156.85
30
1035.85
3883
348.94
169.
199.94
21
178.94
987.92
-019
64.60A.
APPROVED
LORAIN CO.
MAP DEPT.
DATE 5/13/70
1-J
BY
PEASELEY
1882.84
1305.85
944.62½
944.37
-007
3.02A.
945
-018
1.26A.
378.54
1663.04
RD.
TURN
150
400.60
410