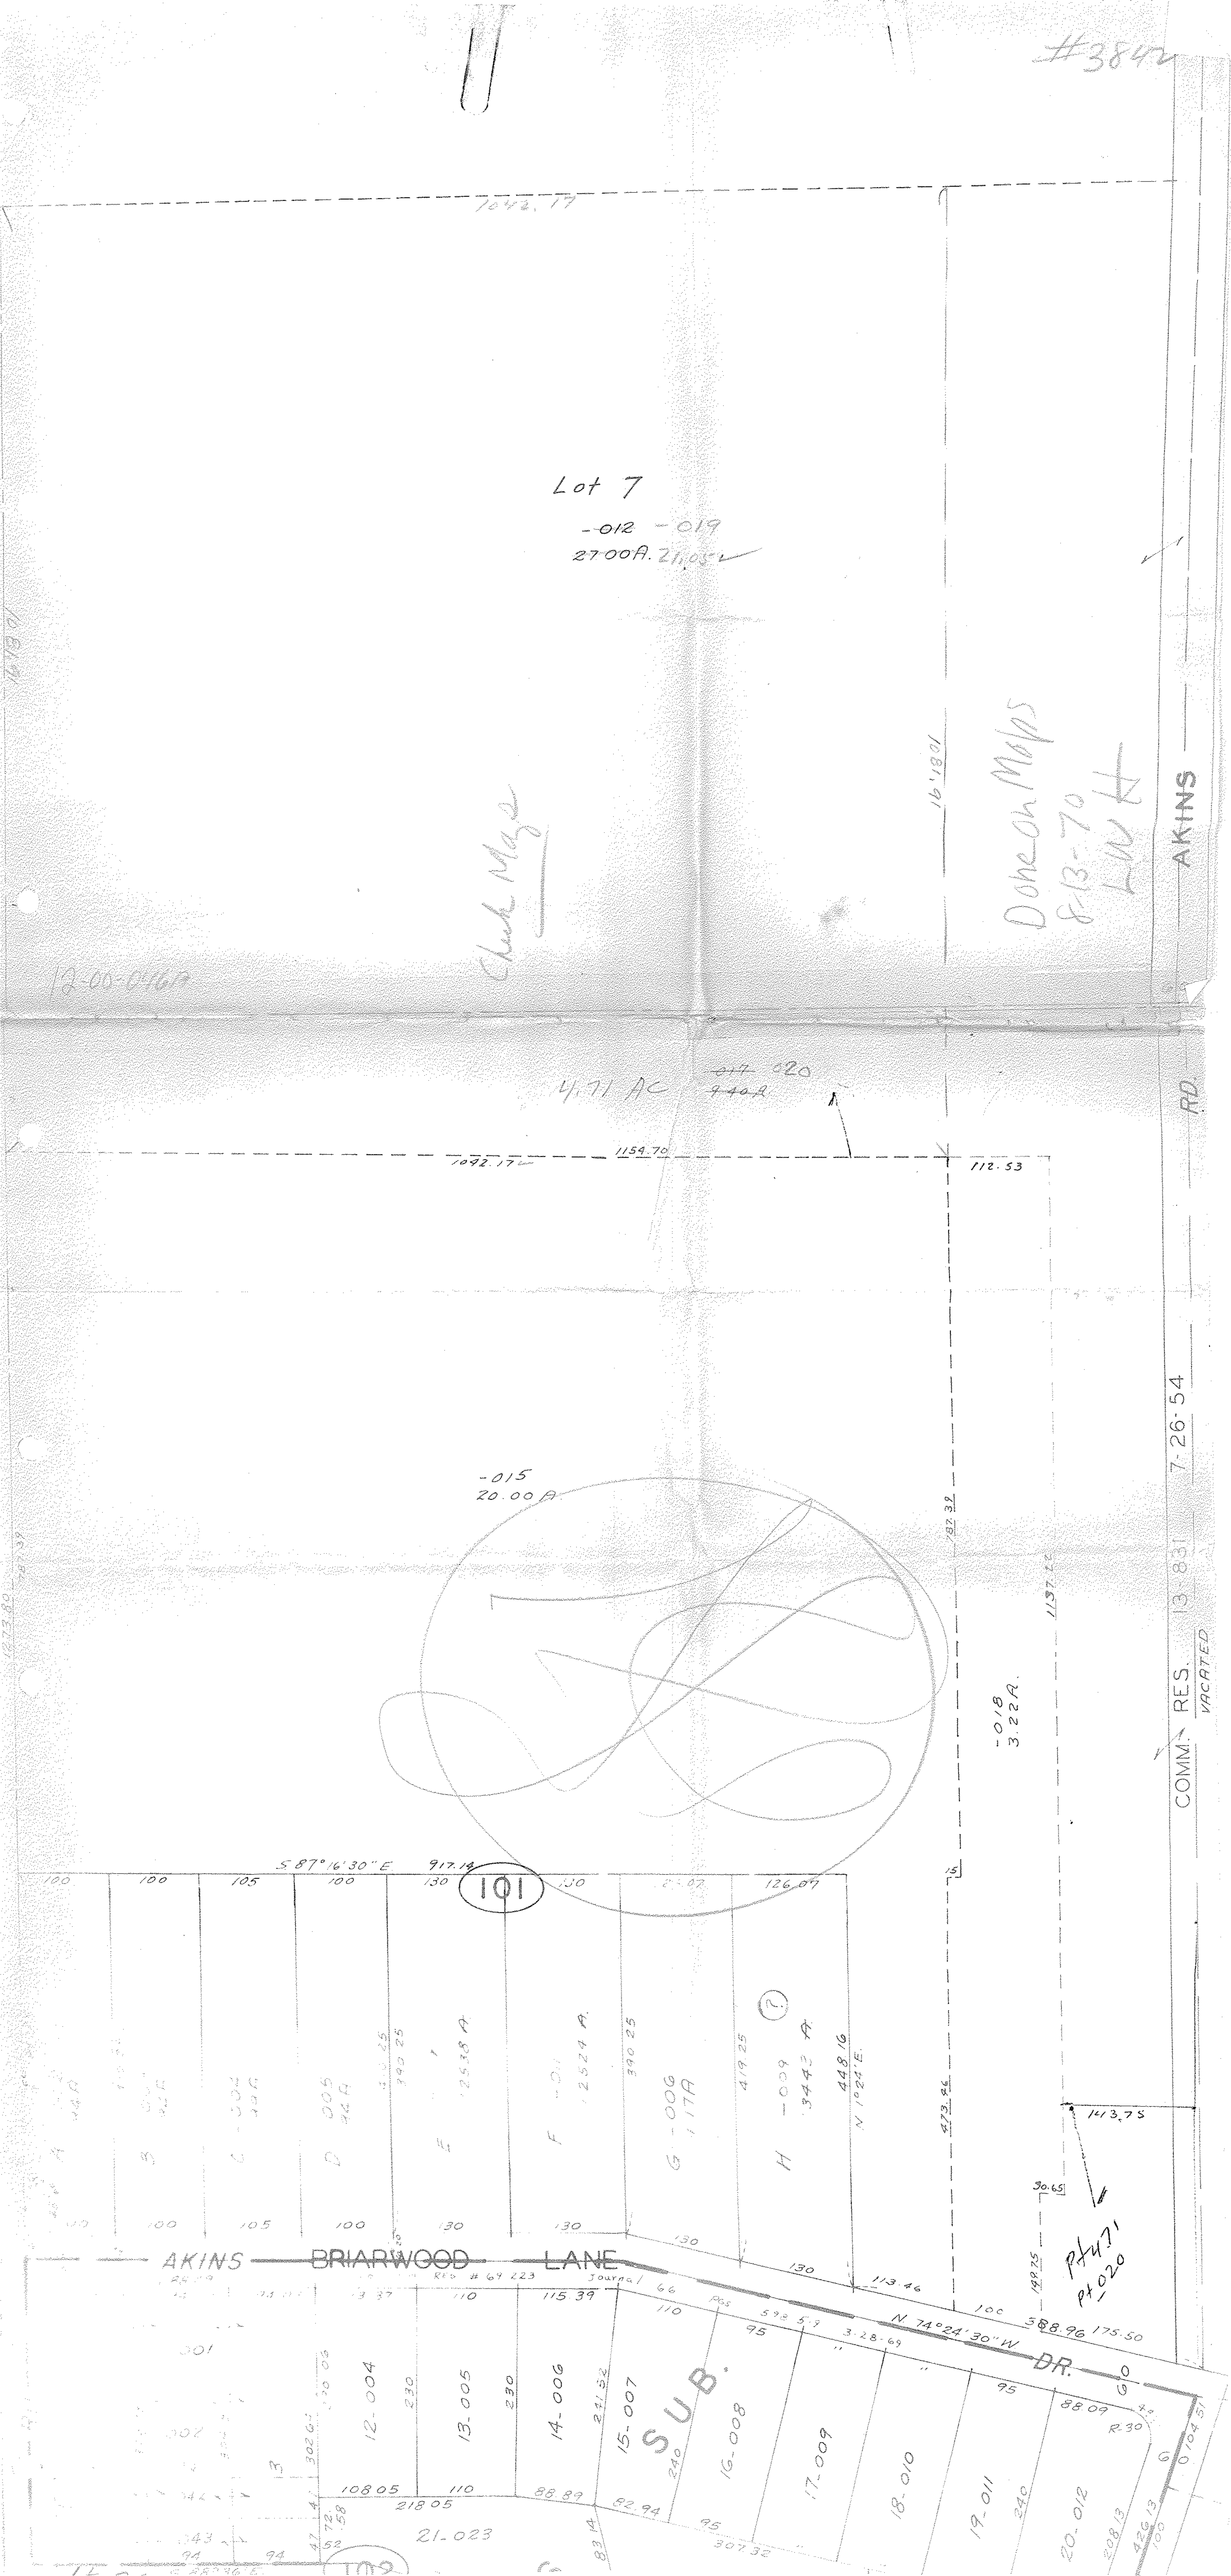
#3842
Lot 7
-012 -019
27.00A. 21.05
Check Maze
Done on Maps
8-13-70
12-00-046A
4.71 AC
-017 020
9.40A
1042.17
1154.70
112.53
-015
20.00A
-018
3.22A
AKINS
RD.
COMM. RES. 13-831 7-26-54
VACATED
S 87°16'30" E
917.14
101
126.07
N 1°24' E
473.96
143.75
Pt 4.71
Pt 020
AKINS BRIARWOOD LANE
N 74°24'30" W
DR.
SUB.
12-004
13-005
14-006
15-007
16-008
17-009
18-010
19-011
20-012
21-023
108.05
218.05
88.89
82.94
307.32
88.09
175.50
113.46
115.39