3847

JUN 15 ENT'D
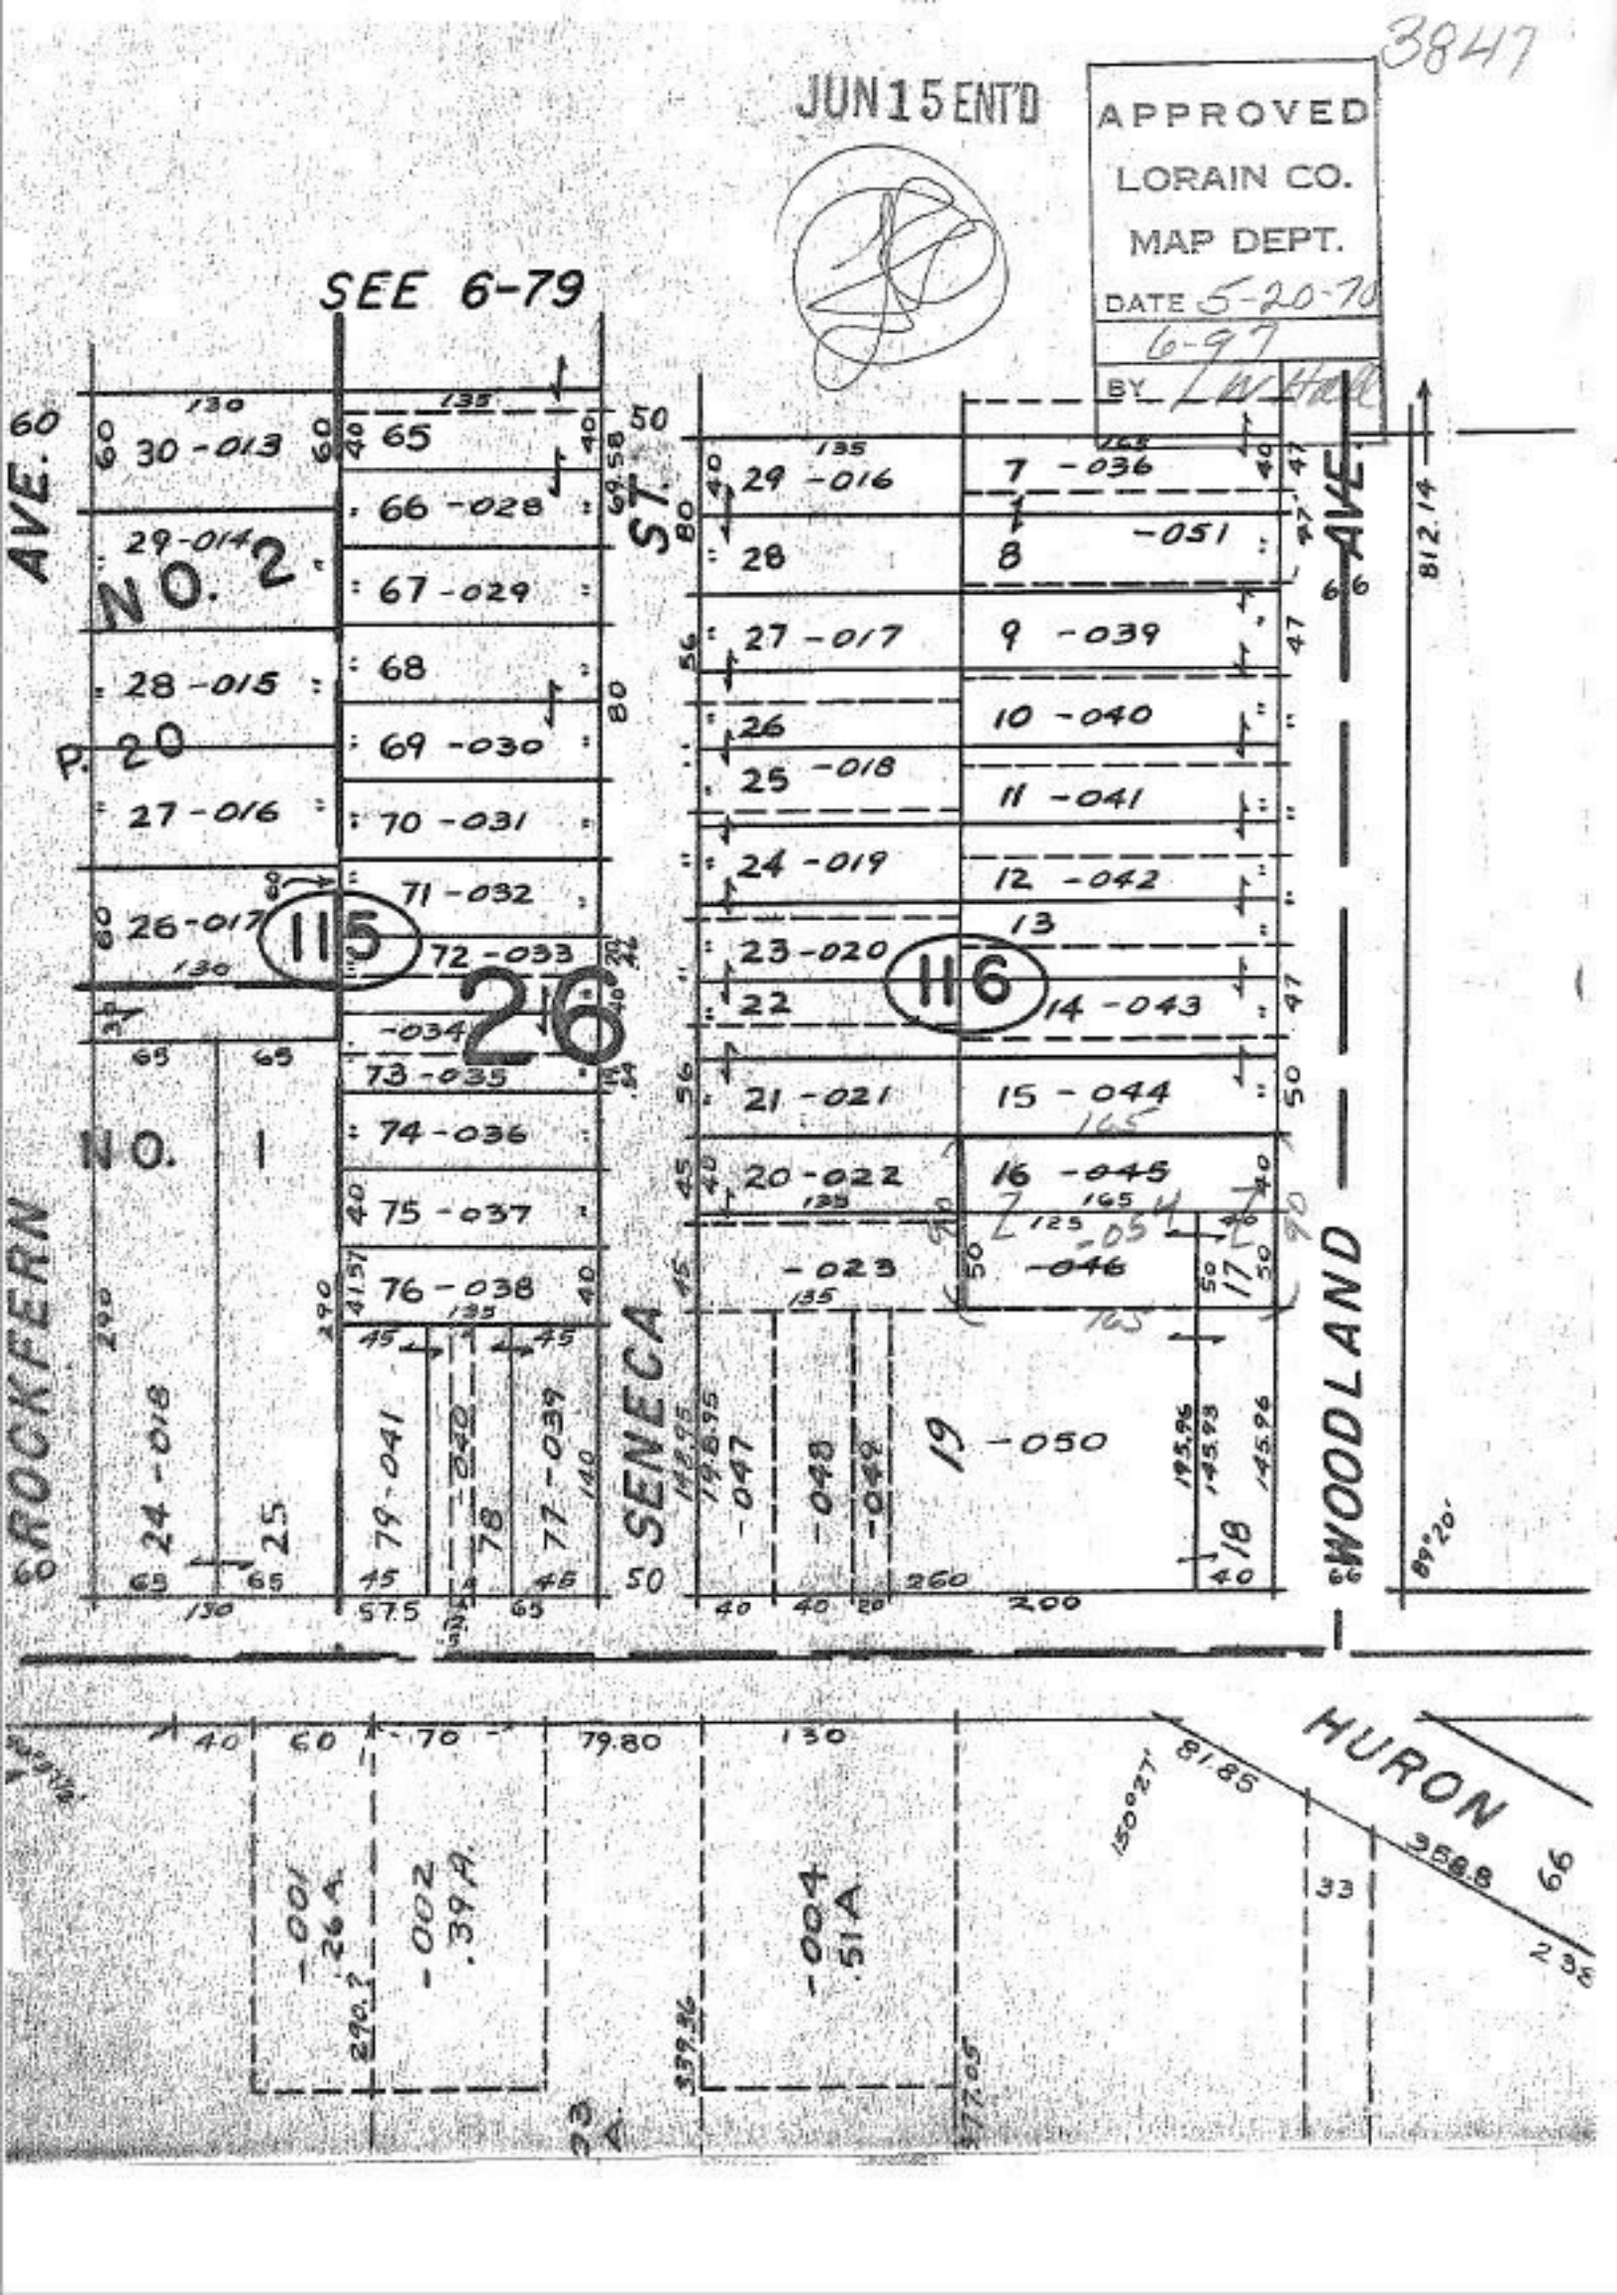
APPROVED
LORAIN CO.
MAP DEPT.
DATE 5-20-70
6-97
BY