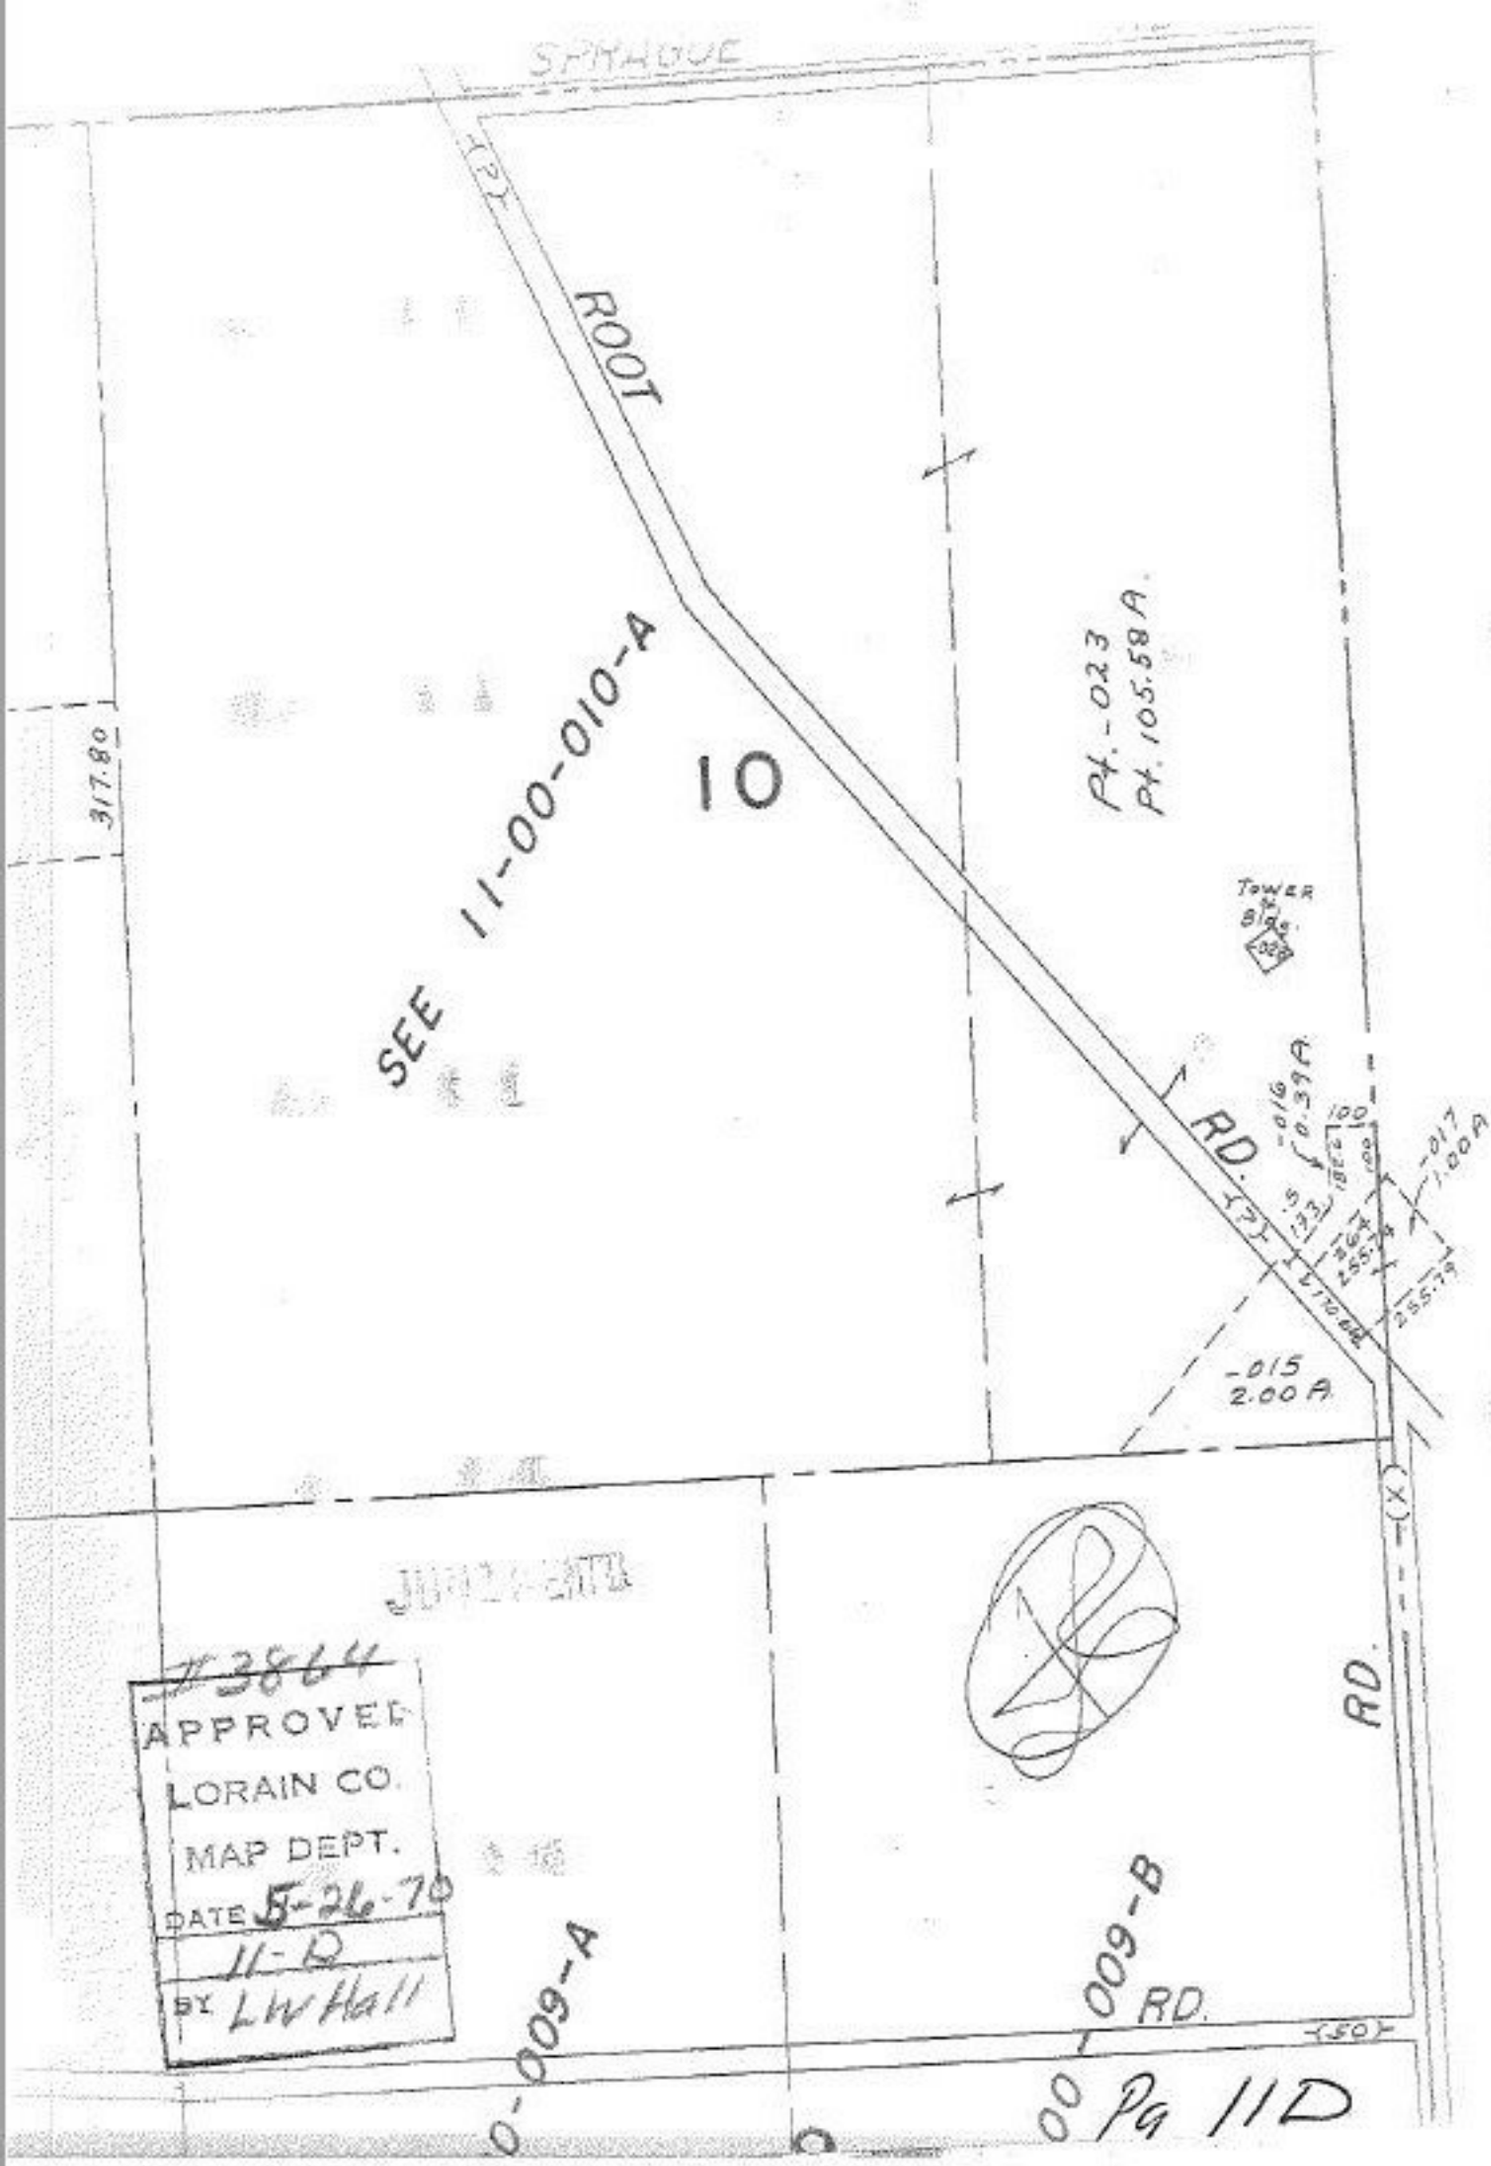
SPRAGUE
ROOT
RD.
SEE 11-00-010-A
10
Pt. 023
Pt. 105.58 A.
317.80
TOWER
Bldg.
-016
0.39 A
-017
1.00 A
-015
2.00 A
255.79
RD.
-009-A
-009-B
RD.
(50)
#3864
APPROVED
LORAIN CO.
MAP DEPT.
DATE 5-26-70
11-D
BY LW Hall
00 Pg 11D